
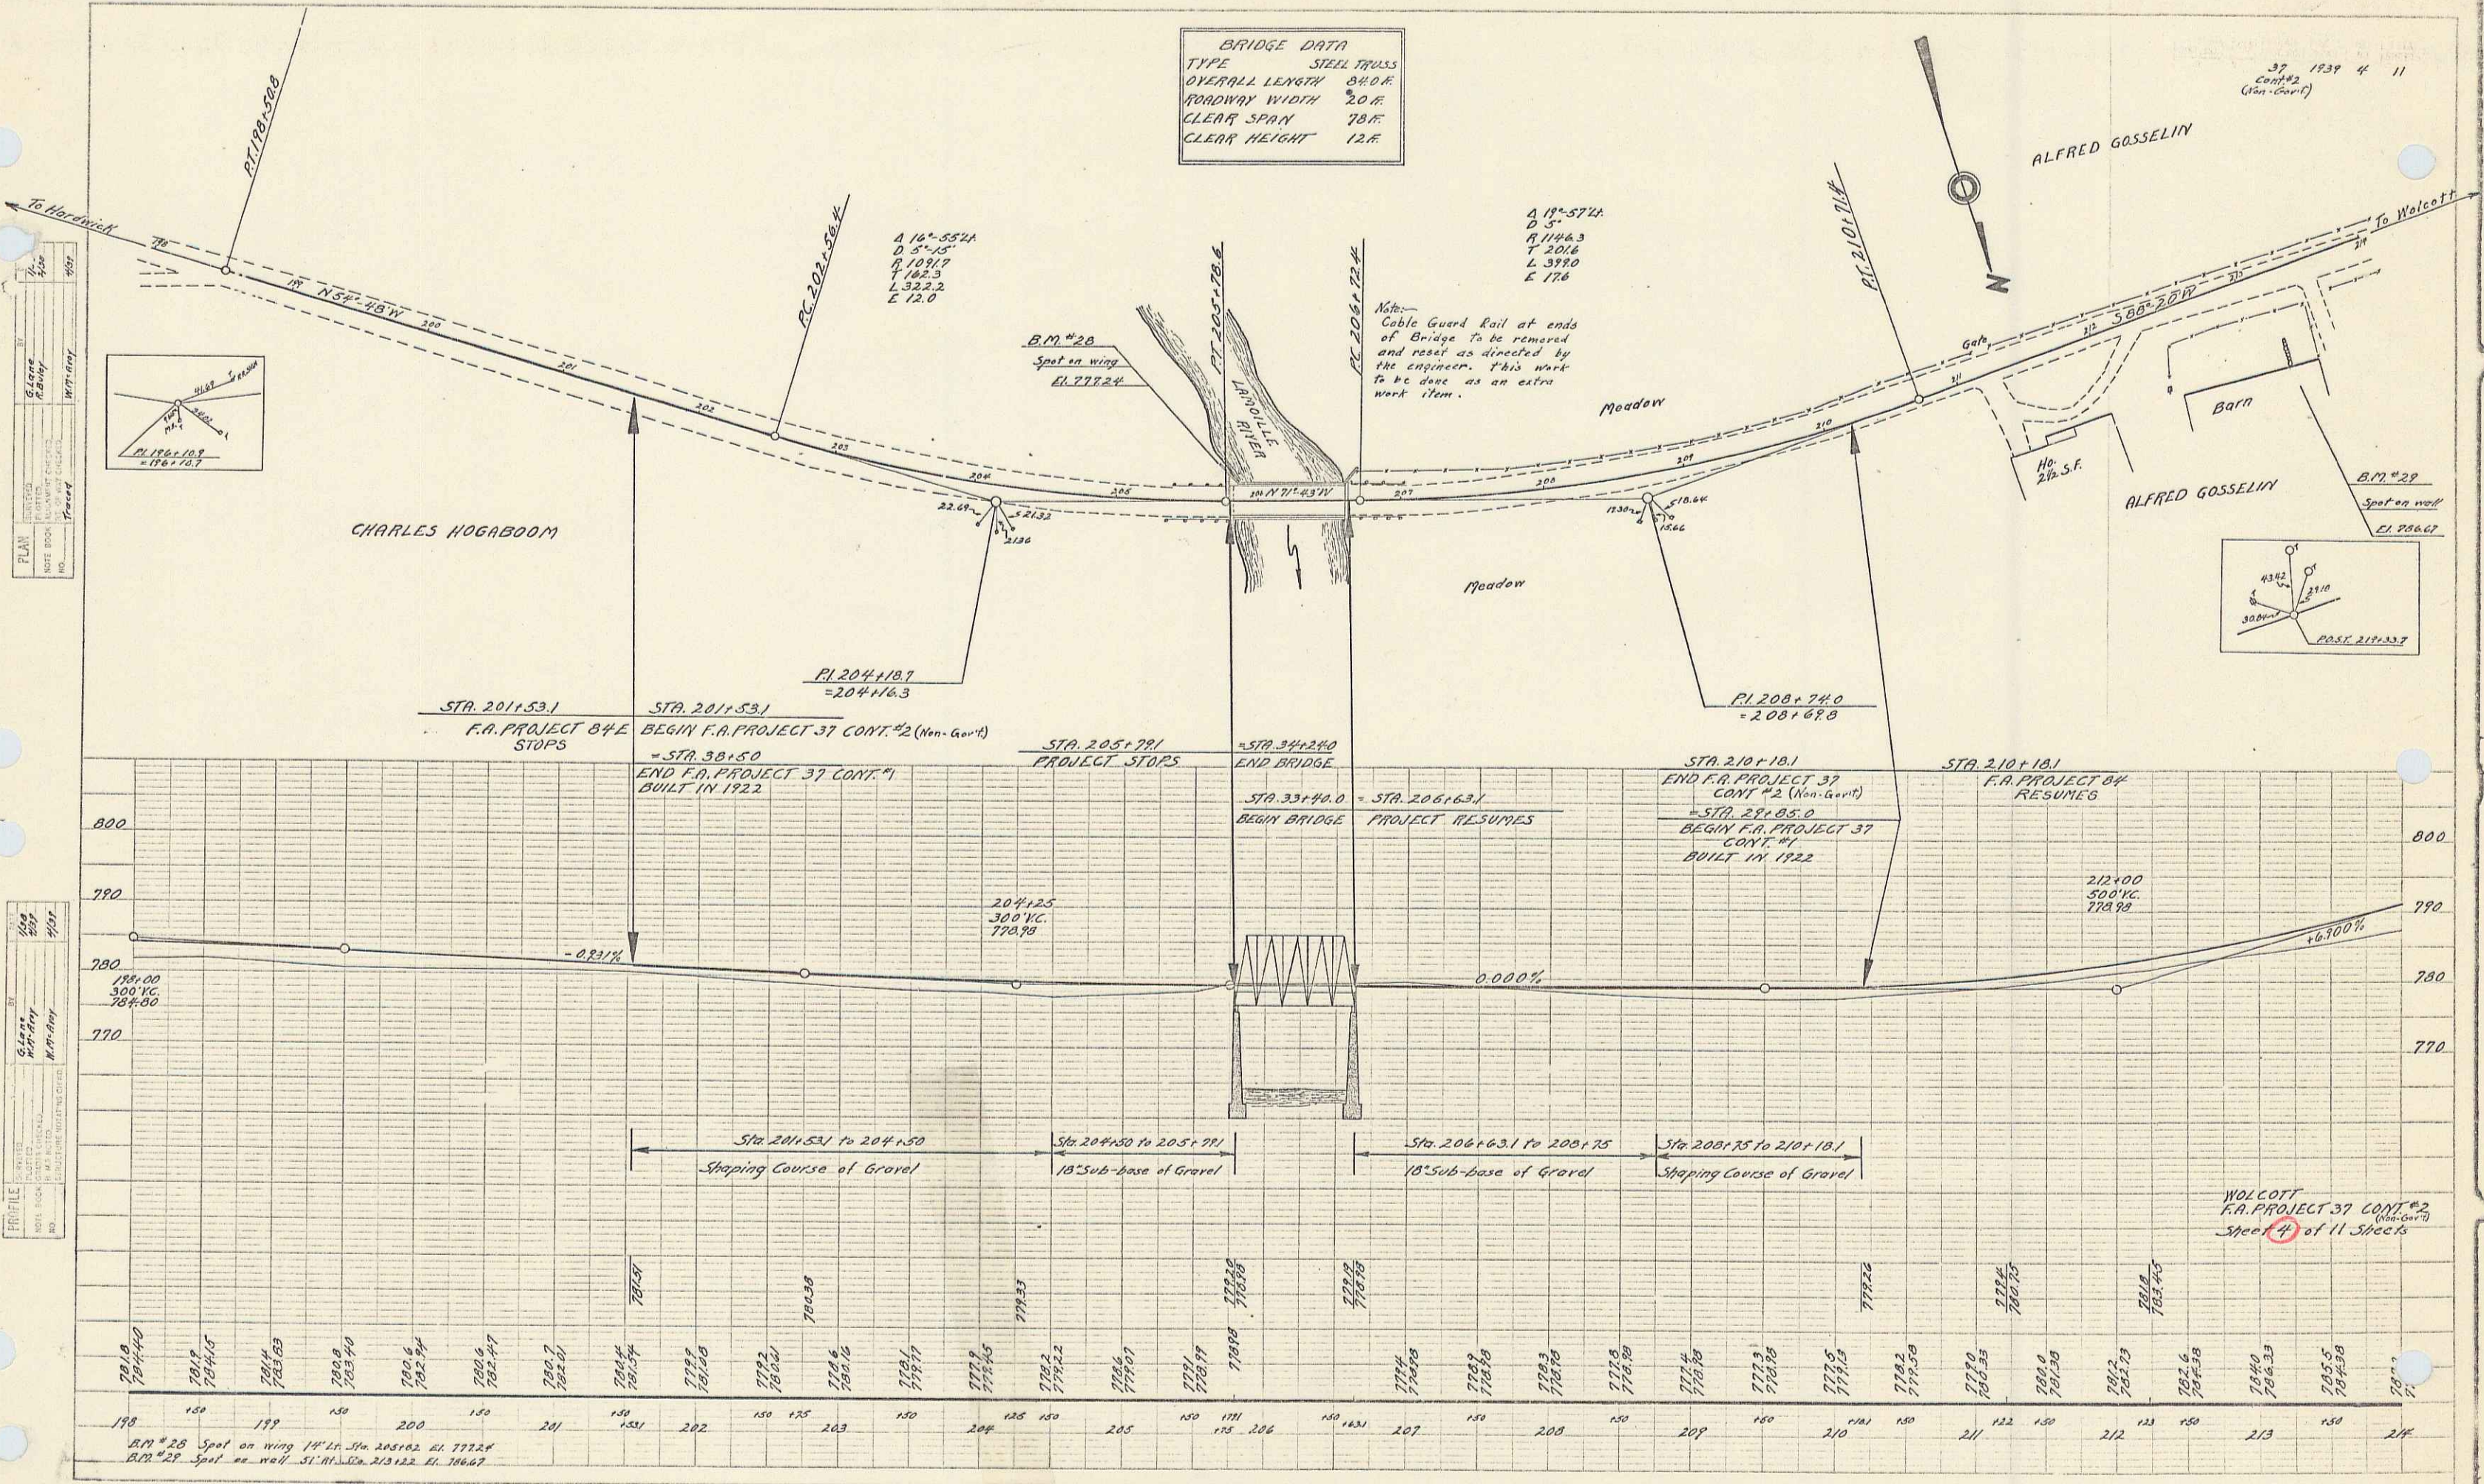
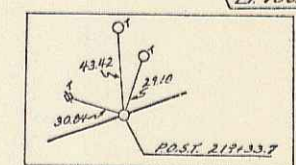


**BRIDGE DATA**  
 TYPE STEEL TRUSS  
 OVERALL LENGTH 84.0 F.  
 ROADWAY WIDTH 20 F.  
 CLEAR SPAN 78 F.  
 CLEAR HEIGHT 12 F.


PLAN  

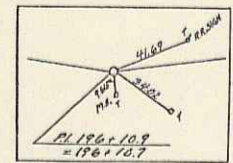

PROFILE  

WOLCOTT  
 F.A. PROJECT 37 CONT #2  
 Sheet 4 of 11 Sheets