


BRIDGE DATA

Constructed	1928
Project No	FR-11E-84-B
Type	Steel Truss
Overall Length	33' 0"
Clear Span	20' 0"
Roadway Width	20' 0"
Clear Height	11' 5"

Δ 71'-08" U
 Δ 6'

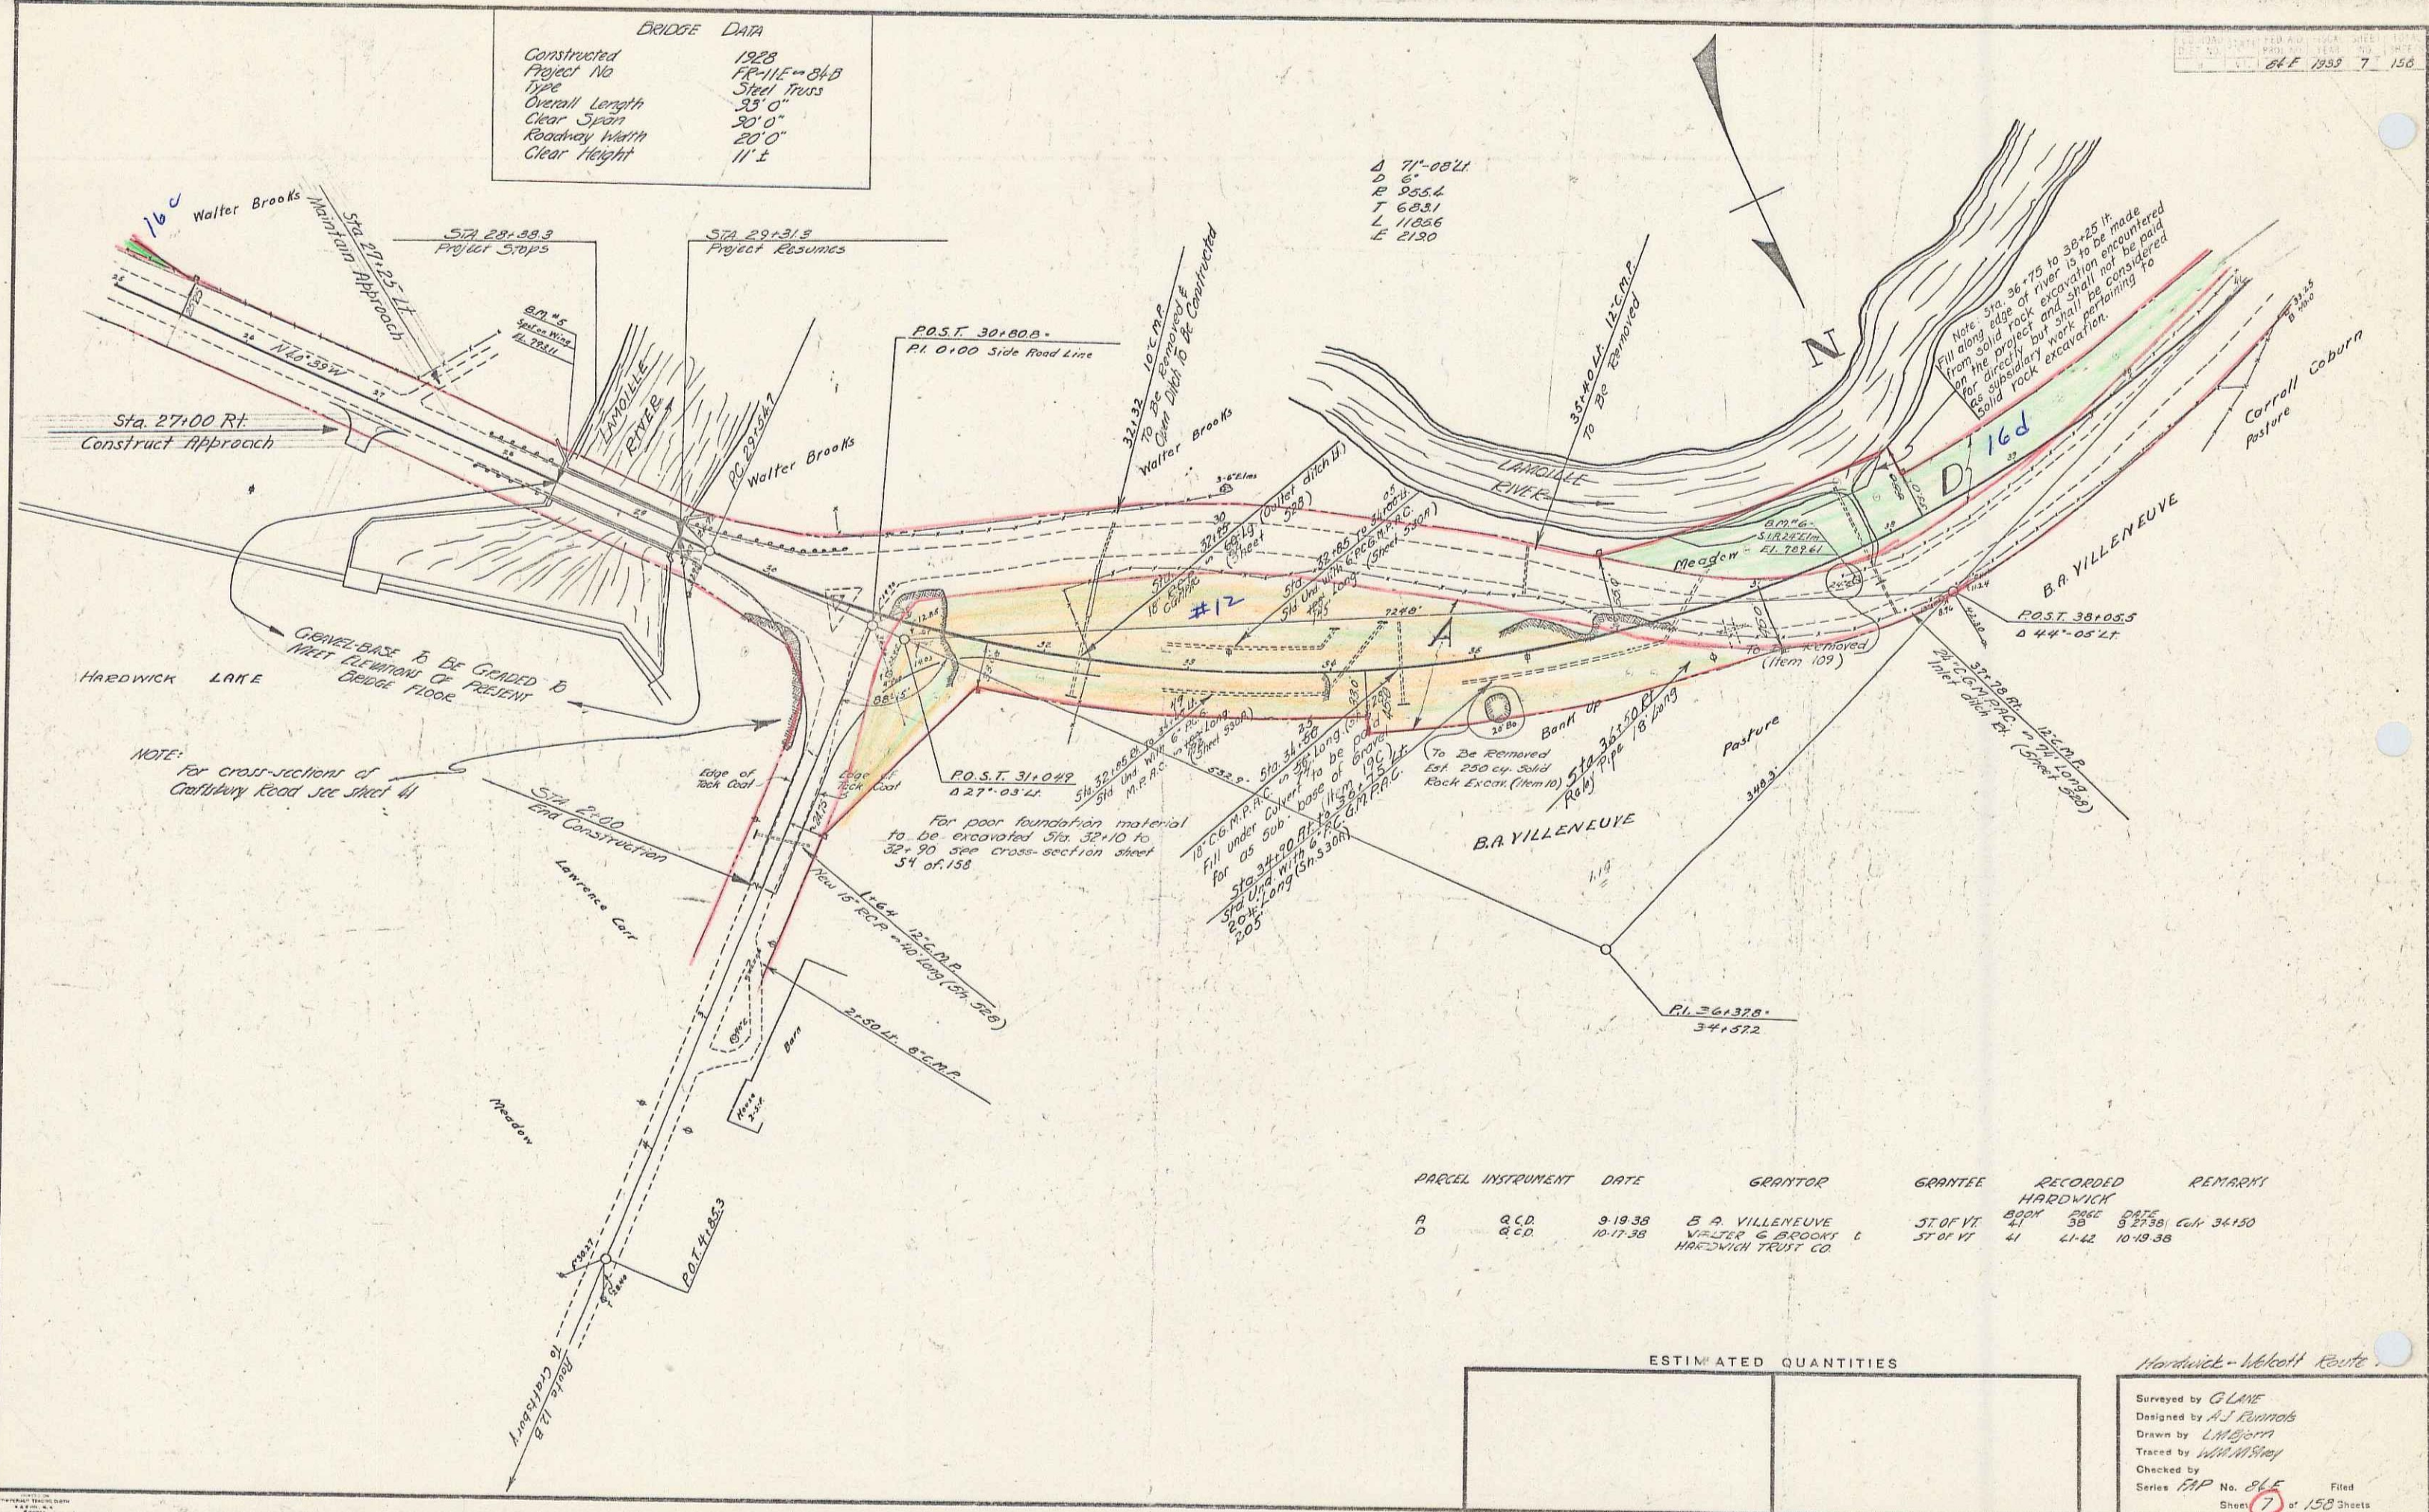

PARCEL	INSTRUMENT	DATE	GRANTOR	GRANTEE	RECORDED	REMARKS
A	A.C.D.	9-19-38	B. A. VILLENEUVE	ST. OF VT.	BOOK PAGE DATE	
D	A.C.D.	10-17-38	WALTER & BROOKS & HARDWICK TRUST CO.	ST. OF VT.	41 21-42 10-19-38	Vol. 34-150

ESTIMATED QUANTITIES

Hardwick - Melcott Route

Surveyed by G. L. N.E.
 Designed by A. J. Reynolds
 Drawn by L. M. Bjorn
 Traced by W. W. W. Gray
 Checked by
 Series PAP No. 845
 Sheet 7 of 158 Sheets

