F.E.D. ROAD DIST. NO.	STATE	FED. AID PROJ. NO.	FISCAL YEAR	SHEET NO.	TOTAL SHEETS
9	Vt.	84-E	1958	10	158

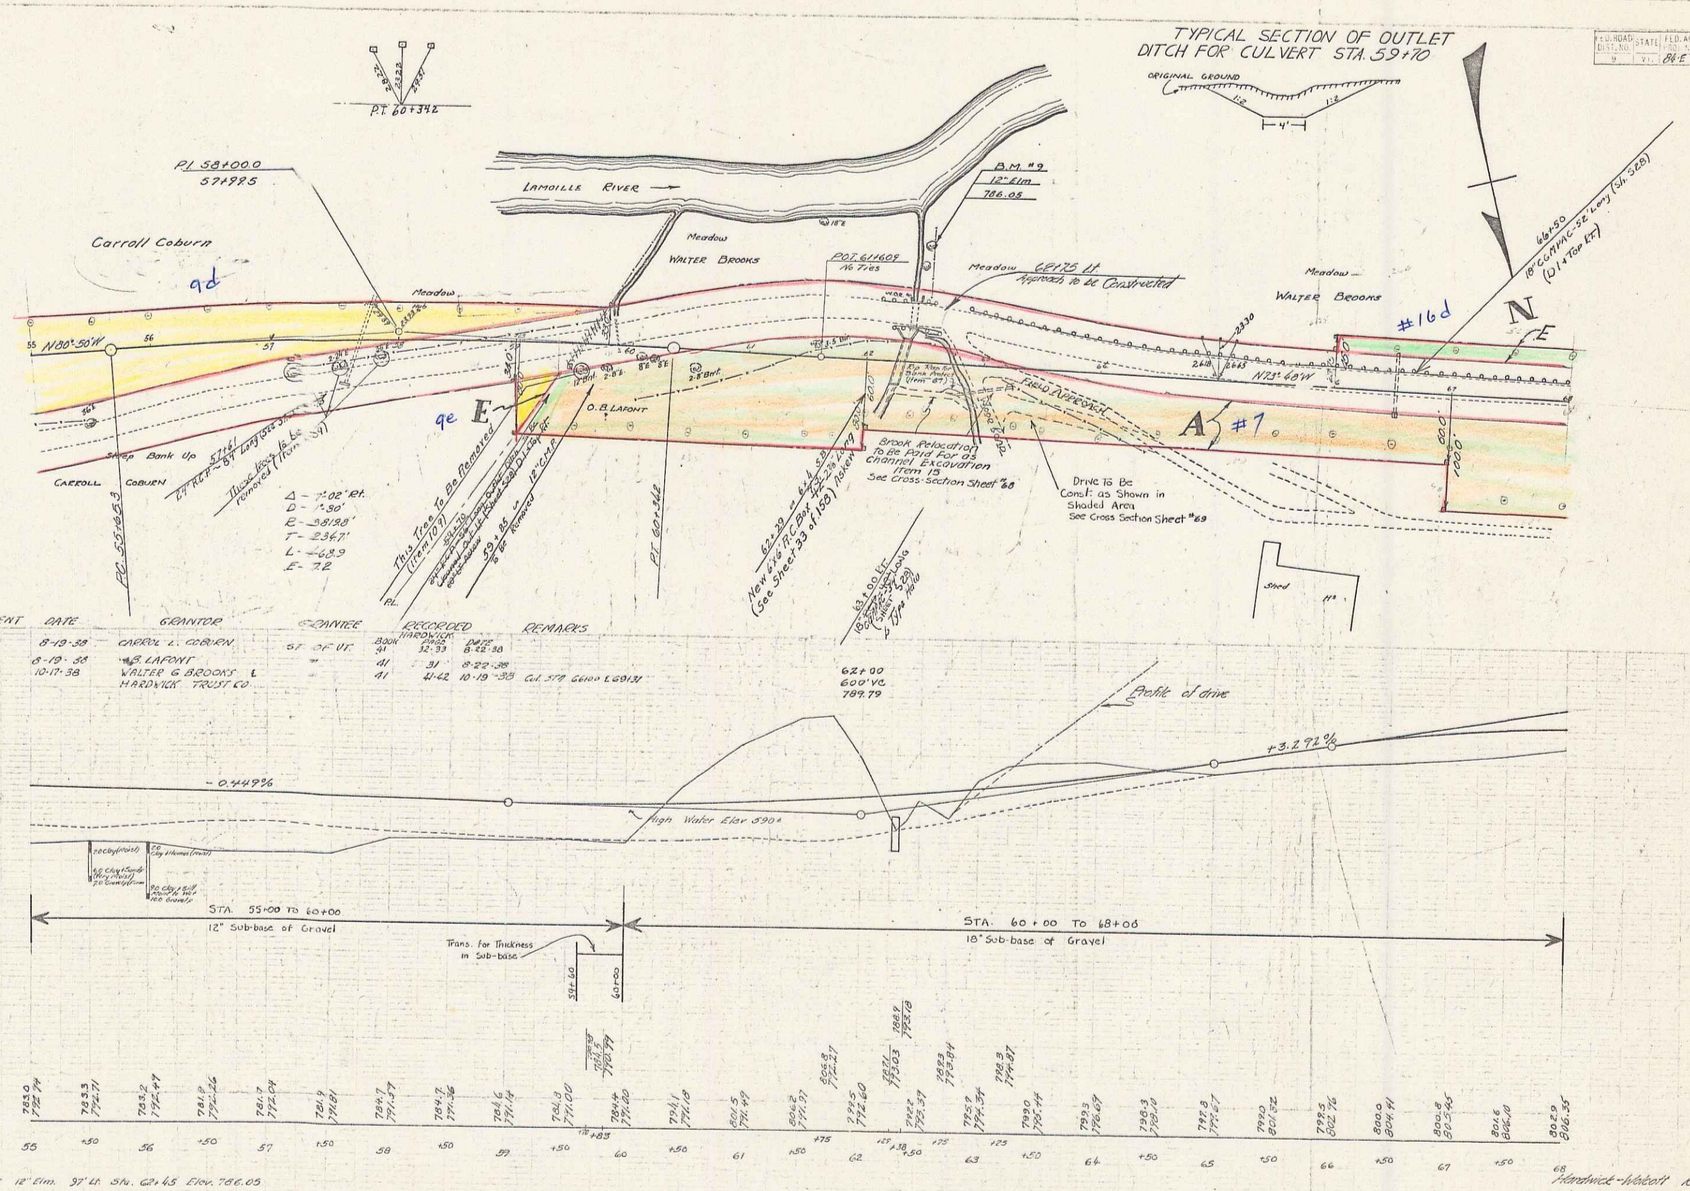

PARCEL	INSTRUMENT	DATE	GRANTOR	GRANTEE	SF OF UT.	RECORDED HARDWICK BOOK	PAGE	DATE	REMARKS
E	Q.C.D.	8-19-38	CARROL L. COBURN			41	32-33	8-22-38	
A	Q.C.D.	8-19-38	O.B. LAFONT	"		41	31	8-22-38	
E	Q.C.D.	10-17-38	WALTER G. BROOKS & HARDWICK TRUST CO.			41	41-42	10-19-38	Cd. 379 Geiss LG 91.31

Hardwick-Wolcott Route 15
Series FAP No. 84-E
Sheet 10 of 158

10