FED. ROAD DIST. NO.	STATE	FED. AID PROJ. NO.	TOTAL SHEETS	SHEET NO.
9	VT.	BR-E 1939	13	150

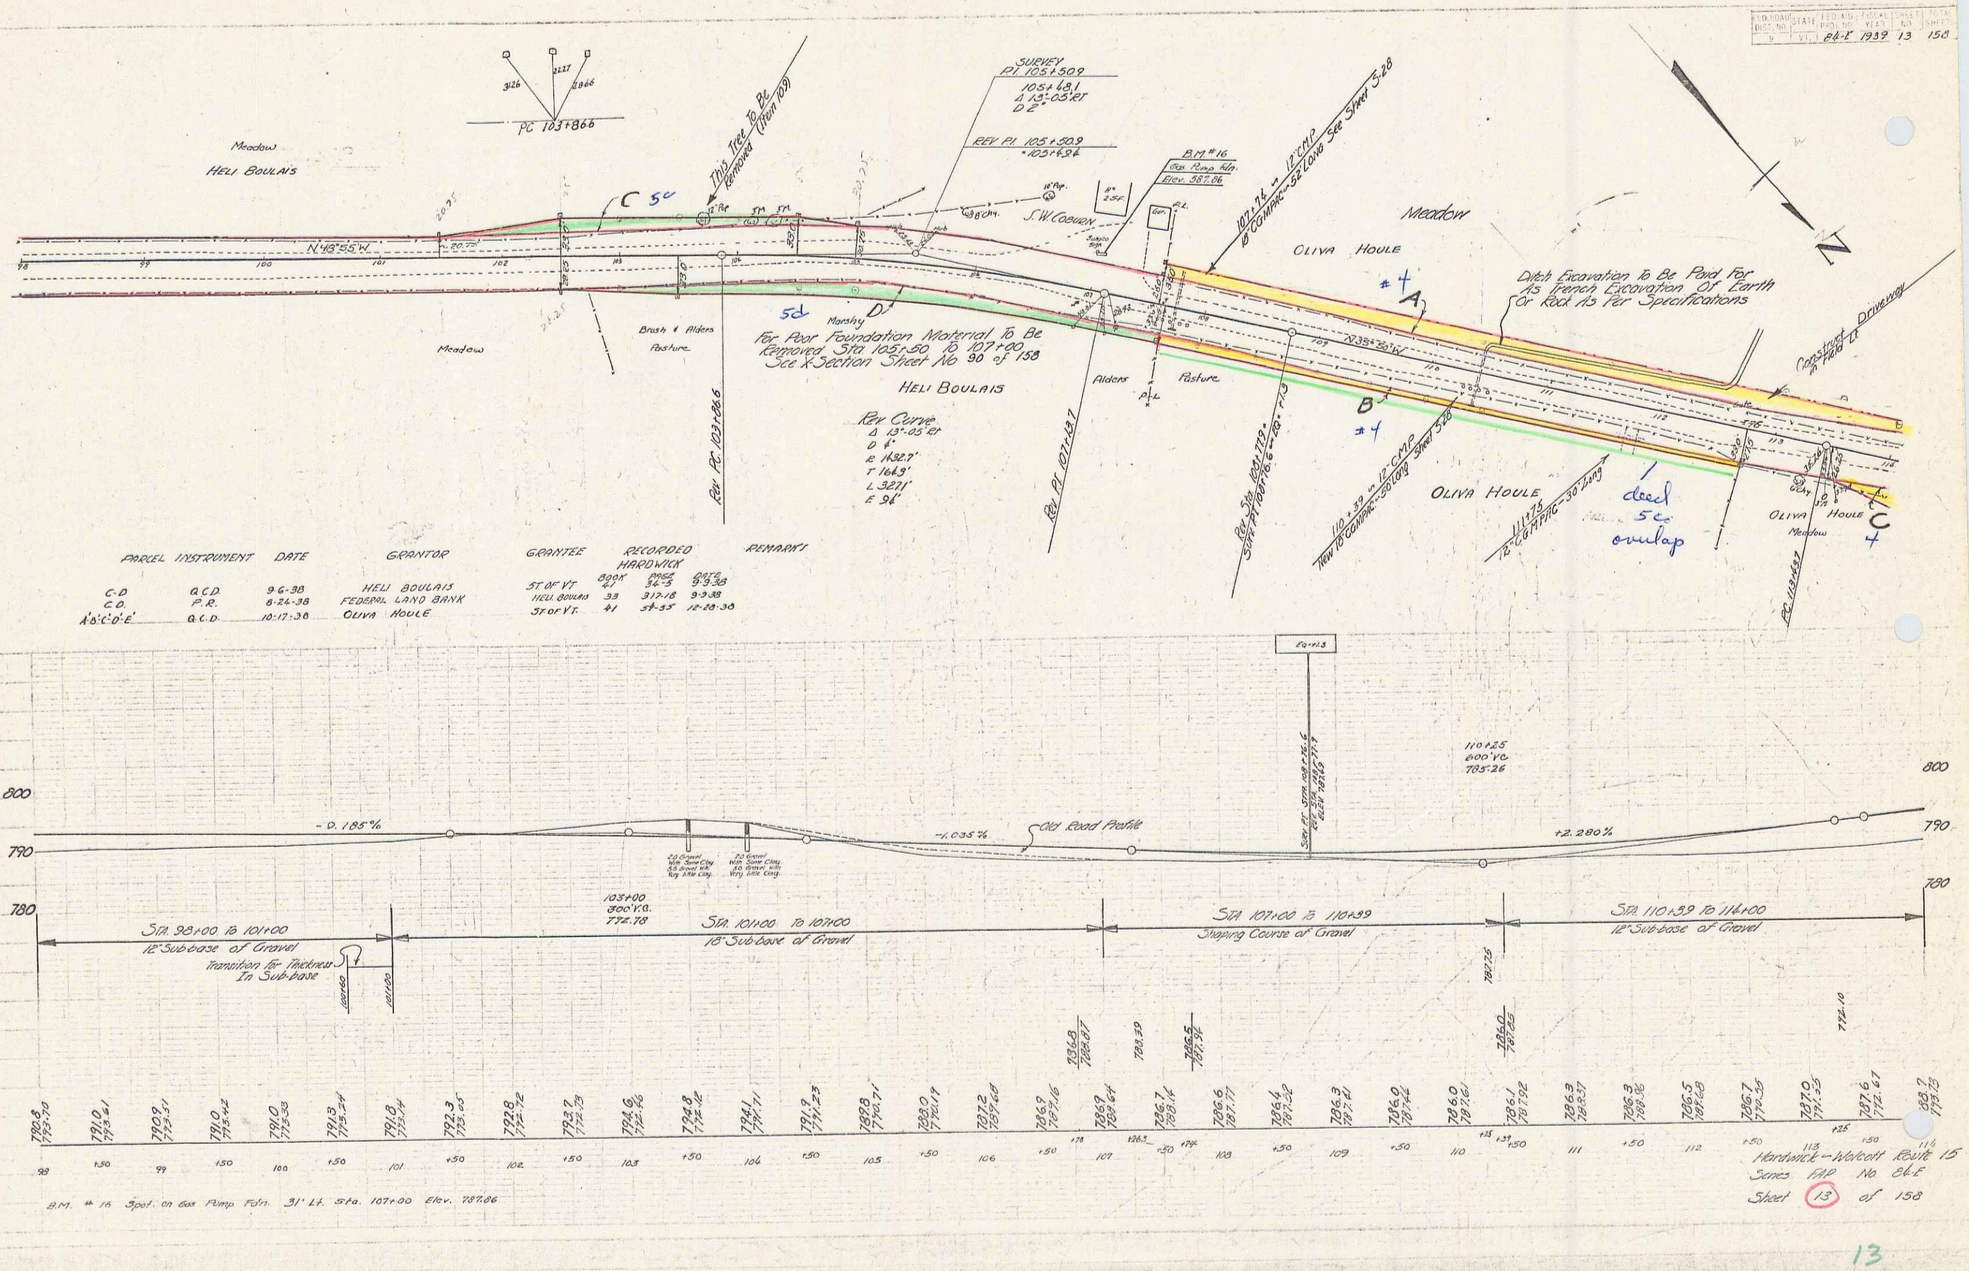

PARCEL	INSTRUMENT	DATE	GRANTOR	GRANTEE	RECORDED HARDWICK BOOK	PAGE	DATE	REMARKS
C.D.	Q.C.D.	9-6-38	HELI BOULAIS	ST OF VT.	41	54-3	9-9-38	
C.D.	P.R.	8-24-38	FEDERAL LAND BANK	HELI BOULAIS	33	317-18	9-9-38	
A'-B'-C'-D'-E'	Q.C.D.	10-17-38	OLIVA HOULE	ST OF VT.	41	54-55	12-28-38	

Hardwick – Wolcott Route 15
Series FAP No BR-E
Sheet 13 of 158

13