


PARCEL	INSTRUMENT	DATE	GRANTOR	GRANTEE	RECORDED	WOLCOTT	REMARKS
A	Q.C.D.	8-19-38	FLOYD FLANDERS	ST. OF VT.	24	178	
B	Q.C.D.	9-6-38	HC WILLIAMS & FRANCIS CLARK	ST. OF VT.	24	187	



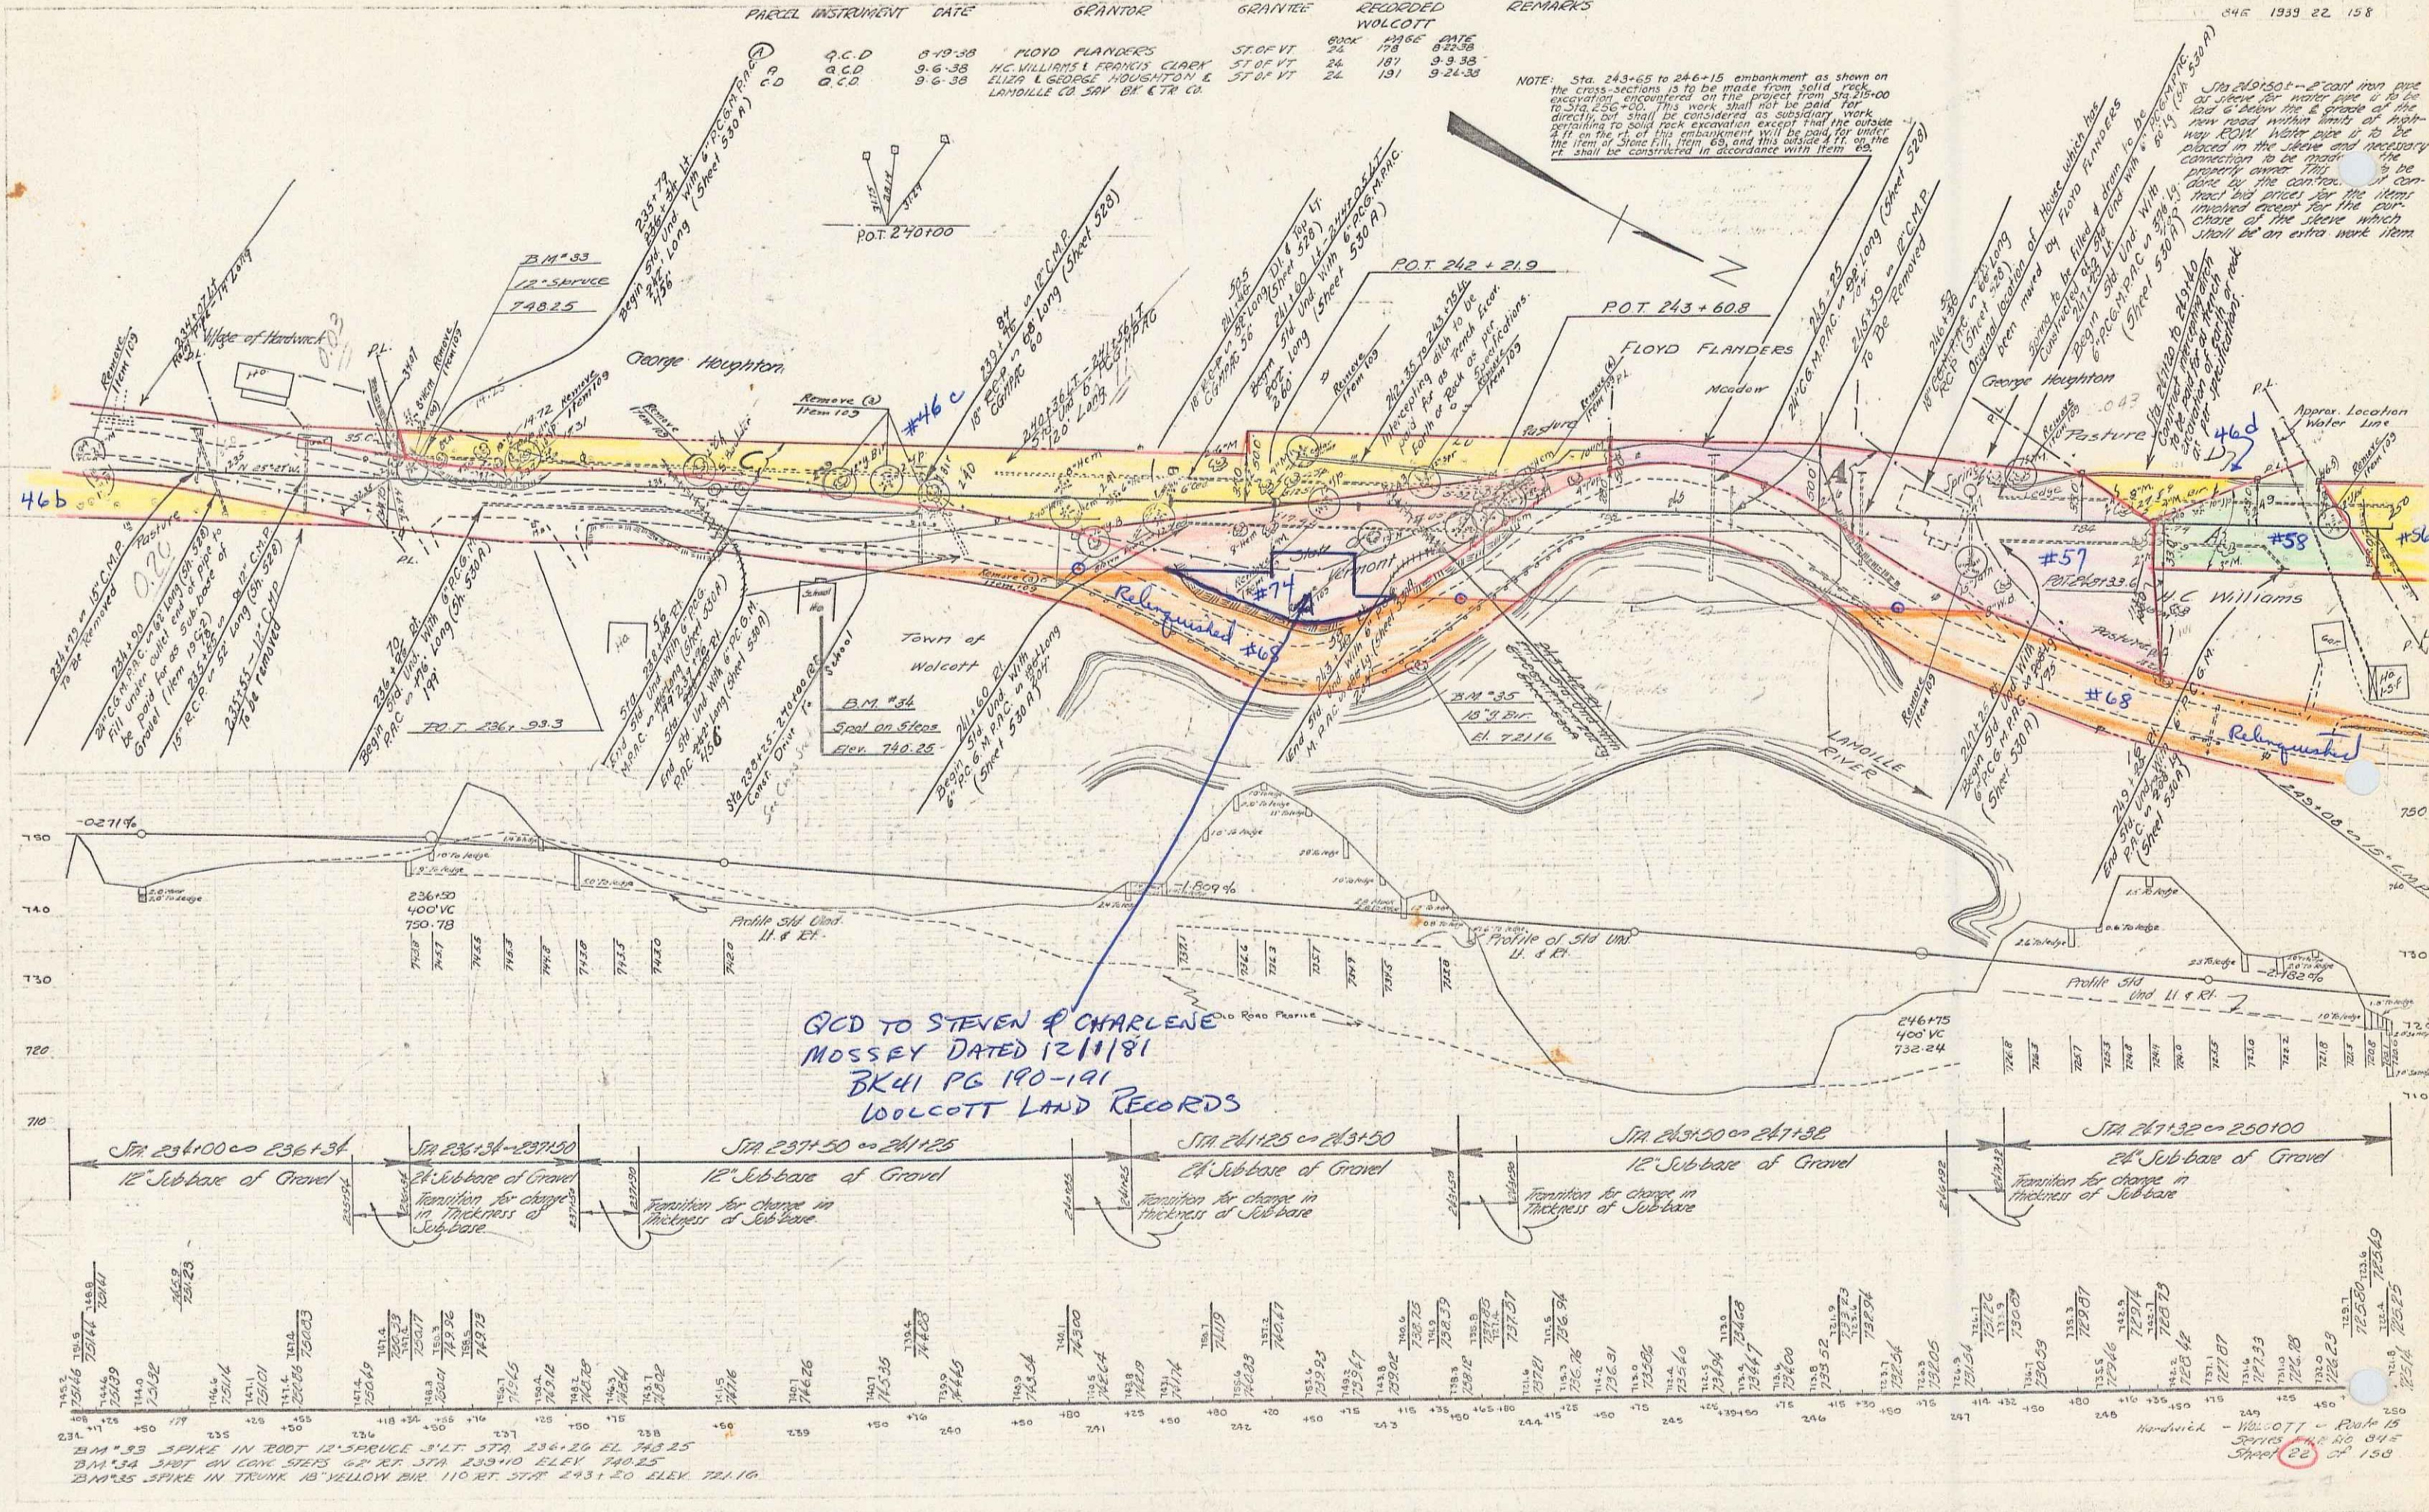

Q.C.D. TO STEVEN & CHARLENE MOSSEY DATED 12/1/81 BK 41 PG 190-191 WOLCOTT LAND RECORDS



345 1939 22 158