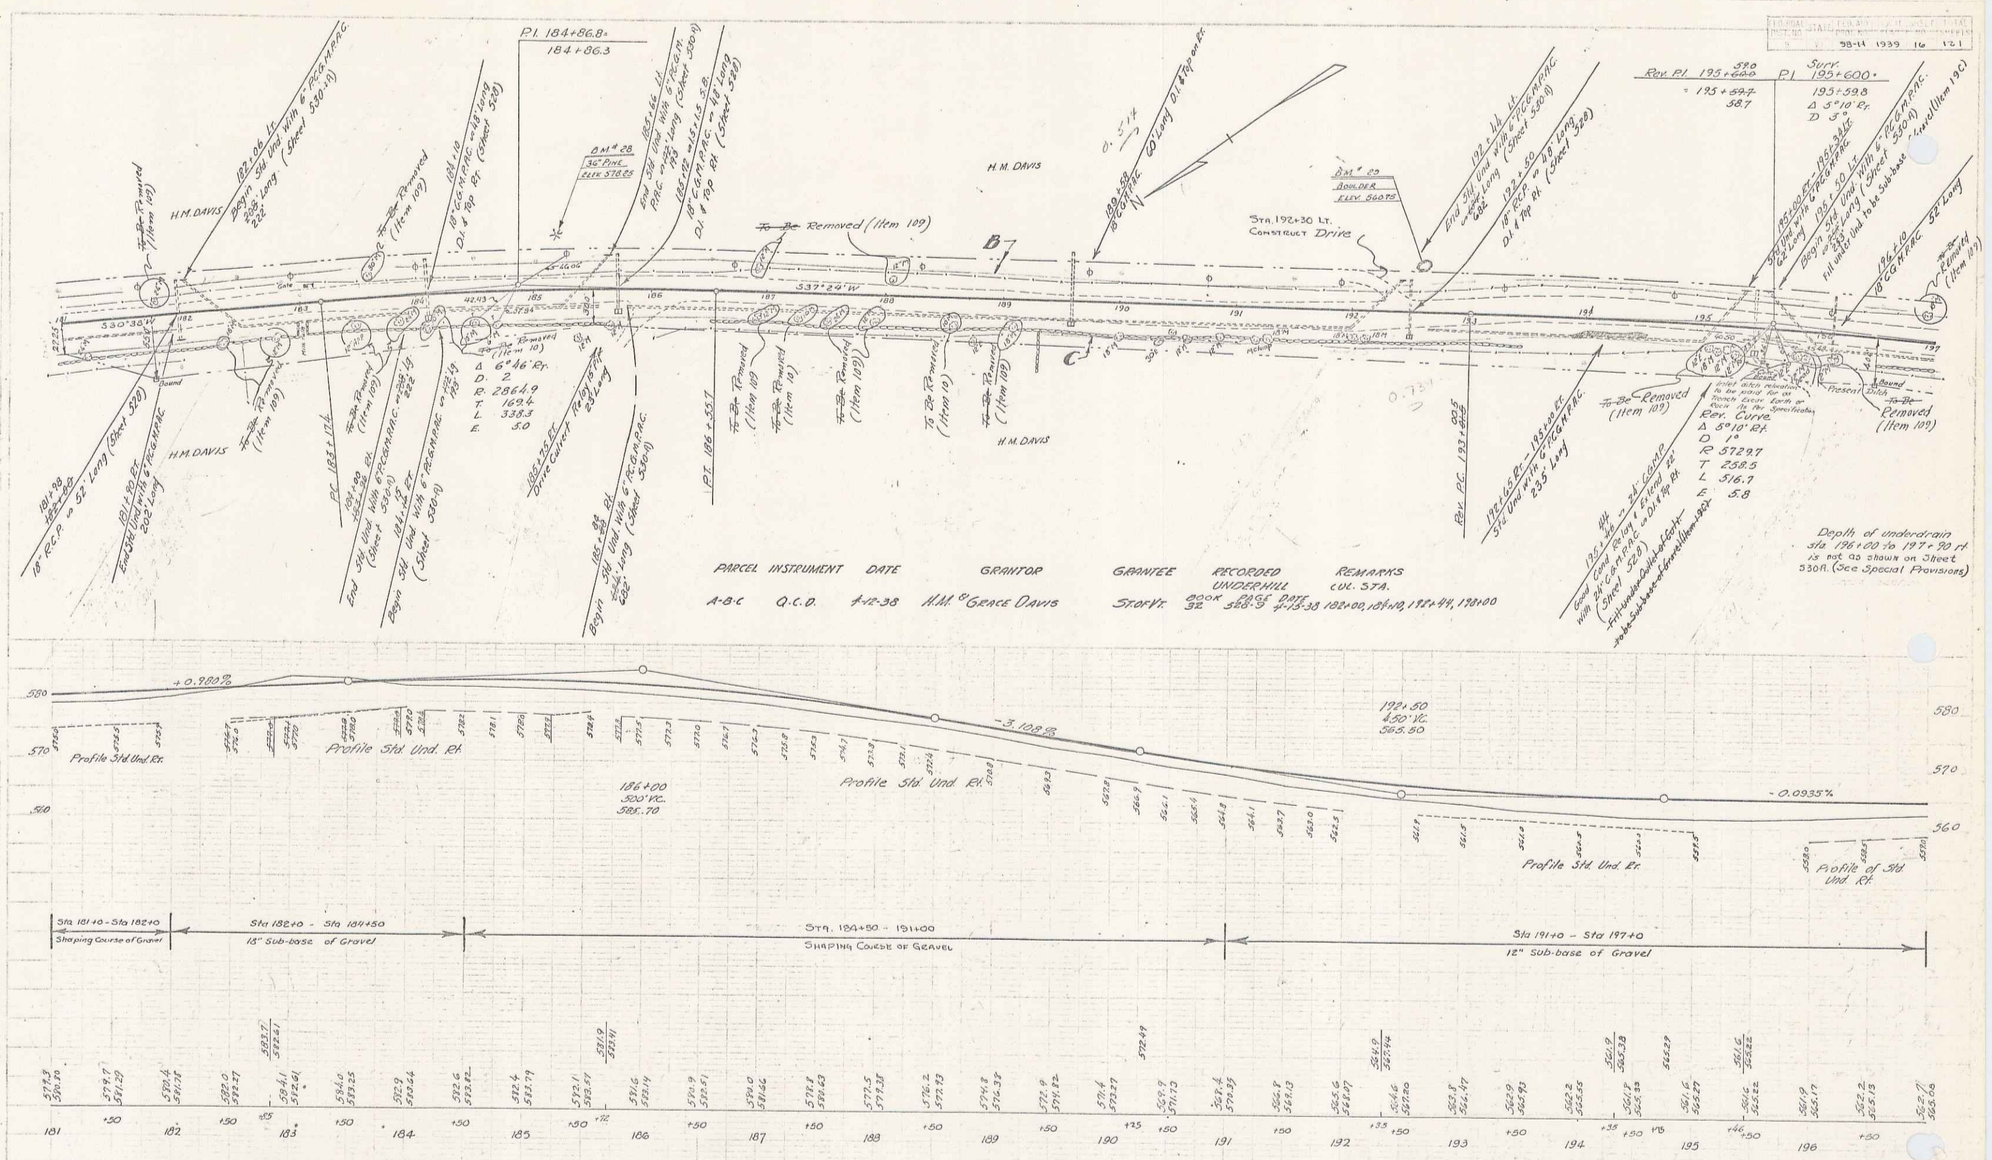
P.I. 184+86.8
184+86.3
H.M. DAVIS
Rev. P.I. 195+69.7
Surv. 195+60.0
Sta. 192+30 Lt.
Construct Drive
Δ 6°46' Rt.
D 2
R 2864.9
T 169.4
L 338.3
E 5.0
Rev. Curve
Δ 5°10' Rt.
D 1°
R 5729.7
T 258.5
L 516.7
E 5.8
Depth of underdrain sta 196+00 to 197+90 is not as shown on Sheet 330A. (See Special Provisions)
PARCEL INSTRUMENT DATE GRANTOR GRANTEE RECORDED UNDERHILL REMARKS CUL. STA.
A-8-C Q.C.D. 4-12-38 H.M. & Grace Davis State of Vt. BOOK 32 PAGE 328-9 DATE 4-15-38 182+00, 184+90, 192+44, 198+00
+0.980%
-3.108%
-0.0935%
Profile Std. Und. Rt.
Profile of Std. Und. Rt.
Sta 181+0 - Sta 182+0
Shaping Course of Gravel
Sta 182+0 - Sta 184+50
18" Sub-base of Gravel
Sta. 184+50 - 191+00
Shaping Course of Gravel
Sta 191+0 - Sta 197+0
12" Sub-base of Gravel

