PARCEL	INSTRUMENT	DATE	GRANTOR	GRANTEE	RECORDED UNDERHILL BOOK	PAGE	DATE	REMARKS
D-E	Q.C.D	4-12/18-38	P.J. Bolio					
A-B-C	W.D.	5-31-38	Orrilla Rawson	St. of Vt	32	592-3	4-22-38	
				St. of Vt.	33	16-16	6-11-38	

Note: Sta. 223+00 to 225+00 In accordance with the right of way agreement obtained from the property owner the slope between the above Stations is to be covered with loam and seeded.

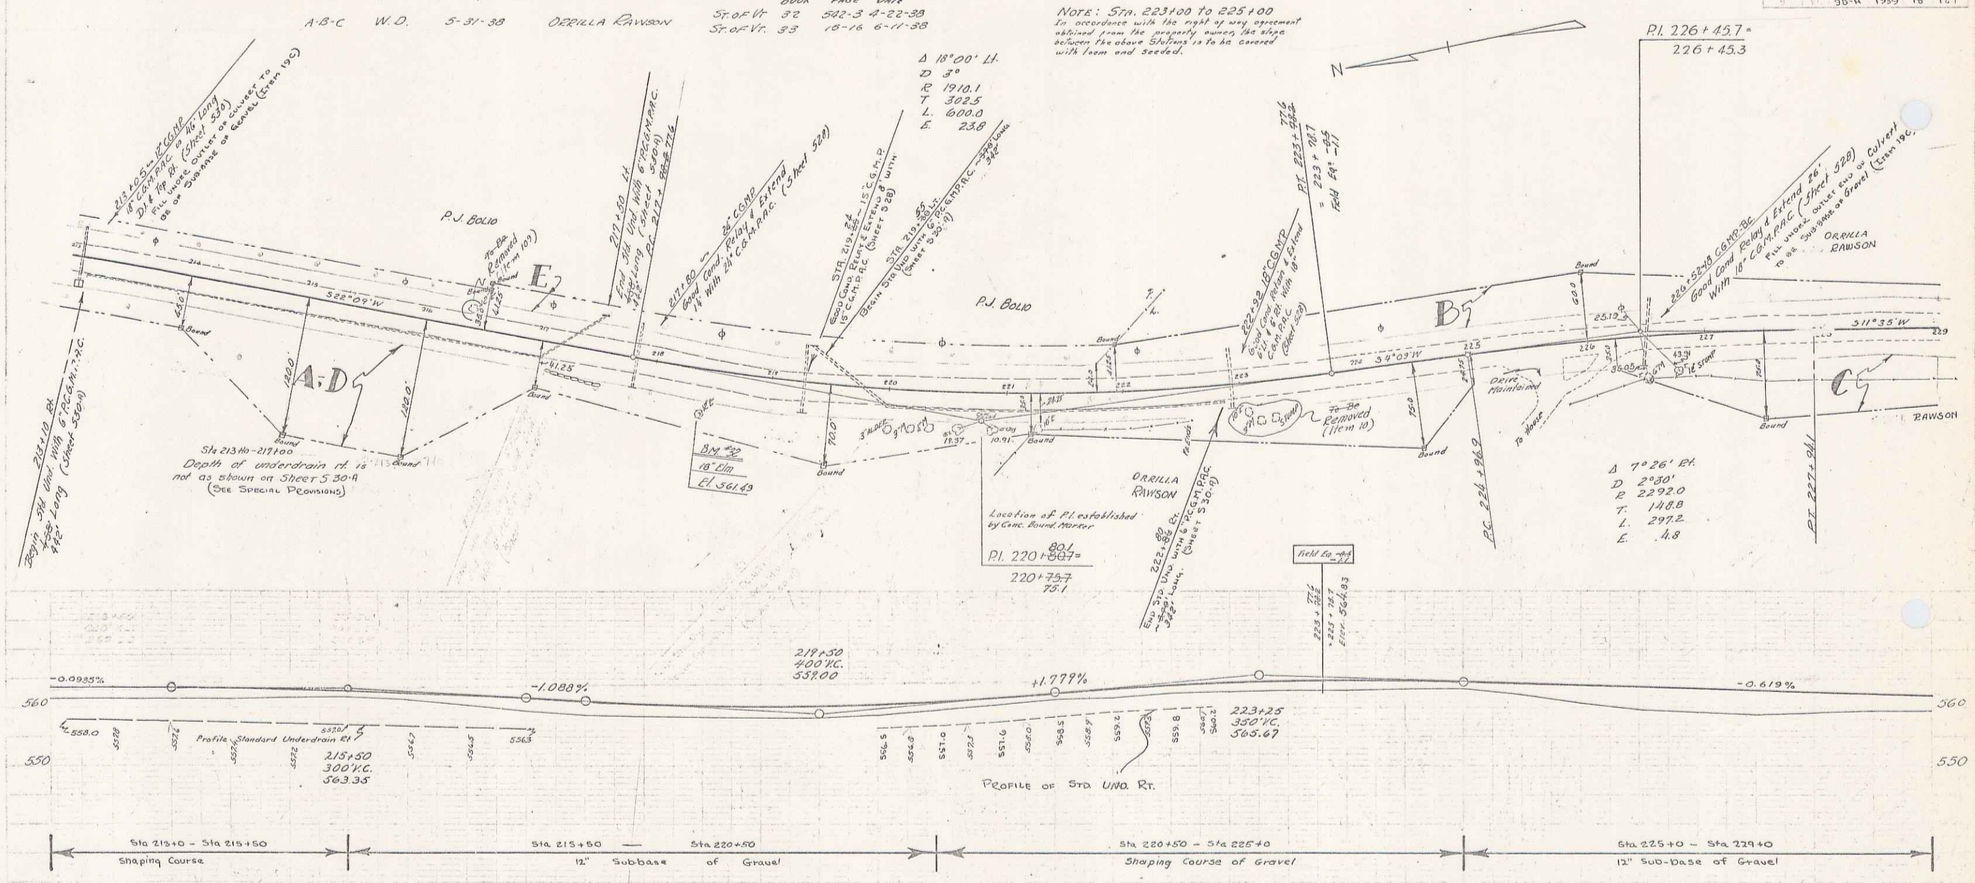

B.M. No 32 – spike in root of 18" elm 40' right of sta. 218+36 – elevation: 561.49.

Series FAP No. 98-H
Sheet 19 of 121

19