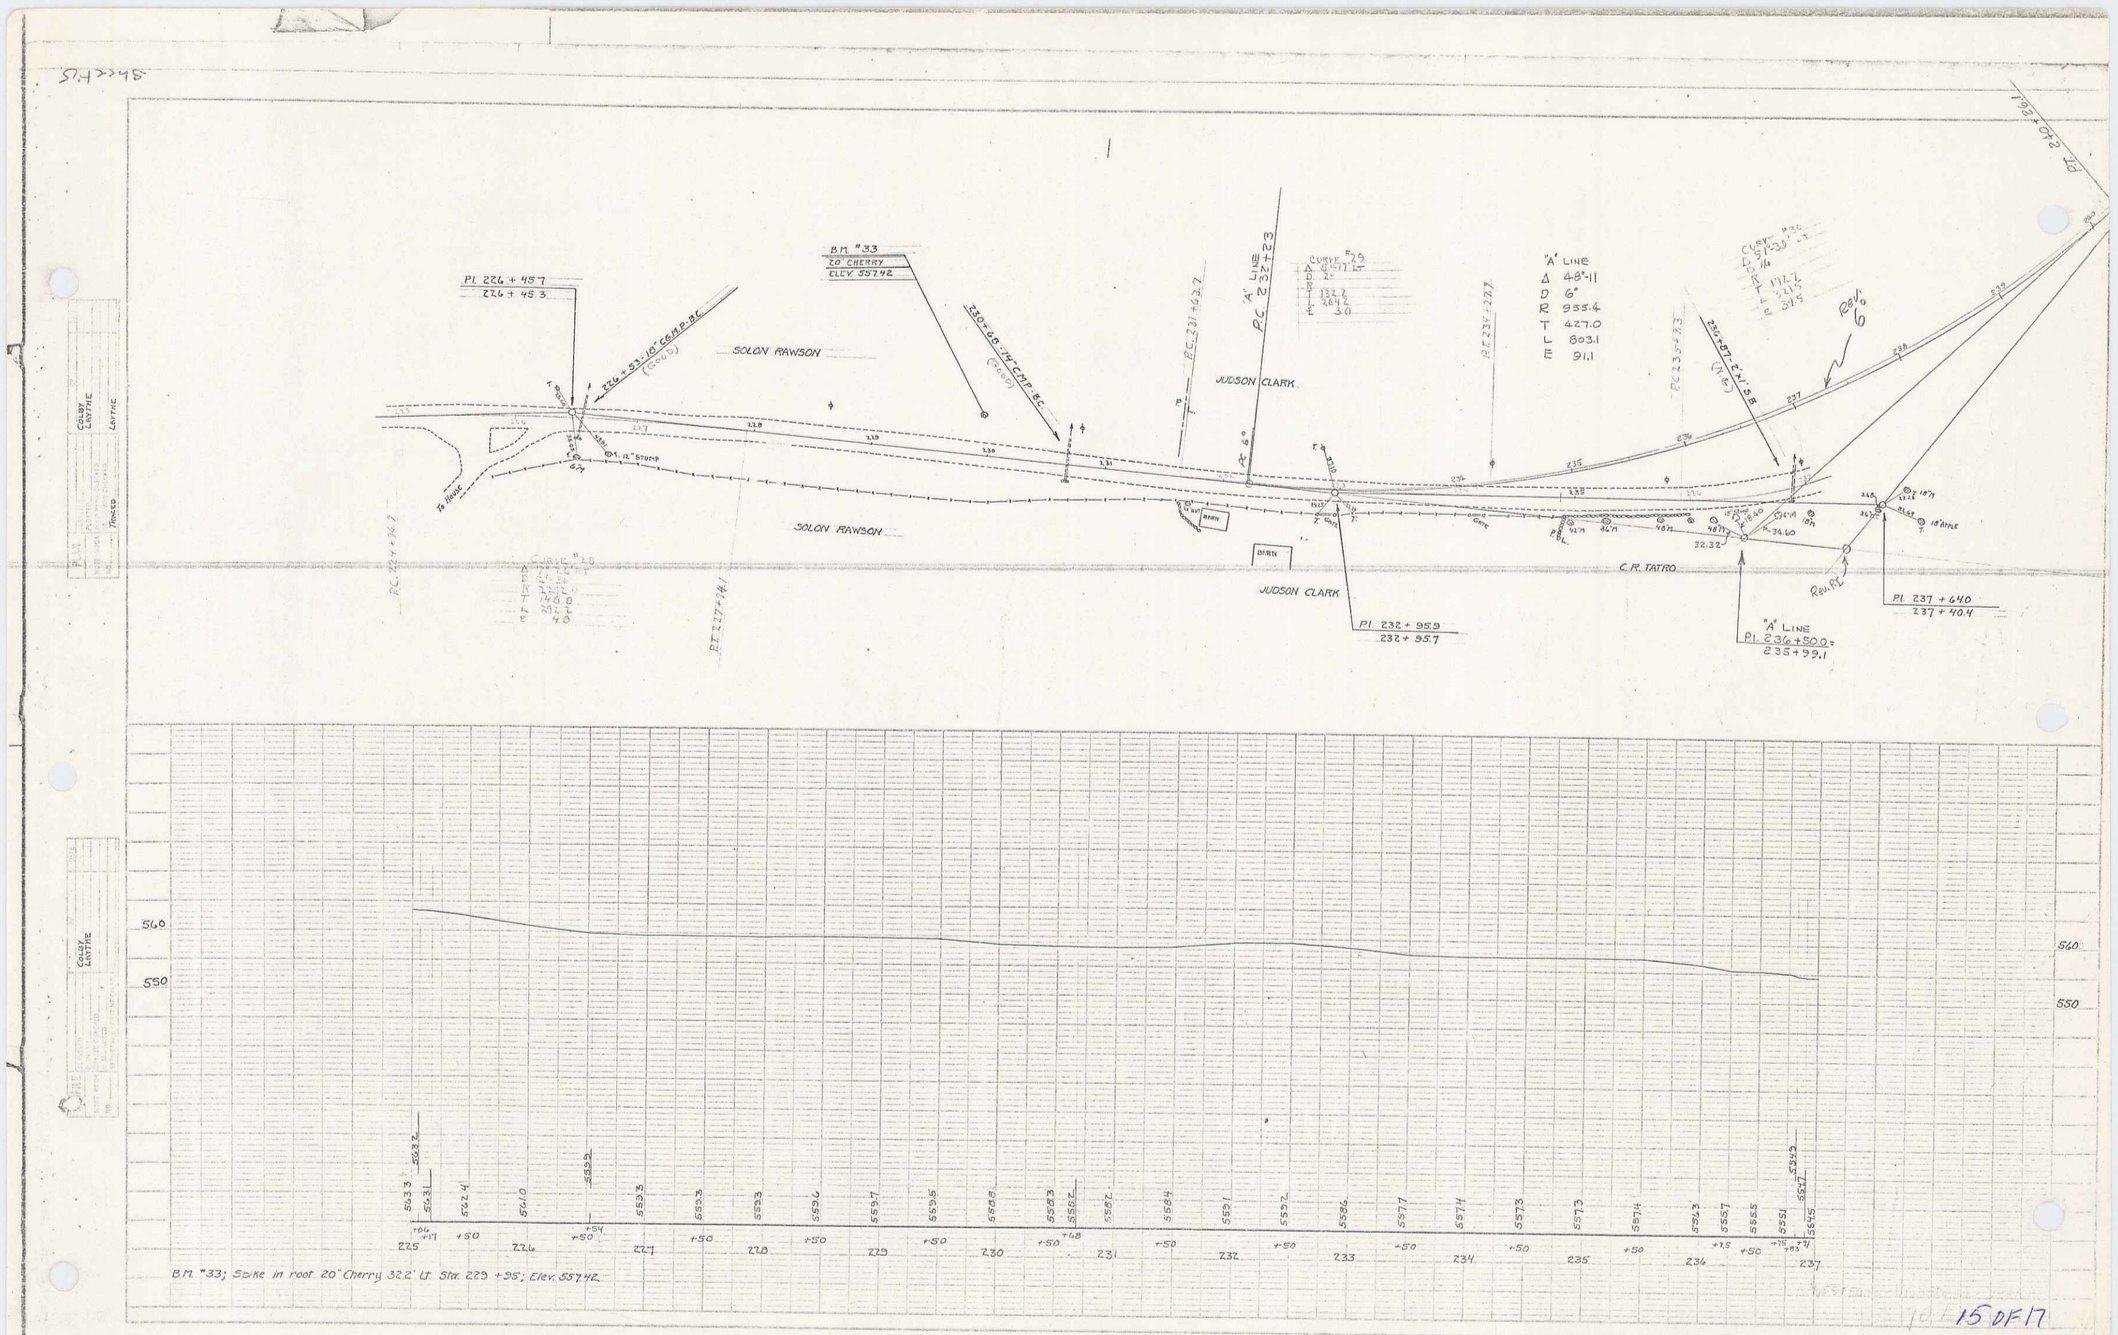
PI. 226 + 45.7
226 + 45.3
BM #33
20" CHERRY
ELEV. 557.42
SOLON RAWSON
JUDSON CLARK
"A" LINE
PC 232+22.8
"A" LINE
Δ 48°-11
D 6°
R 955.4
T 427.0
L 803.1
E 91.1
C.R. TATRO
PI. 232 + 95.9
232 + 95.7
"A" LINE
PI. 236+80.0=
235+99.1
PI. 237 + 64.0
237 + 40.4
BARN
560
550
BM #33; Spike in root 20" Cherry 32.2' Lt. Sta. 229 +95; Elev. 557.42

15 OF 17

14