FED. ROAD DIST. NO.	STATE	FED. AID PROJ. NO.	FISCAL YEAR	SHEET NO.	TOTAL SHEETS
	VT	122(2)			

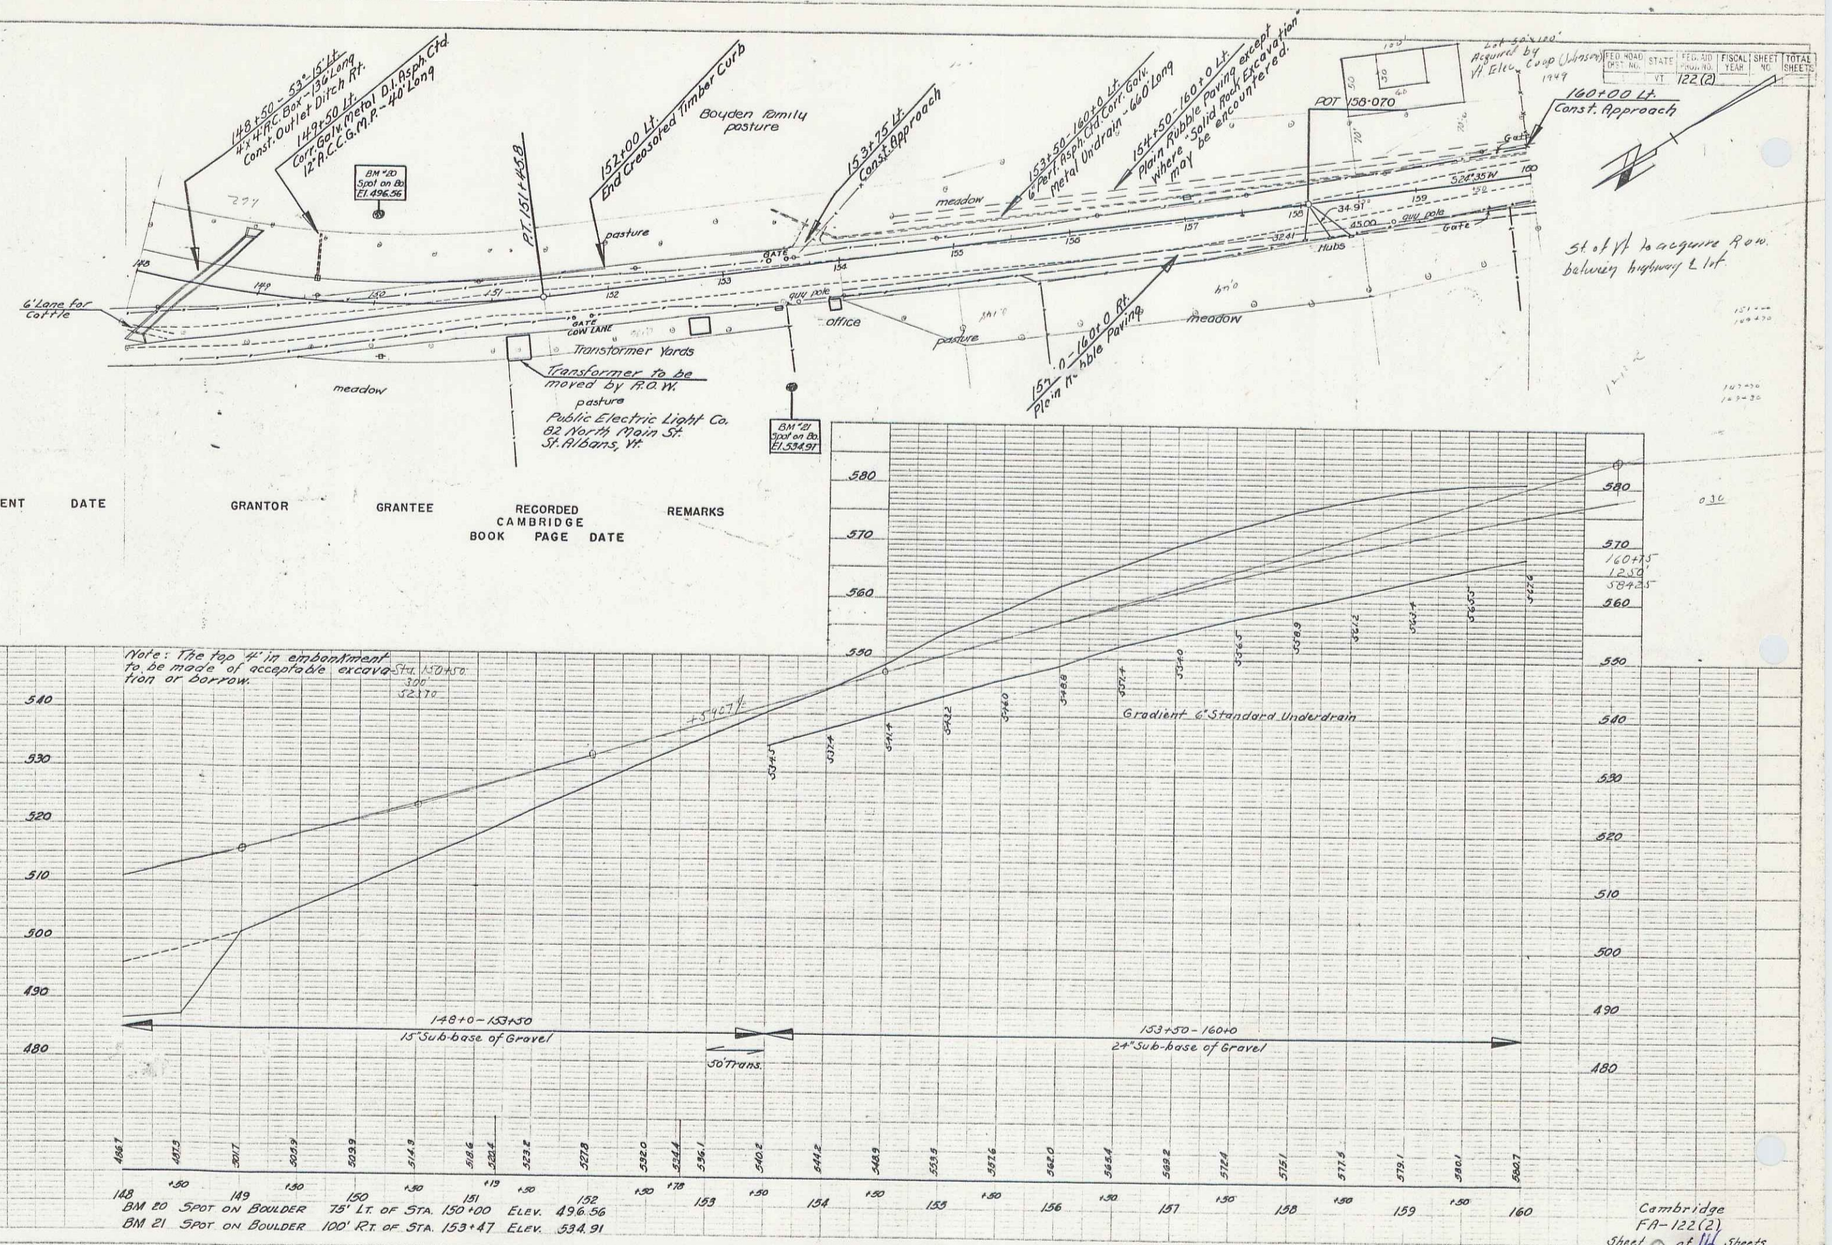

PARCEL	INSTRUMENT	DATE	GRANTOR	GRANTEE	RECORDED CAMBRIDGE BOOK	PAGE	DATE	REMARKS

Cambridge
FA-122(2)
Sheet 8 of 14 Sheets