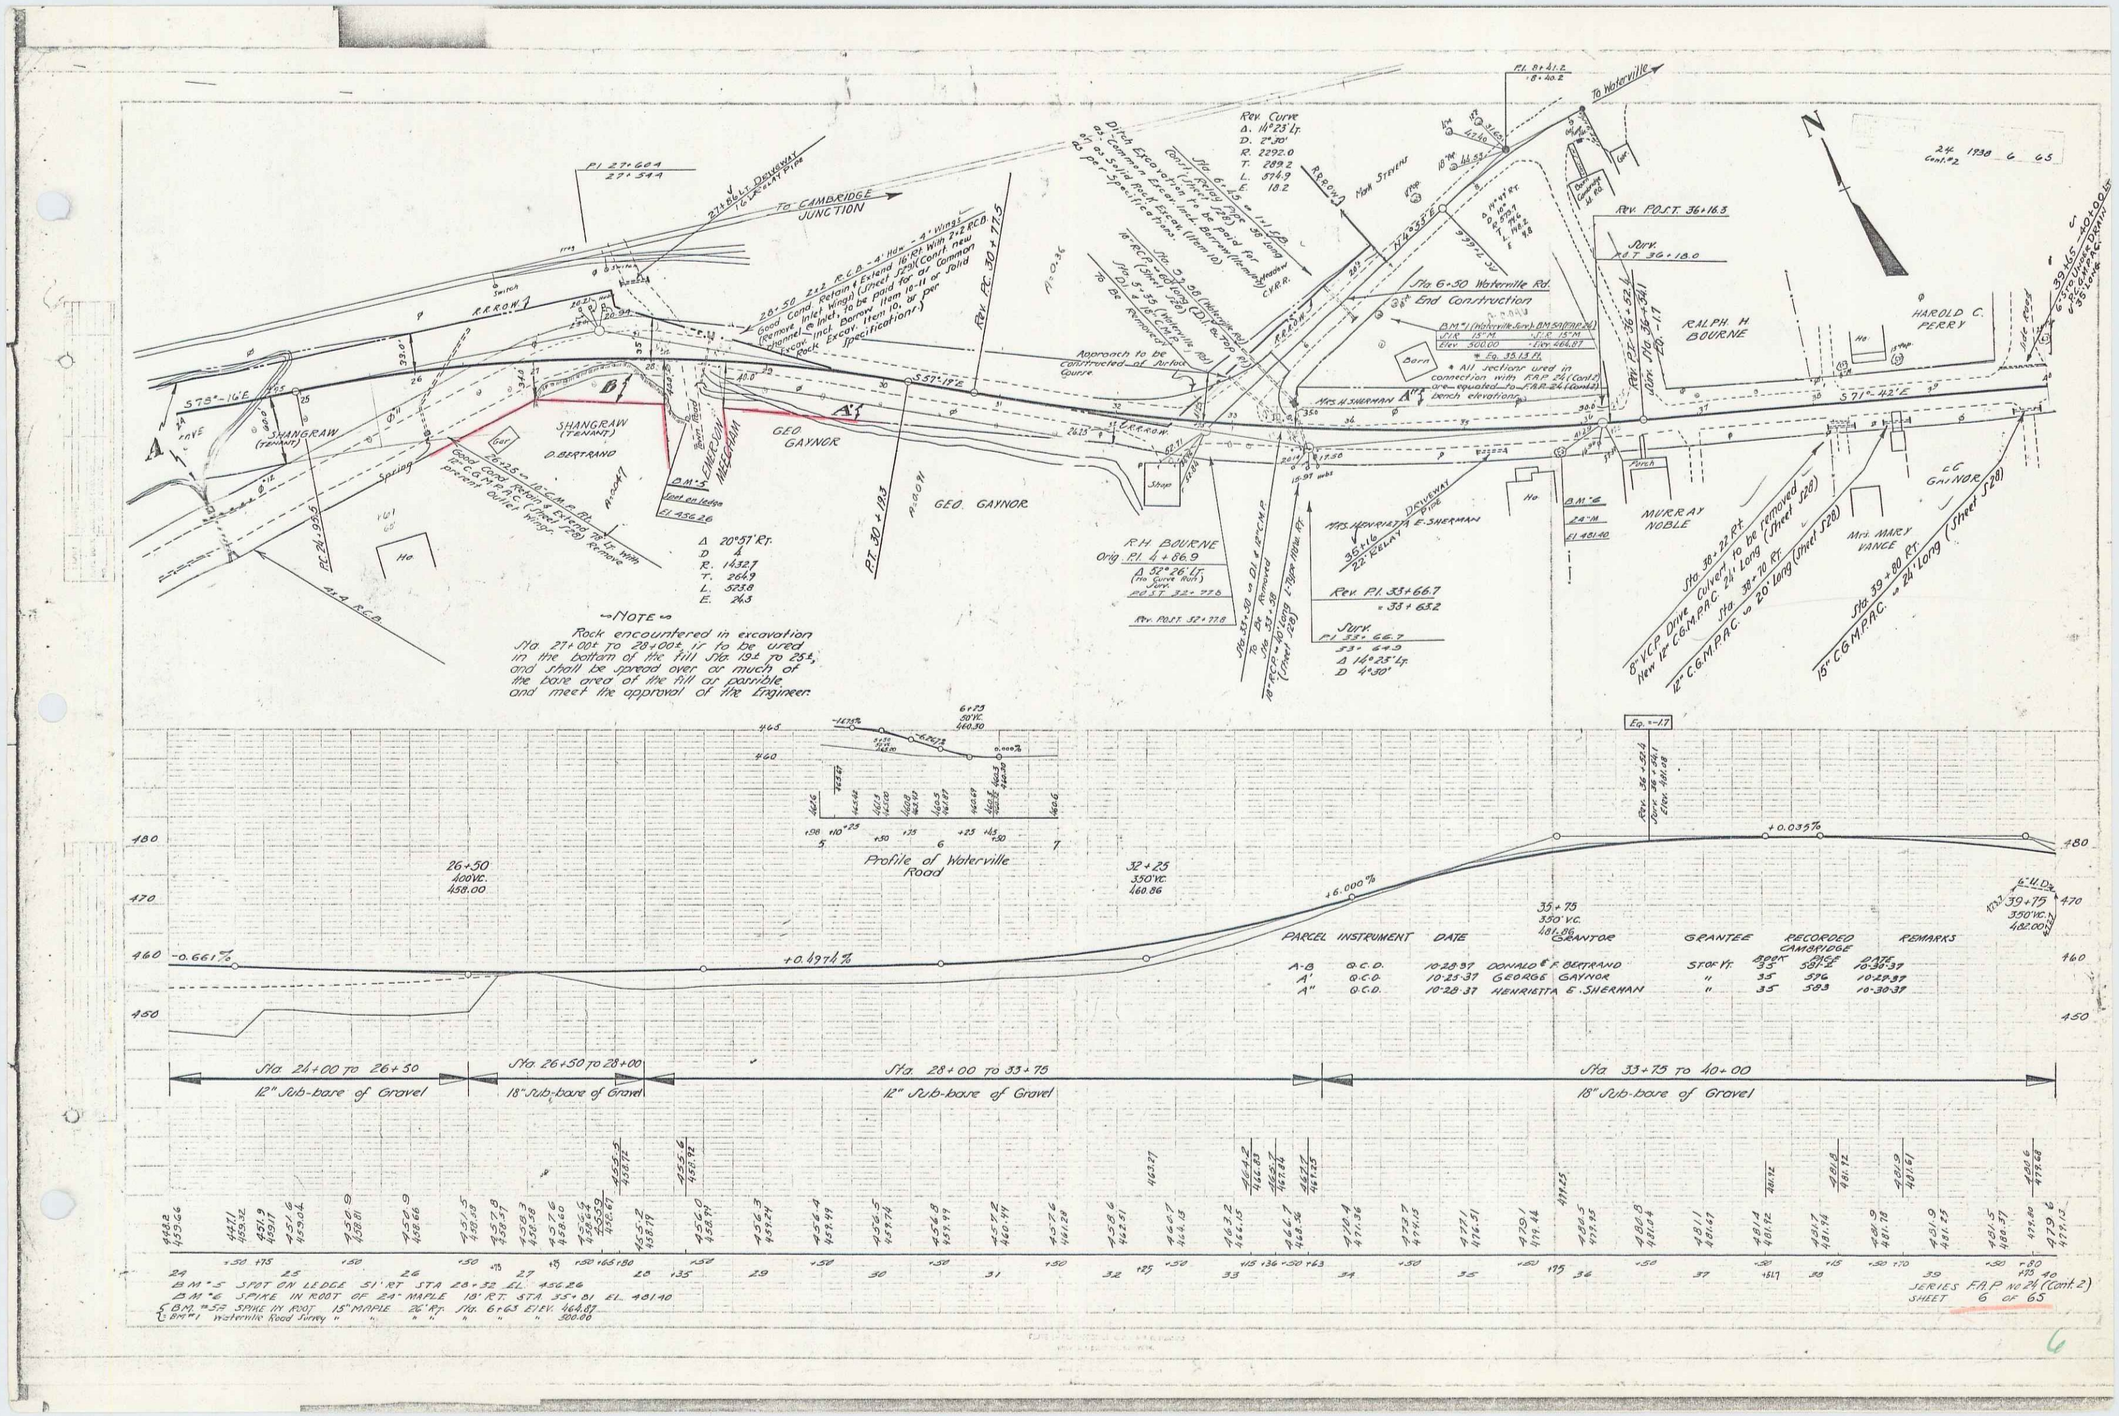
To CAMBRIDGE JUNCTION
To Waterville
Sta 6+50 Waterville Rd. End Construction
RALPH H BOURNE
HAROLD C. PERRY
MURRAY NOBLE
Mrs. MARY VANCE
C.C. GAYNOR
GEO. GAYNOR
SHANGRAW (TENANT)
D. BERTRAND
R.H. BOURNE
Profile of Waterville Road
PARCEL INSTRUMENT DATE GRANTOR GRANTEE RECORDED CAMBRIDGE REMARKS
A-B Q.C.D. 10-28-37 DONALD E. F. BERTRAND Stor Yr. Book 35 Page 587-2 Date 10-30-37
A' Q.C.D. 10-29-37 GEORGE GAYNOR " 35 576 10-29-37
A'' Q.C.D. 10-28-37 HENRIETTA E. SHERMAN " 35 583 10-30-37
Sta 24+00 to 26+50 12" Sub-base of Gravel
Sta 26+50 to 28+00 18" Sub-base of Gravel
Sta 28+00 to 33+75 12" Sub-base of Gravel
Sta 33+75 to 40+00 18" Sub-base of Gravel
BM #5 SPOT ON LEDGE 51' RT STA 28+32 EL. 456.26
BM #6 SPIKE IN ROOT OF 24" MAPLE 18' RT. STA 35+81 EL. 481.40
BM #52 SPIKE IN ROOT 15" MAPLE 26' Rt. Sta. 6+65 ELEV. 464.87
BM #1 Waterville Road Survey " " " " " " 300.00
SERIES F.A.P. No 24 (Cont. 2)
SHEET 6 OF 65