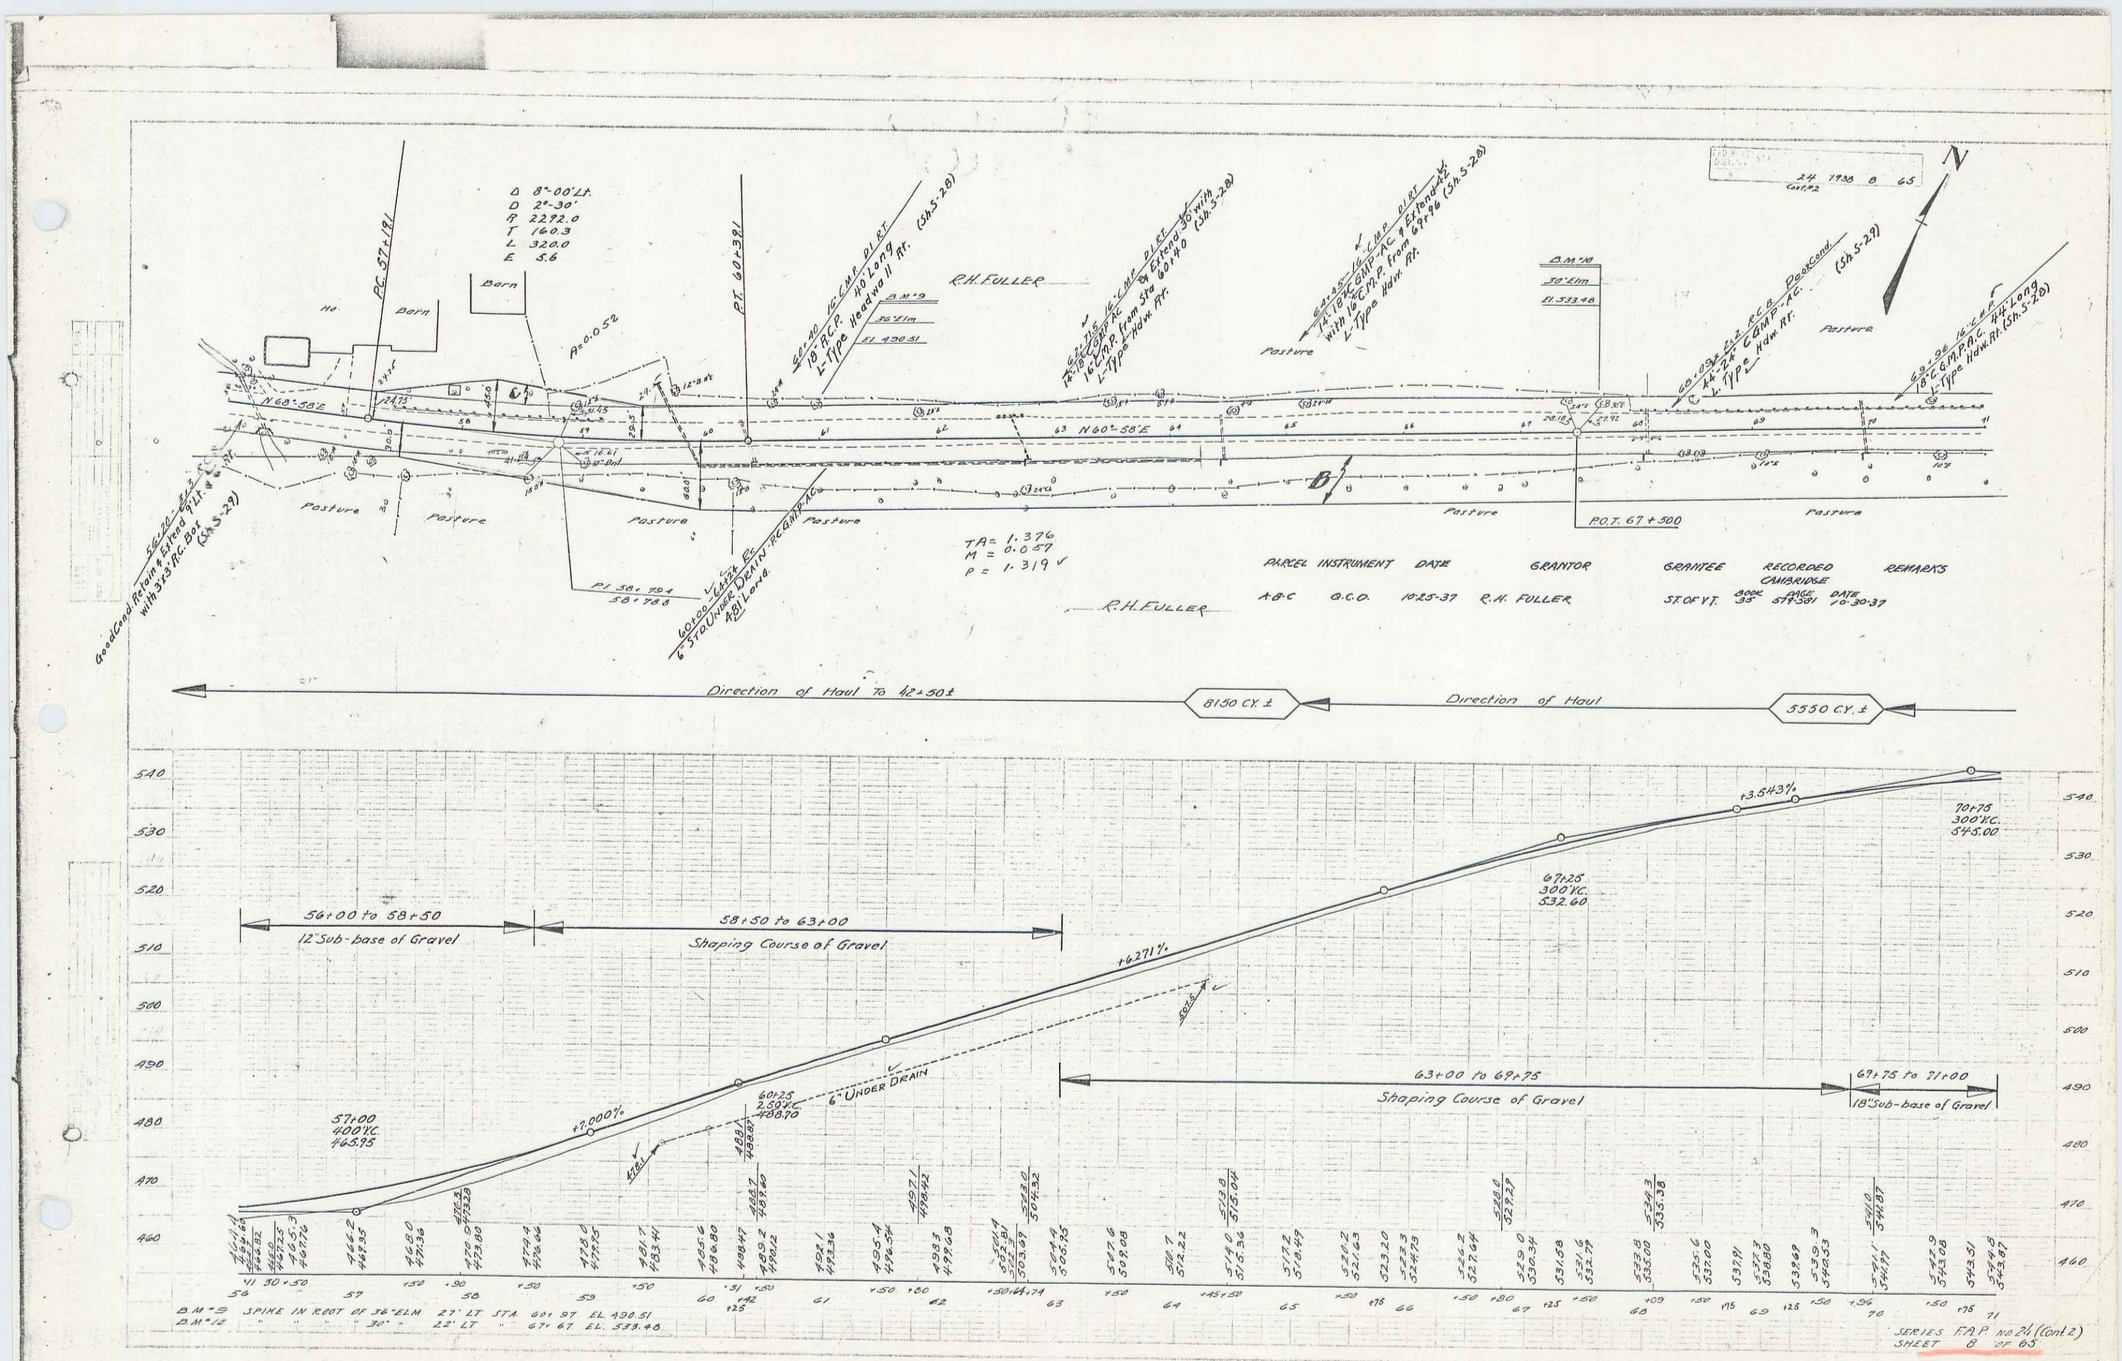
D 8°-00' Lt.
Δ 2°-30'
R 22.92.0
T 160.3
L 320.0
E 5.6
PC. 57+18
PT. 60+38
R.H. FULLER
Barn
Pasture
N 60°-58'E
P.O.T. 67+50
TA = 1.376
M = 0.057
P = 1.319
PARCEL INSTRUMENT DATE GRANTOR GRANTEE RECORDED REMARKS
A-B-C Q.C.D. 10-25-37 R.H. FULLER ST. OF VT.
CAMBRIDGE BOOK 35 PAGE 577-581 DATE 10-30-37
Direction of Haul To 42+50±
8150 CY. ±
Direction of Haul
3550 CY. ±
56+00 to 58+50
12" Sub-base of Gravel
58+50 to 63+00
Shaping Course of Gravel
63+00 to 69+75
Shaping Course of Gravel
69+75 to 71+00
18" Sub-base of Gravel
57+00
400' V.C.
465.95
+7.000%
60+25
2.50' V.C.
488.70
6" UNDER DRAIN
+6.271%
67+25
300' V.C.
532.60
+3.543%
70+75
300' V.C.
543.00
BM #9 SPIKE IN ROOT OF 36" ELM 27' LT STA. 60+97 EL. 490.51
BM #12 " " " " 30" " 22' LT " 67+67 EL. 539.48
SERIES F.A.P. No. 24 (Cont 2)
SHEET 8 OF 65

8