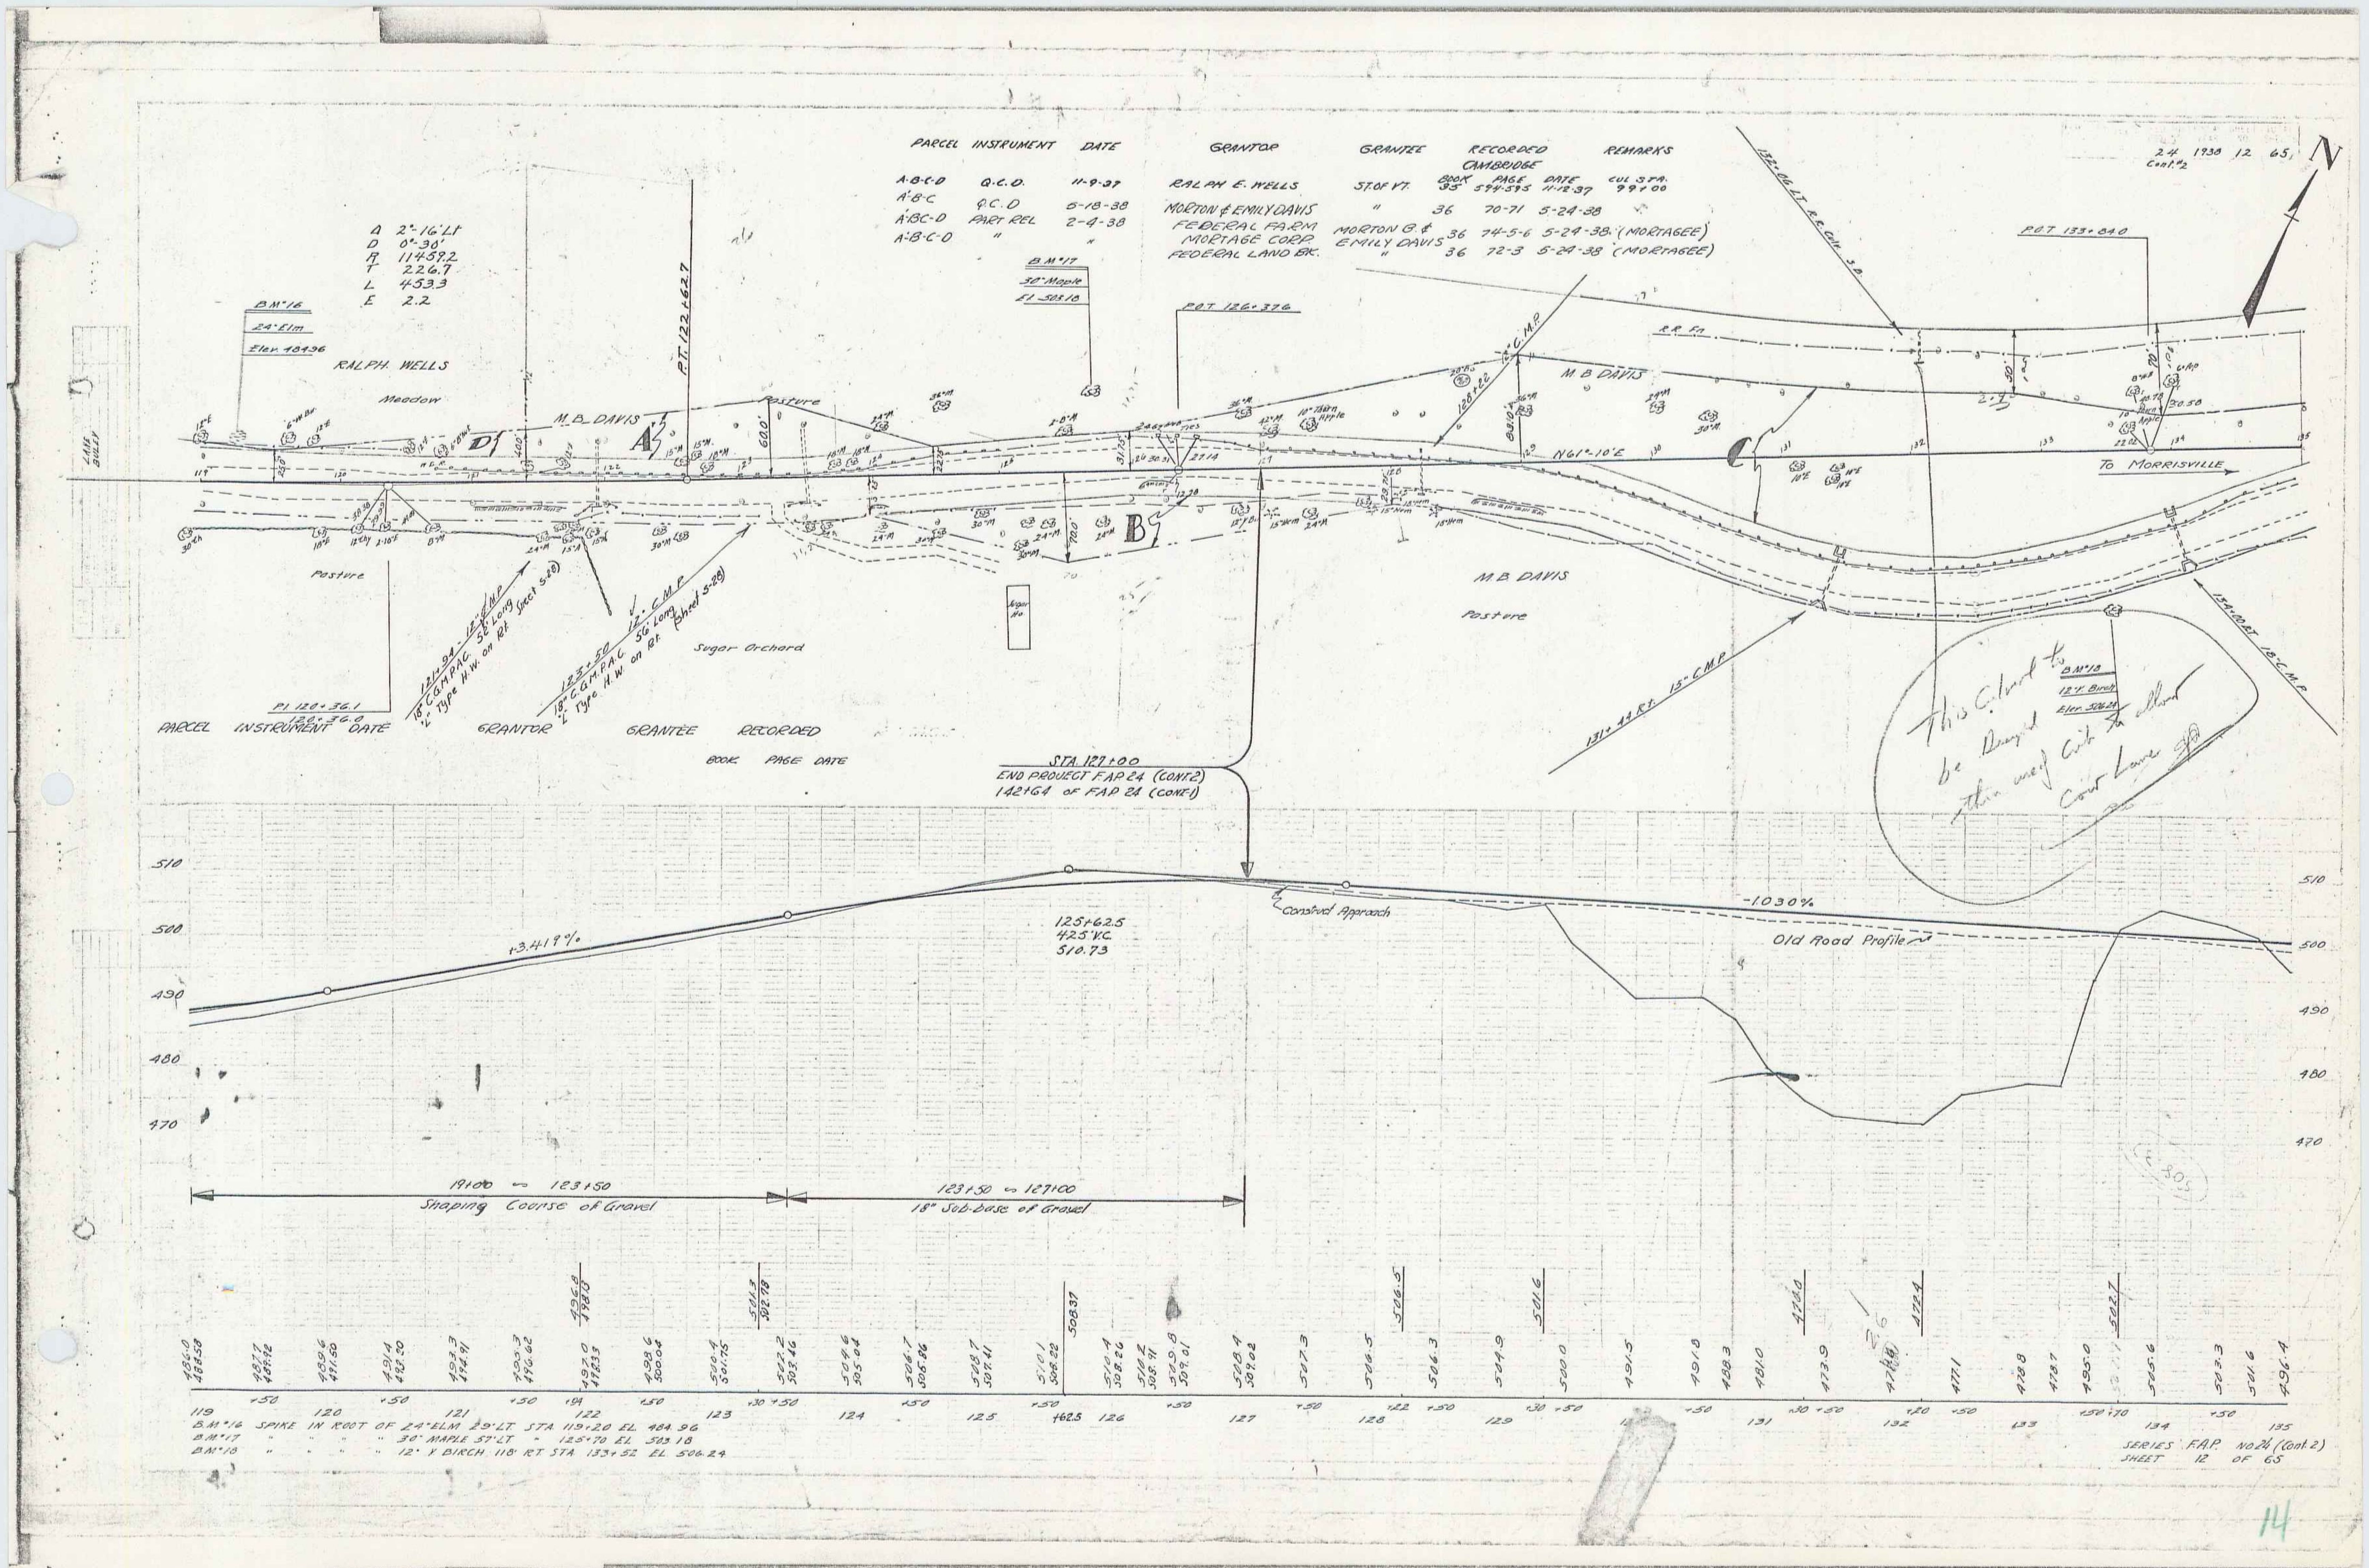
PARCEL INSTRUMENT DATE GRANTOR GRANTEE RECORDED REMARKS
CAMBRIDGE
BOOK PAGE DATE
A-B-C-D Q.C.D. 11-9-37 RALPH E. WELLS ST. OF VT. 35 594-595 11-12-37 CUL STA. 99+00
A'-B-C Q.C.D 5-18-38 MORTON & EMILY DAVIS " 36 70-71 5-24-38
A'-BC-D PART REL 2-4-38 FEDERAL FARM MORTAGE CORP. MORTON B. & EMILY DAVIS 36 74-5-6 5-24-38 (MORTAGEE)
A'-B-C-D " " FEDERAL LAND BK. " 36 72-3 5-24-38 (MORTAGEE)
Δ 2°-16' Lt
D 0°-30'
R 11459.2
T 226.7
L 453.3
E 2.2
B.M.#16
24" Elm
Elev. 484.96
B.M.#17
30" Maple
El. 503.18
P.T. 122+62.7
P.O.T. 126+37.6
P.O.T. 133+84.0
RALPH WELLS
Meadow
M.B. DAVIS
Pasture
Sugar Orchard
N 61°-10' E
To MORRISVILLE
PARCEL INSTRUMENT DATE GRANTOR GRANTEE RECORDED
BOOK PAGE DATE
STA 127+00
END PROJECT F.A.P. 24 (CONT 2)
142+64 of F.A.P. 24 (CONT 1)
125+62.5
425' V.C.
510.73
+3.419%
-1.030%
Constr'd Approach
Old Road Profile
119+00 — 123+50
Shaping Course of Gravel
123+50 — 127+00
18" Sub-base of Gravel
B.M.#16 SPIKE IN ROOT OF 24" ELM 29' LT STA 119+20 EL 484.96
B.M.#17 " " " " 30" MAPLE 57' LT " 125+70 EL 503.18
B.M.#18 " " " " 12" Y BIRCH 118' RT STA 133+52 EL 506.24
SERIES F.A.P. No 24 (Cont 2)
SHEET 12 OF 65
14