FEDERAL DIST. No.	STATE	FEDERAL PROJ. No.	FISCAL YEAR	SHEET No.	TOTAL SHEETS
9	VT	24	1920	7	38

GUARD RAIL REQUIRED

ON LEFT

Sta. 63+00	to Sta. 66+78	Length	378'
Sta. 68+38	to Sta. 68+62	"	24'
Sta. 71+63	to Sta. 71+87	"	24'
Sta. 73+00	to Sta. 74+28	"	128'

ON RIGHT

Sta. 68+38	to Sta. 68+62	"	24'
Sta. 71+63	to Sta. 71+87	"	24'
		Total This Sheet	600'

STONE BASE REQUIRED

Sta. 63+00 to Sta. 71+75 Length 875'

NEW CULVERTS REQUIRED

Sta. 68+50	2'x2' Concrete	32'	
	1-2-4 Concrete	6.78	Cu. Yds.
	1-3-6 "	6.81	" "
Sta. 71+75	3'x3' Concrete	26'	
	1-2-4 Concrete	7.06	Cu. Yds.
	1-3-6 "	10.81	" "

CULVERT REPAIRS REQUIRED

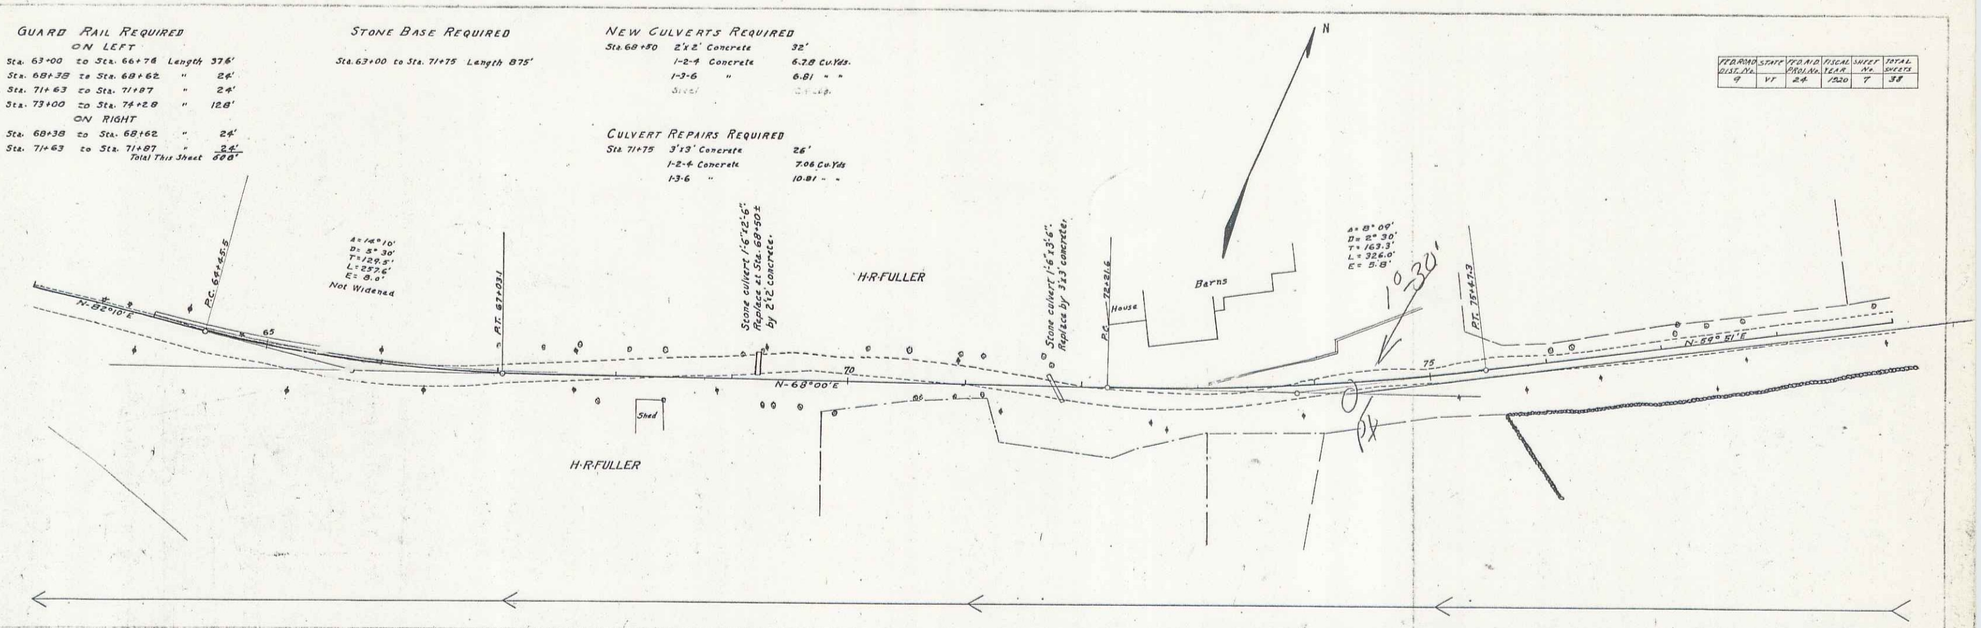

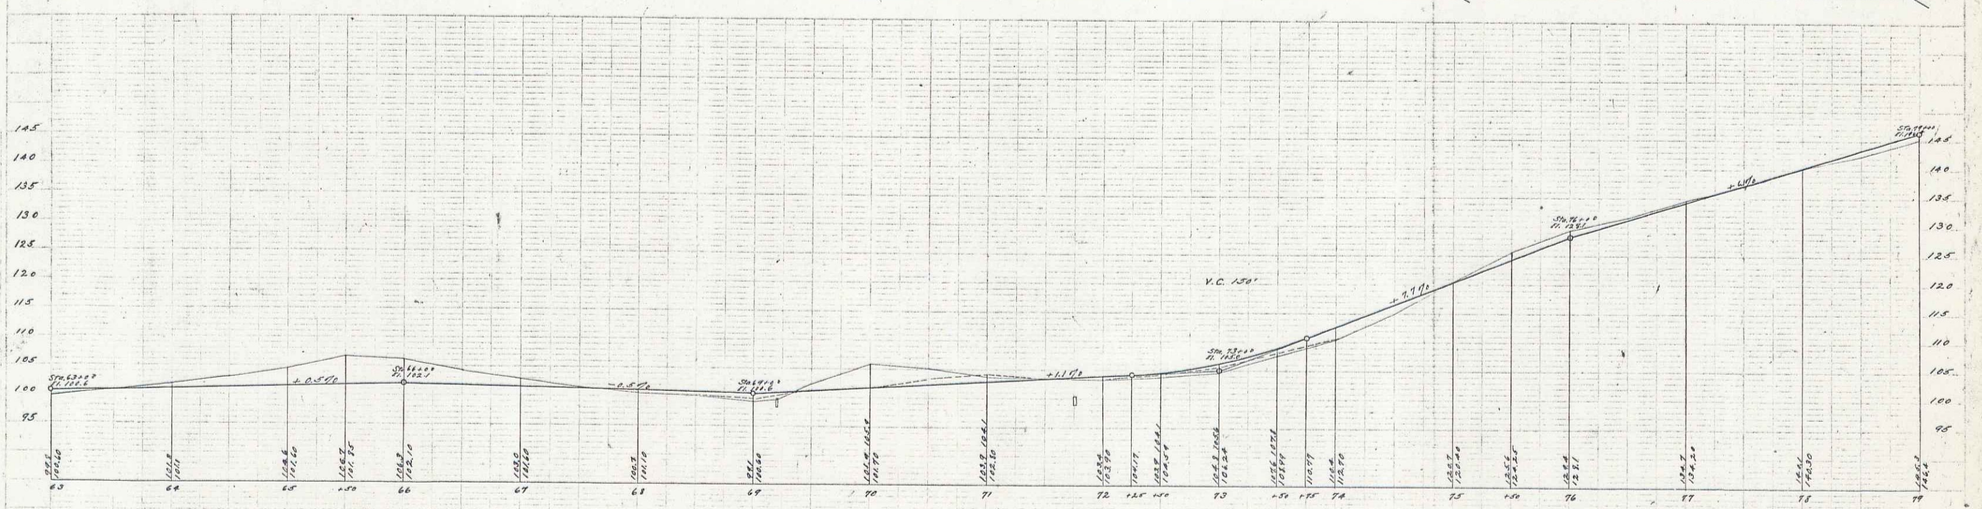

B. M. Top of Post North of Sta. 64+80 Elev. 103.93
B. M. Spike in Tel. Pole South of Sta. 72+75 Elev. 108.01

E. R. Welch
R. A. Gammell 5/1/20
F. A. Dunkley

Series F No. 24 Fed.
Sheet 7 of 38

19