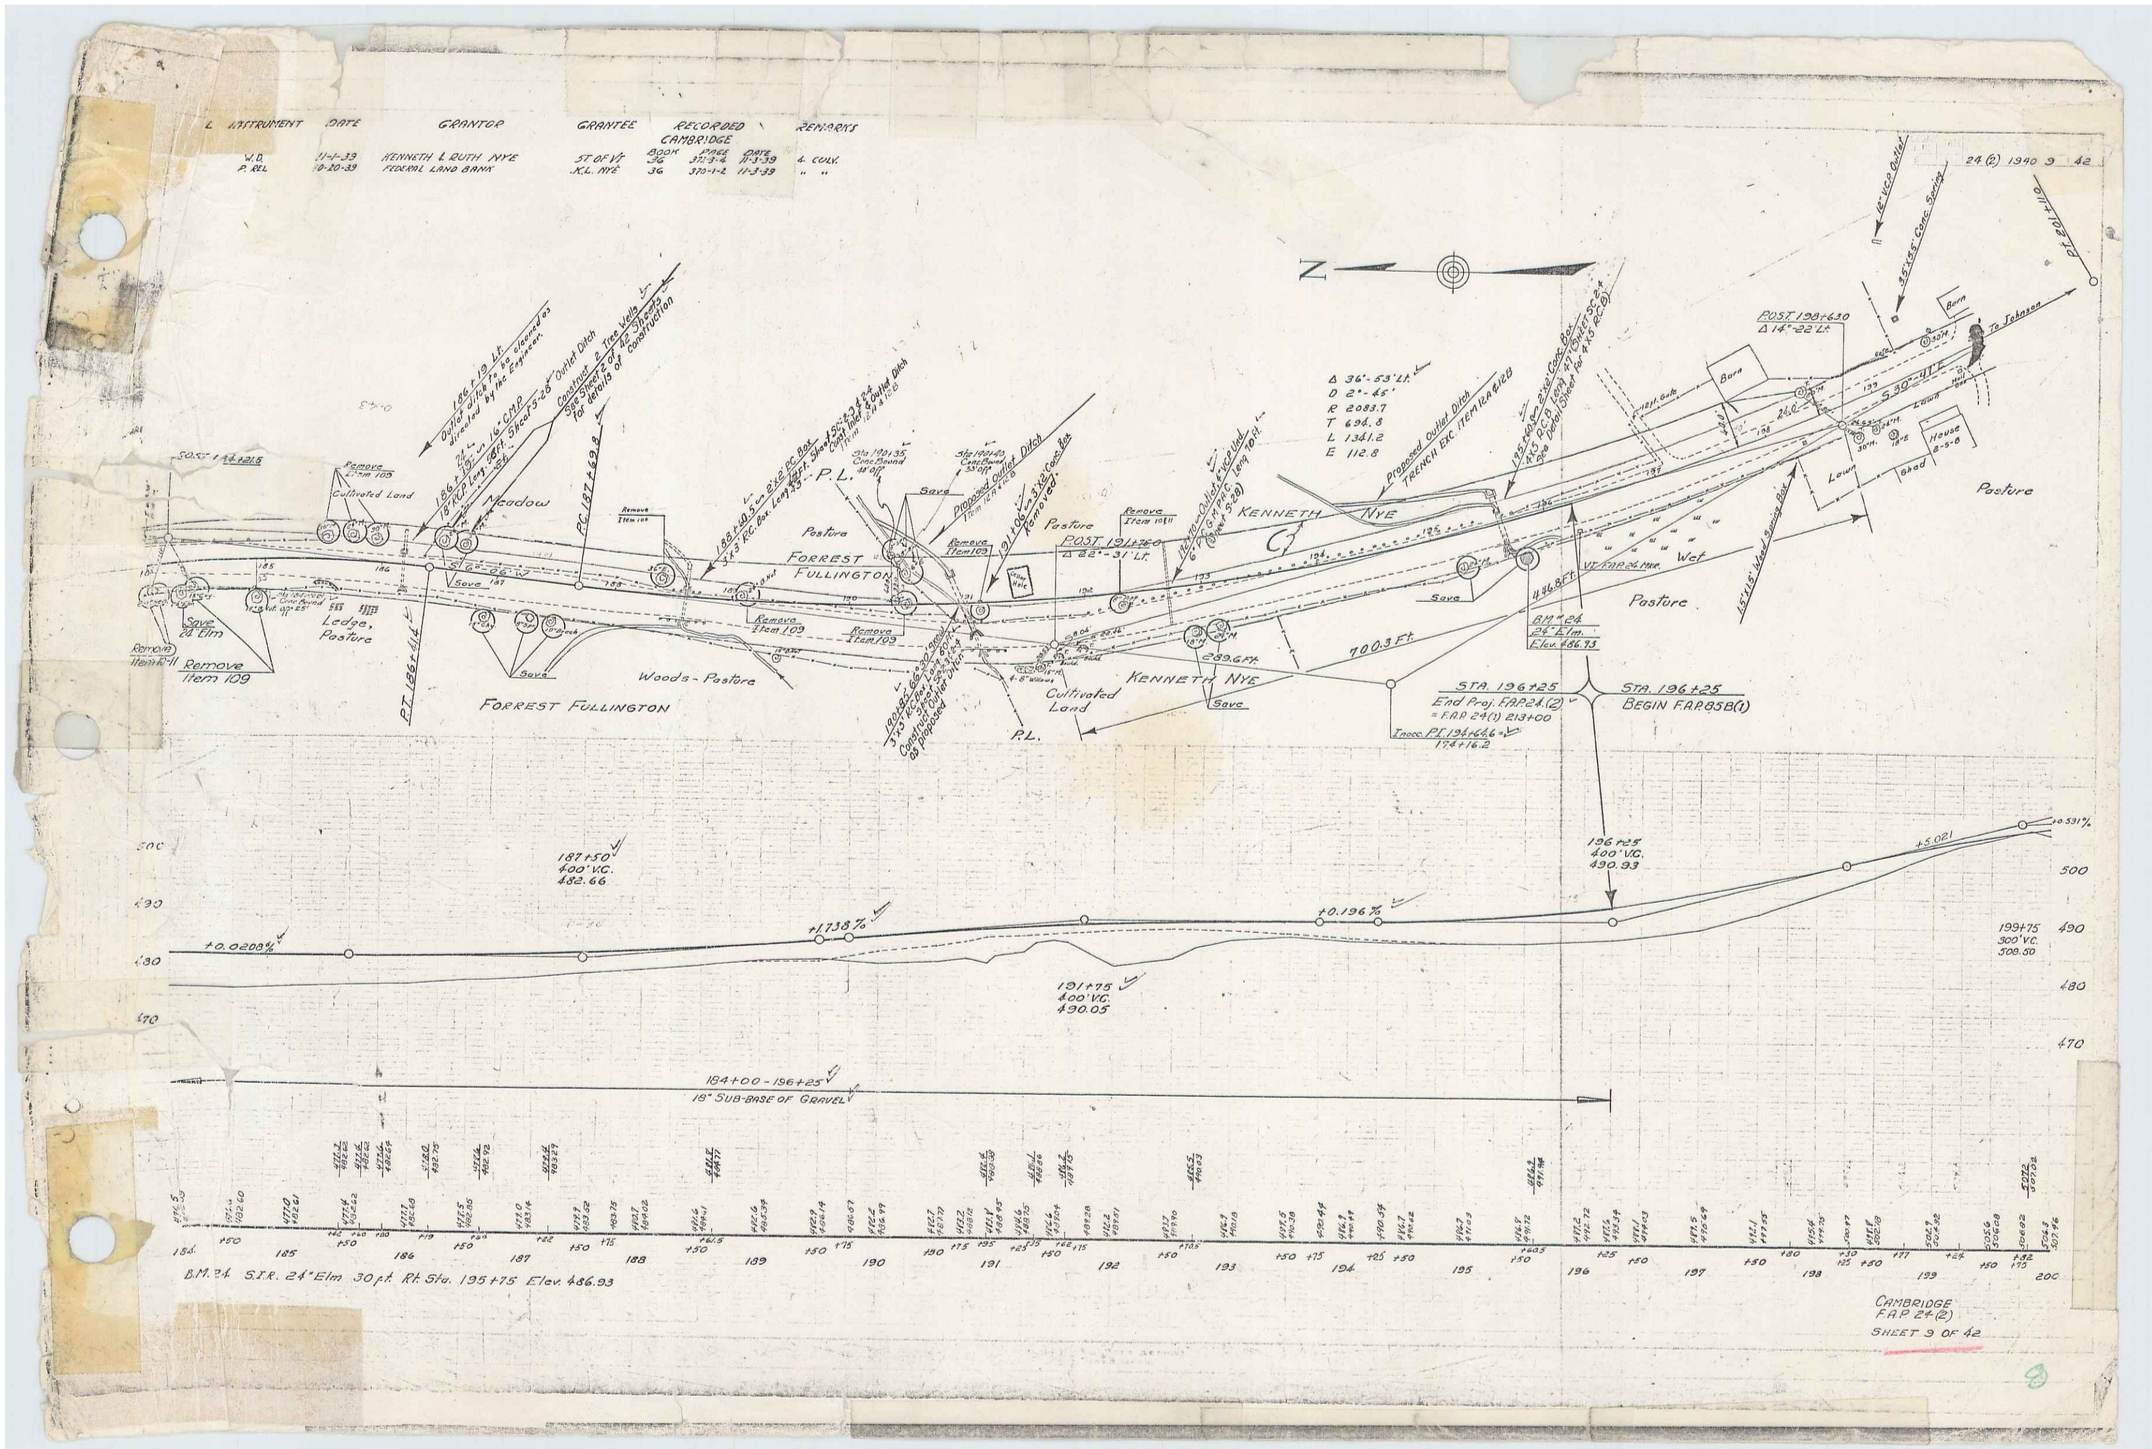
INSTRUMENT DATE GRANTOR GRANTEE RECORDED REMARKS
CAMBRIDGE
W.D. 11-1-39 KENNETH & RUTH NYE ST OF VT 36 371-3-4 11-3-39 & COUN.
P. REL 10-20-39 FEDERAL LAND BANK K.L. NYE 36 370-1-2 11-3-39 " "
24 (2) 1940 9 42
Z
Δ 36°-53' Lt.
D 2°-45'
R 2083.7
T 694.8
L 1341.2
E 112.8
POST 198+630
Δ 14°-22' Lt.
POST 191+260
Δ 22°-31' Lt.
P.L.
KENNETH NYE
FORREST FULLINGTON
Pasture
Meadow
Cultivated Land
Woods - Pasture
Ledge, Pasture
Lawn
House
Barn
To Johnson
Proposed Outlet Ditch
TRENCH EXC. ITEM R&B 12.8
Remove Item 109
Save
Save 24" Elm
Remove Item 109
PC 187+69.8
PT 186+41.4
STA. 196+25
End Proj. F.A.P. 24 (2)
= F.A.P. 24 (1) 213+00
Incorr. PC 194+66.6 = 174+16.2
STA. 196+25
BEGIN F.A.P. 85B(1)
B.M. 24
24" Elm.
Elev. 486.73
700.3 Ft.
289.6 Ft.
446.8 Ft.
187+50
400' V.C.
482.66
191+75
400' V.C.
490.05
196+25
400' V.C.
490.93
199+75
300' V.C.
500.50
+0.0208%
+1.738%
+0.196%
+5.021
+0.531%
184+00 - 196+25
18" SUB-BASE OF GRAVEL
B.M. 24 S.I.R. 24" Elm 30 ft. Rt. Sta. 195+75 Elev. 486.93
CAMBRIDGE
F.A.P. 24 (2)
SHEET 9 OF 42