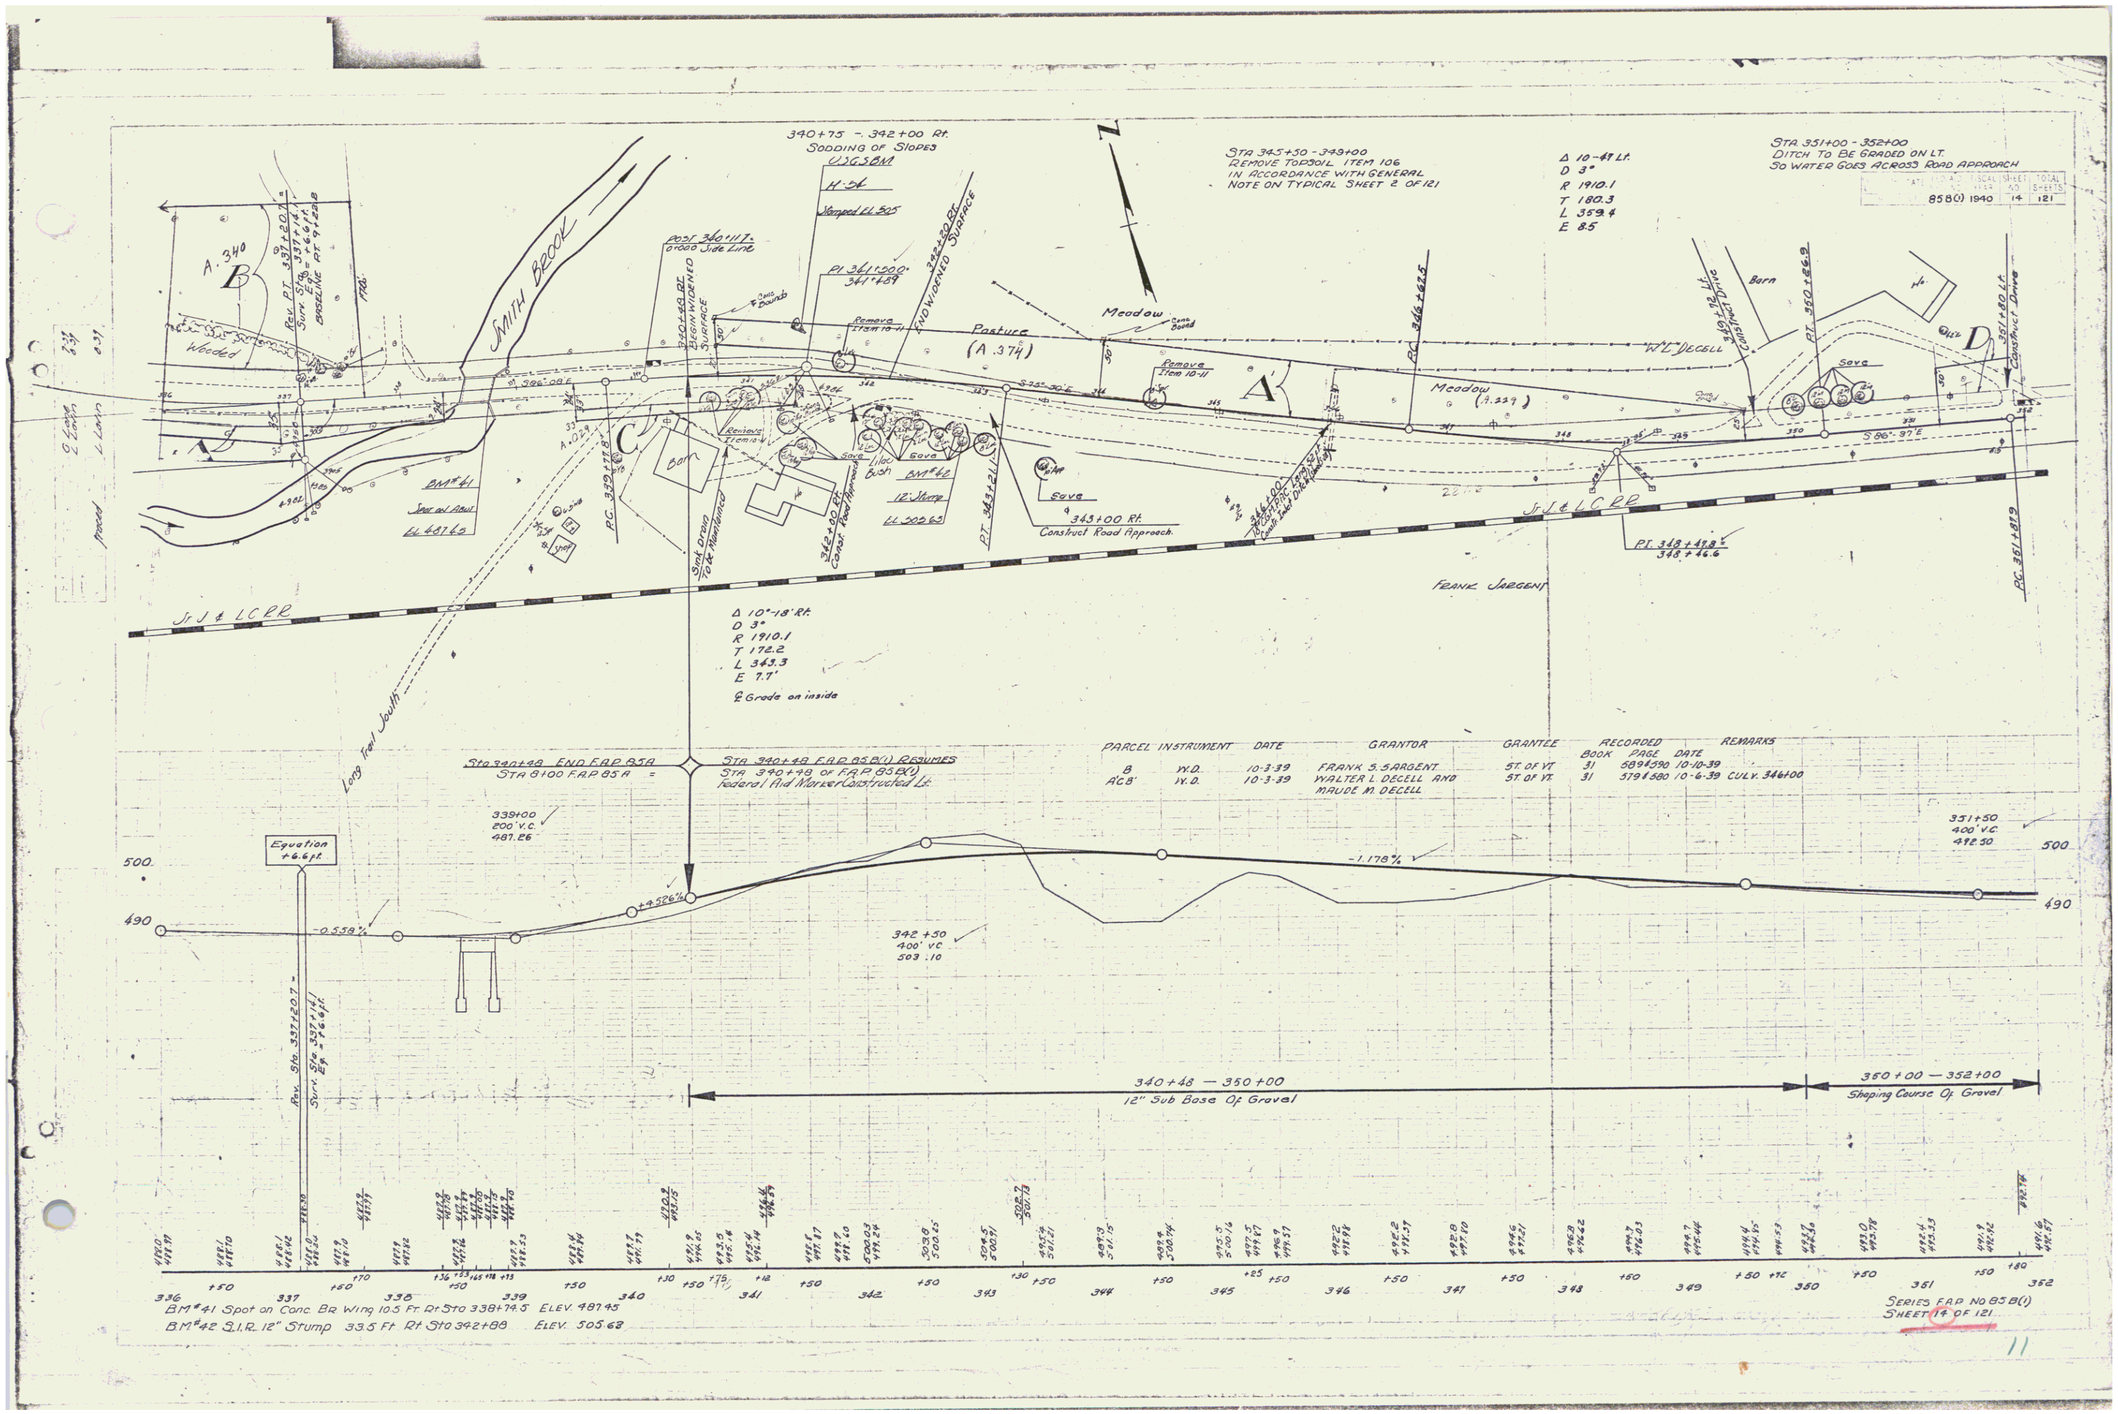

STA 343+50 - 343+00
REMOVE TOPSOIL ITEM 106
IN ACCORDANCE WITH GENERAL
NOTE ON TYPICAL SHEET 2 OF 121

Δ 10°-48' Lt.
D 3°
R 1910.1
T 180.3
L 359.4
E 8.5

STA 351+00 - 352+00
DITCH TO BE GRADED ON LT.
SO WATER GOES ACROSS ROAD APPROACH

Δ 10°-18' Rt.
D 3°
R 1910.1
T 172.2
L 343.3
E 7.7'
℄ Grade on inside

PARCEL	INSTRUMENT	DATE	GRANTOR	GRANTEE	RECORDED BOOK	RECORDED PAGE	RECORDED DATE	REMARKS
B	W.D.	10-3-39	FRANK S. SARGENT	ST. OF VT	31	589 & 590	10-10-39	
ACB'	W.D.	10-3-39	WALTER L. DECELL AND MAUDE M. DECELL	ST. OF VT	31	579 & 580	10-6-39	CULV. 346+00

	SCALE	SHEET	TOTAL
858(1) 1940		14	121