F.A.P. 133-B Cable Guard Rail				
Station	Station	Lt.	Rt.	Anchors
117+00	126+16		2	2

F.A.P. 133-B Guide Posts		
Station	Lt.	Rt.
117+00	7	-
126+20	7	7

Rd. Aid
133-B 1936 8 15

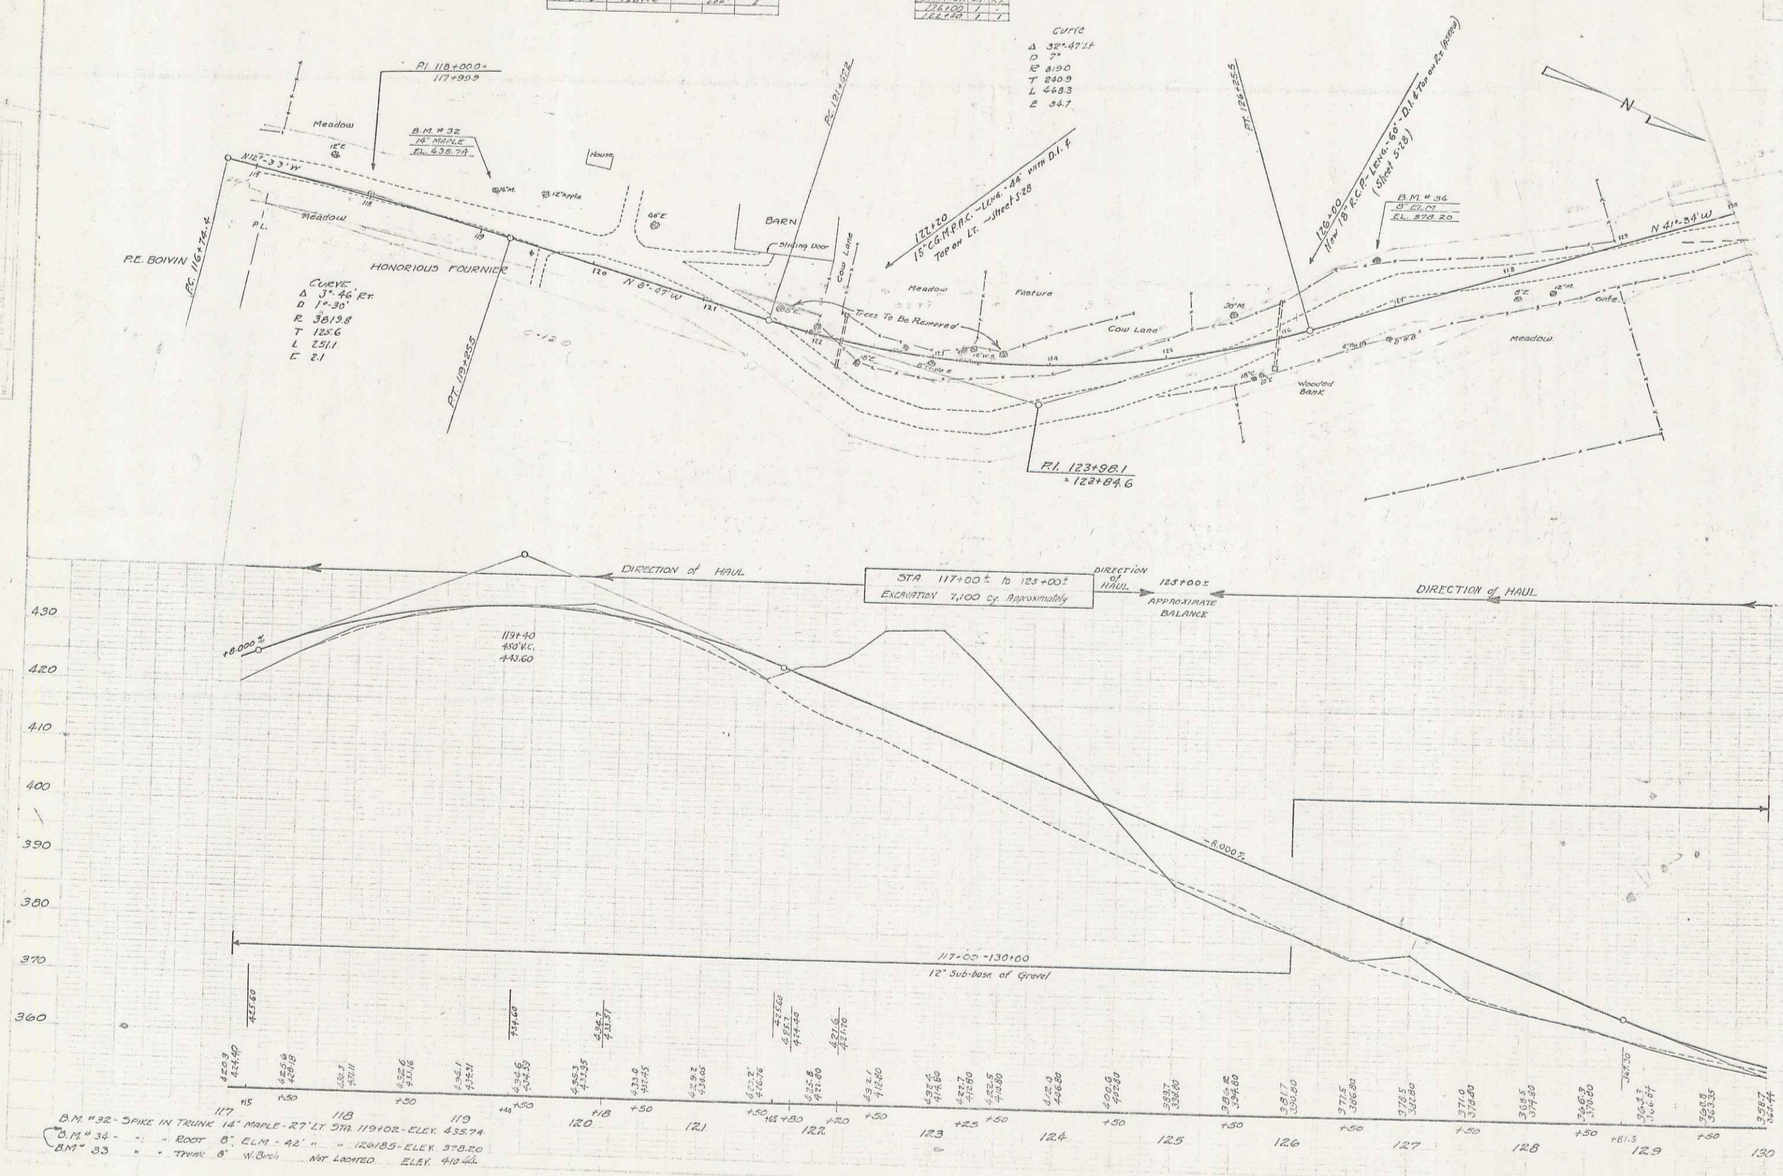

SERIES F.A.P. NO. 133-B
SHEET 8 OF 15-16