FED. ROAD DIST. NO.	STATE	NBS PROJ. NO.	FISCAL YEAR	SHEET NO.	TOTAL SHEETS
9	VT.	149-B			

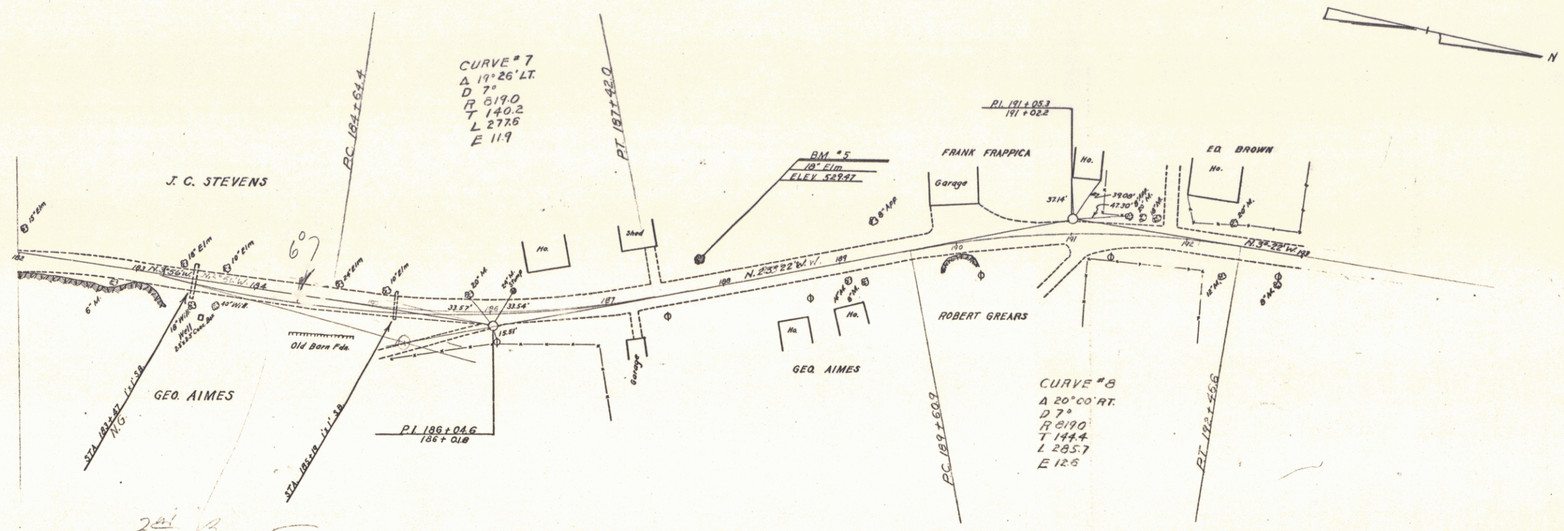

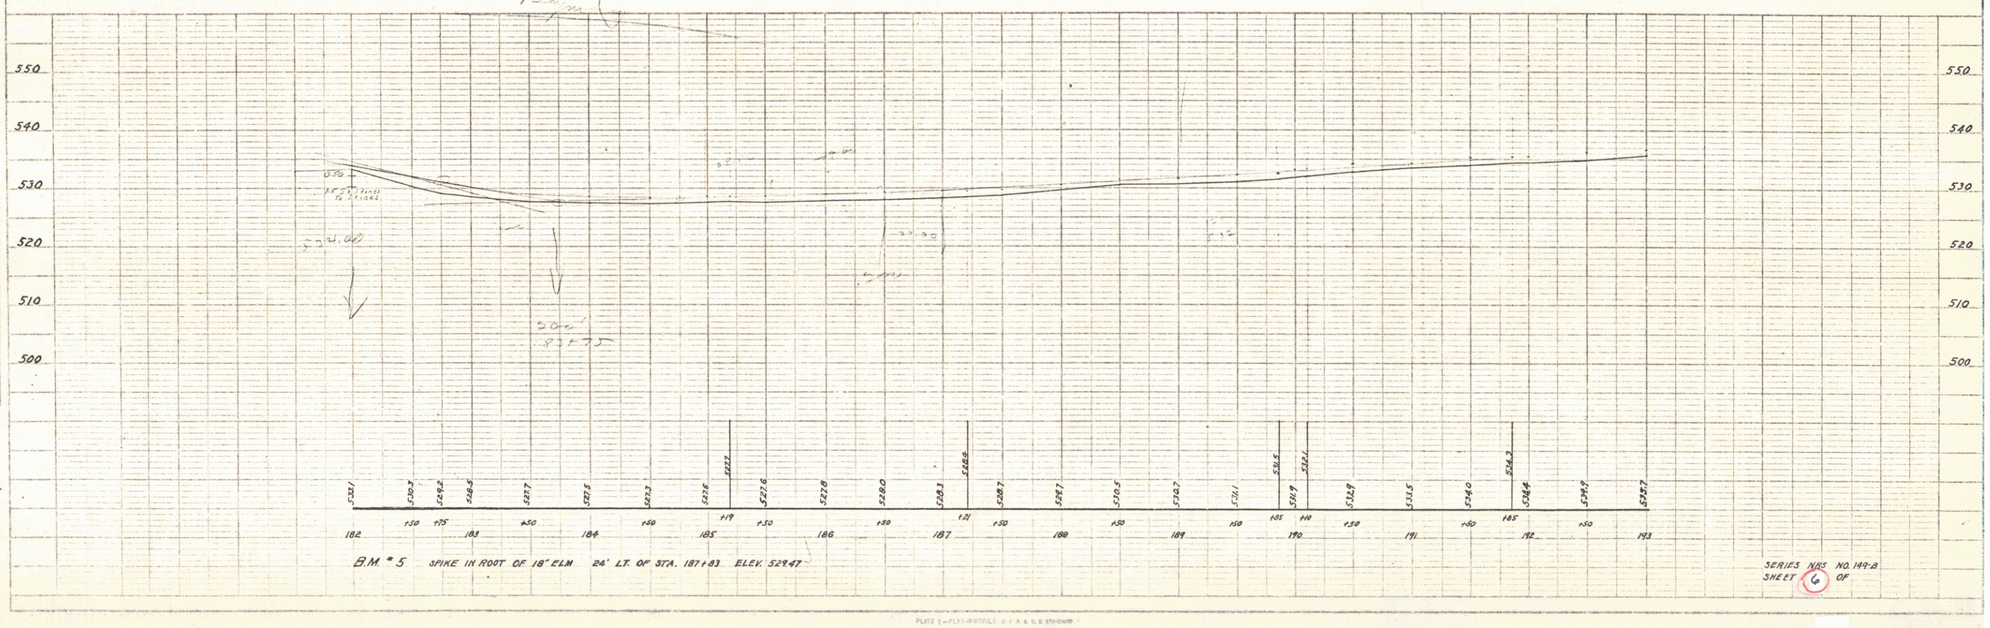

B.M. #5 SPIKE IN ROOT OF 18" ELM 24' LT. OF STA. 187+83 ELEV. 529.47

SERIES NBS NO. 149-B
SHEET 6 OF

PLATE I—PLAN-PROFILE O.P.R.&G.E. STANDARD
MOUTTET & FISHER CO. NEW YORK

4 BRADFORD