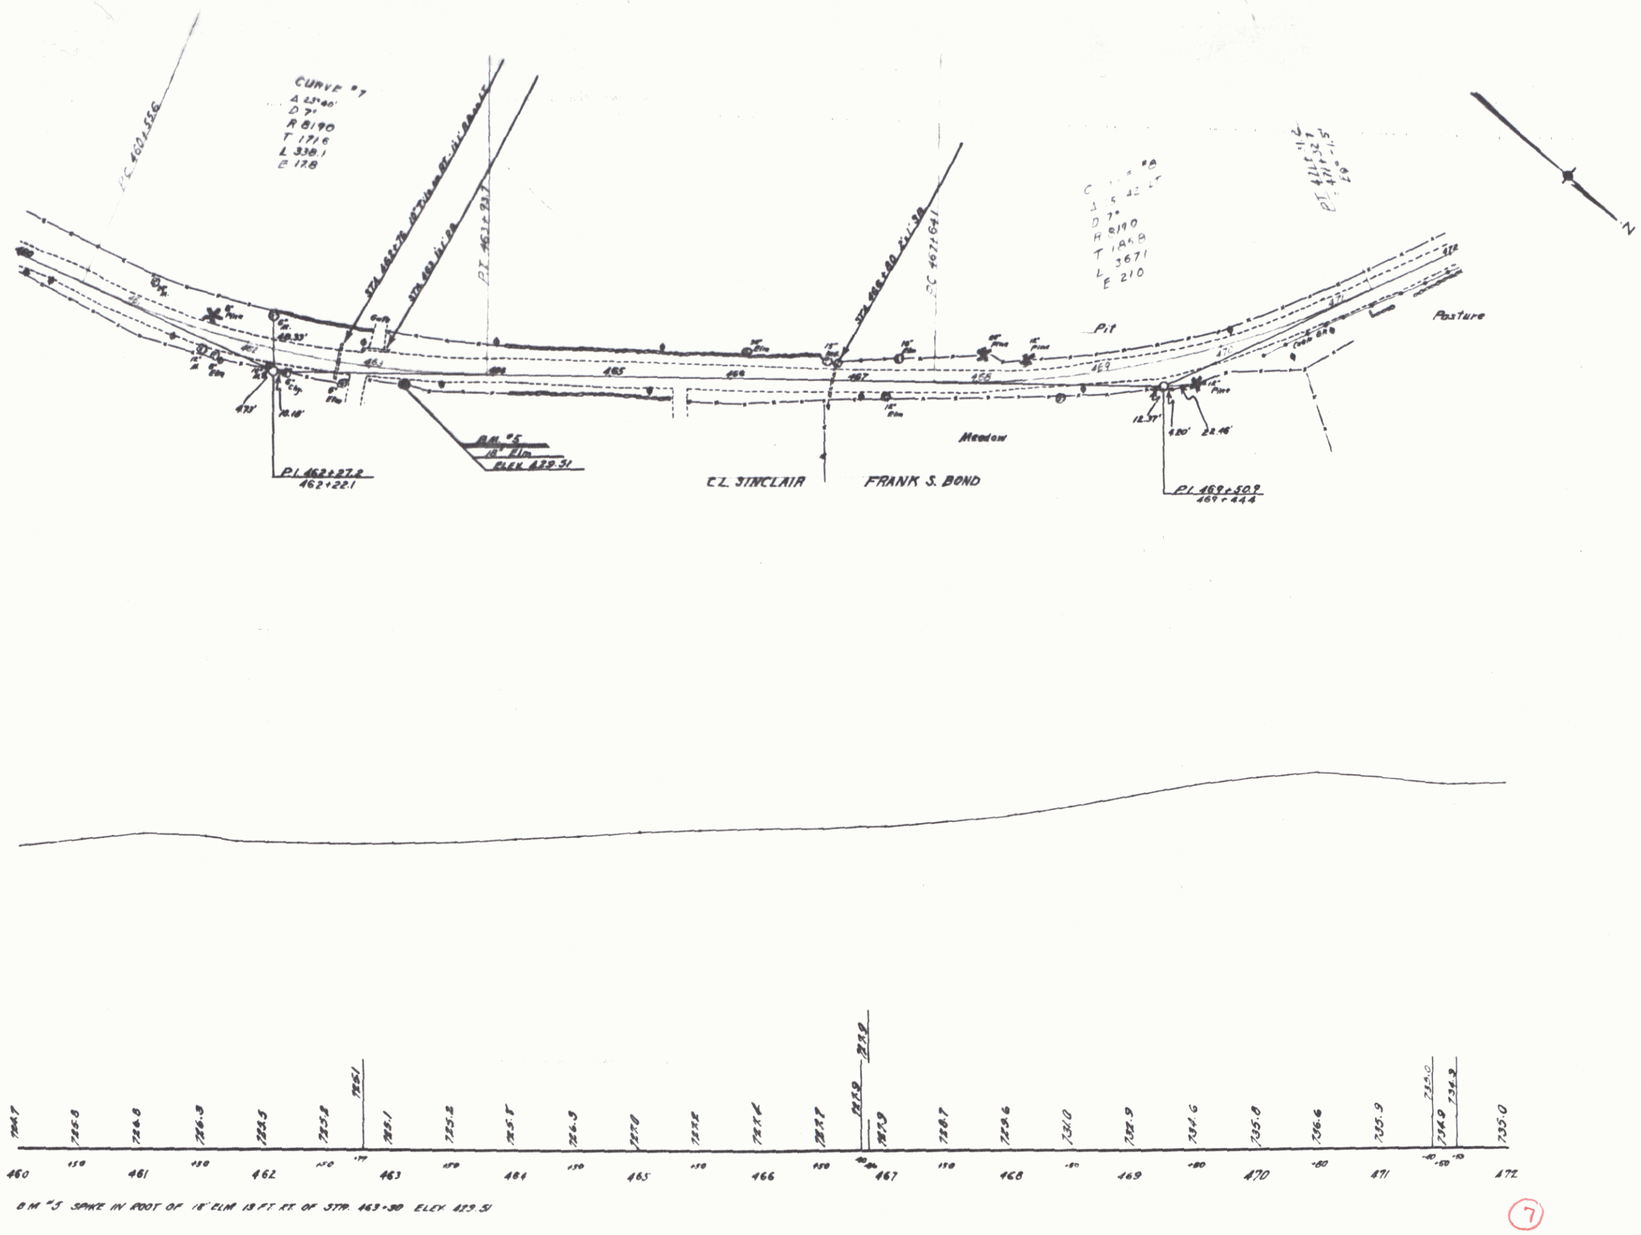
CURVE #7
A 43°40'
D 7°
R 8190
T 1716
L 3381
E 178
P.C. 461+56
P.T. 463+93
P.C. 467+64
Pit
Pasture
Meadow
C.L. SINCLAIR
FRANK S. BOND
P.I. 462+27.2
462+22.1
P.I. 469+50.9
469+44.4
B.M. #5
18" Elm
ELEV. 429.51
740
730
720
460
461
462
463
464
465
466
467
468
469
470
471
472
B.M. #5 SPIKE IN ROOT OF 18" ELM 18 FT. RT. OF STA. 463+30 ELEV. 429.51

7

5 COMINTH-