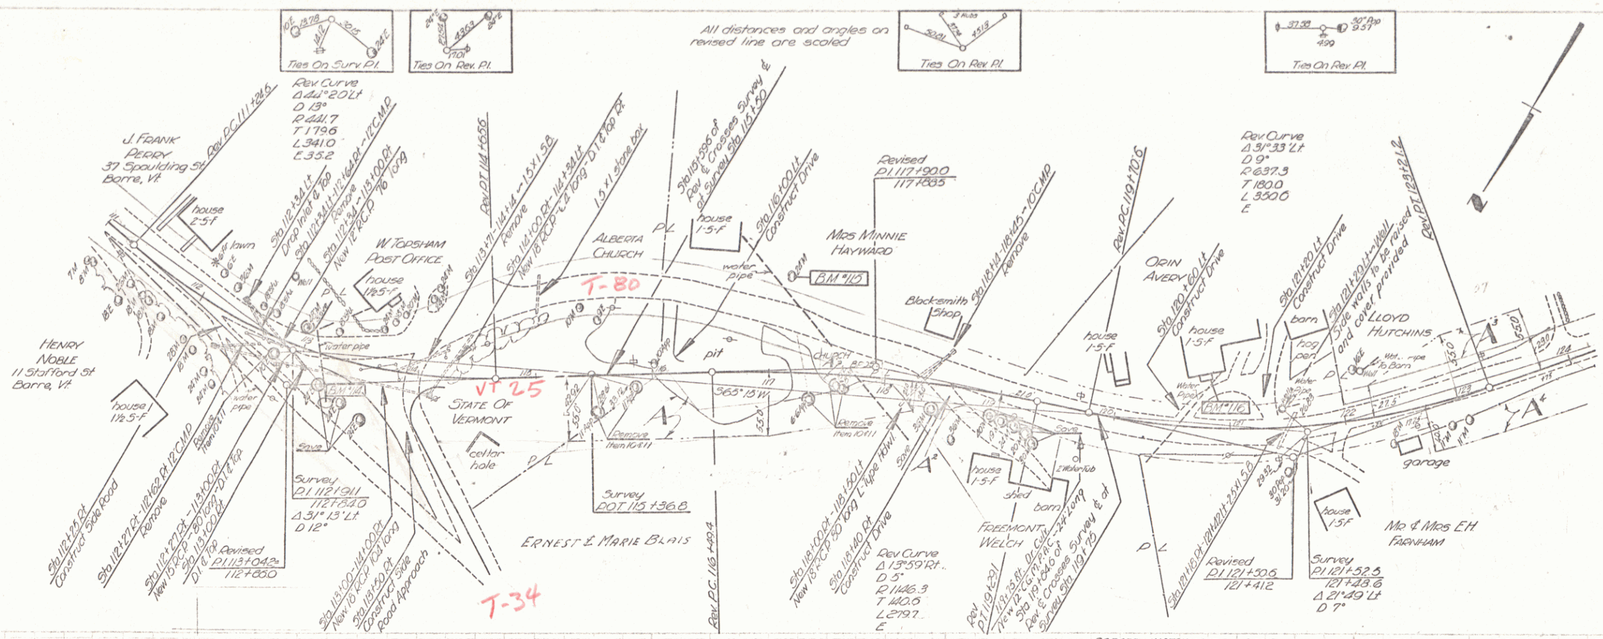
Ties On Surv. P.I.
Ties On Rev. P.I.
All distances and angles on revised line are scaled
Ties On Rev. P.I.
Ties On Rev. P.I.
J. FRANK PERRY
37 Spaulding St
Barre, Vt
HENRY NOBLE
11 Stafford St
Barre, Vt
W. TOPSHAM POST OFFICE
ALBERTA CHURCH
MRS MINNIE HAYWARD
Blacksmith Shop
ODIN AVERY
LLOYD HUTCHINS
STATE OF VERMONT
cellar hole
ERNEST & MARIE BLAIS
FREEMONT WELCH
MR & MRS E.H. FARNHAM
garage
T-80
T-34
VT 25
Rev. Curve
Δ 4d°20' Lt
D 13°
R 441.7
T 179.6
L 341.0
E 35.2
Revised
P.I. 117+90.0
117+88.3
Rev. Curve
Δ 31°33' Lt
D 9°
R 637.3
T 180.0
L 350.0
E
Rev. Curve
Δ 13°59' Rt.
D 5°
R 1146.3
T 140.6
L 279.7
E
Revised
P.I. 121+30.6
121+41.2
Survey
P.I. 121+52.5
121+28.8
Δ 21°29' Lt
D 7°
Survey
P.I. 112+82.0
Δ 31°13' Lt
D 12°
Revised
P.I. 113+04.2
112+65.0
Survey
P.O.T. 115+36.8
Rev. P.C. 116+49.4
Rev. P.C. 111+29.6
Rev. P.T. 114+65.5
Rev. P.C. 119+70.6
Rev. P.T. 123+12.2
Rev. P.C. 121+41.4
Rev. P.T. 124+79.1
Sta. 112+35.0 Lt
Construct Side Road
Sta. 112+27.2 - 118+62 Rt 12" CMP
Remove
Sta. 112+72.0 - 113+00.0 Rt
New 15" RCP 90.0' long D.T. & Rip
Sta. 113+00.0 Lt
D.T. & Rip
Sta. 113+00.0 - 114+00.0 Rt
New 18" RCP Rd. Rd.
Sta. 113+00.0 Lt
Construct Side Road Approach
Sta. 113.1+71.1 - 114+14 - 15" x 1.5'
Remove
Sta. 114+00.0 Rt - 114+34 Lt
New 18" RCP - L.A. 10.0' D.T. & Rip Rap
1.5' x 1' Stone box
Sta. 114+00.0 Lt
Construct Drive
Sta. 114.1+48.5 - 118+42.5 - 10" CMP
Remove
Sta. 118+00.0 Rt - 118+40.0 Lt
New 18" RCP 90.0' long L' type Head
Sta. 118+40.0 Rt
Construct Drive
Sta. 119+70.0 Lt
Construct Drive
Sta. 120+80.0 Lt
Construct Drive
Sta. 121+20.0 Lt - Wall
Construct Drive
Side walls to be raised and cover provided
Sta. 121+70.0 Rt - 124+12.2
Remove
Sta. 121.1+61.1 - 124+50.0
Remove
Sta. 121+52.5 Rt
Construct Drive
