



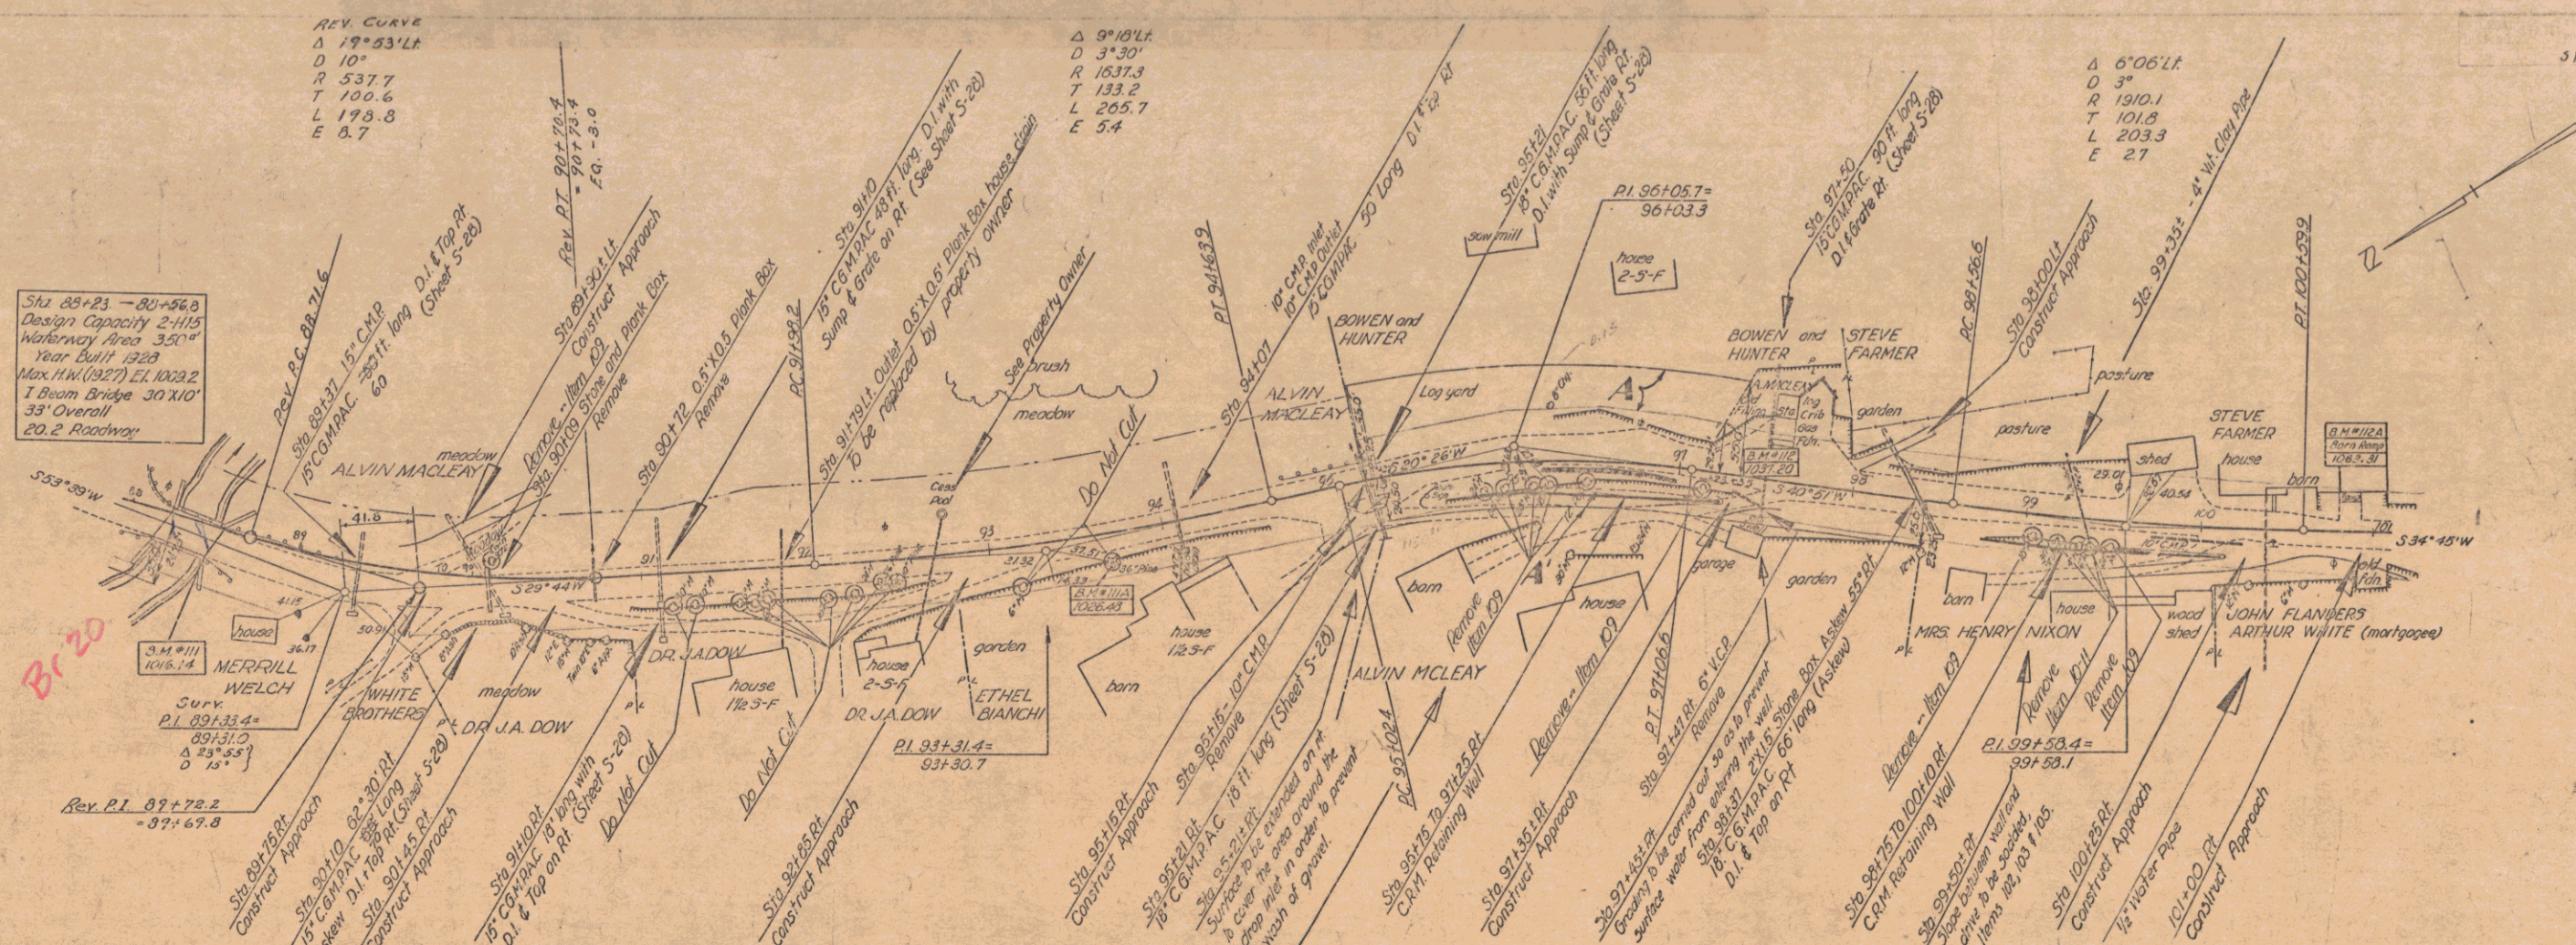

Sta. 88+00 to 89+50
Design Capacity 2-1115
Waterway Area 350' x 10'
Year Built 1928
Max H.W. (1927) EL 1003.2
1 Beam Bridge 30' x 10'
35' Overall
20.2 Roadway

General Note:
Where it is necessary for house drains to be placed through wall construction, the contractor will leave suitable openings for the same.

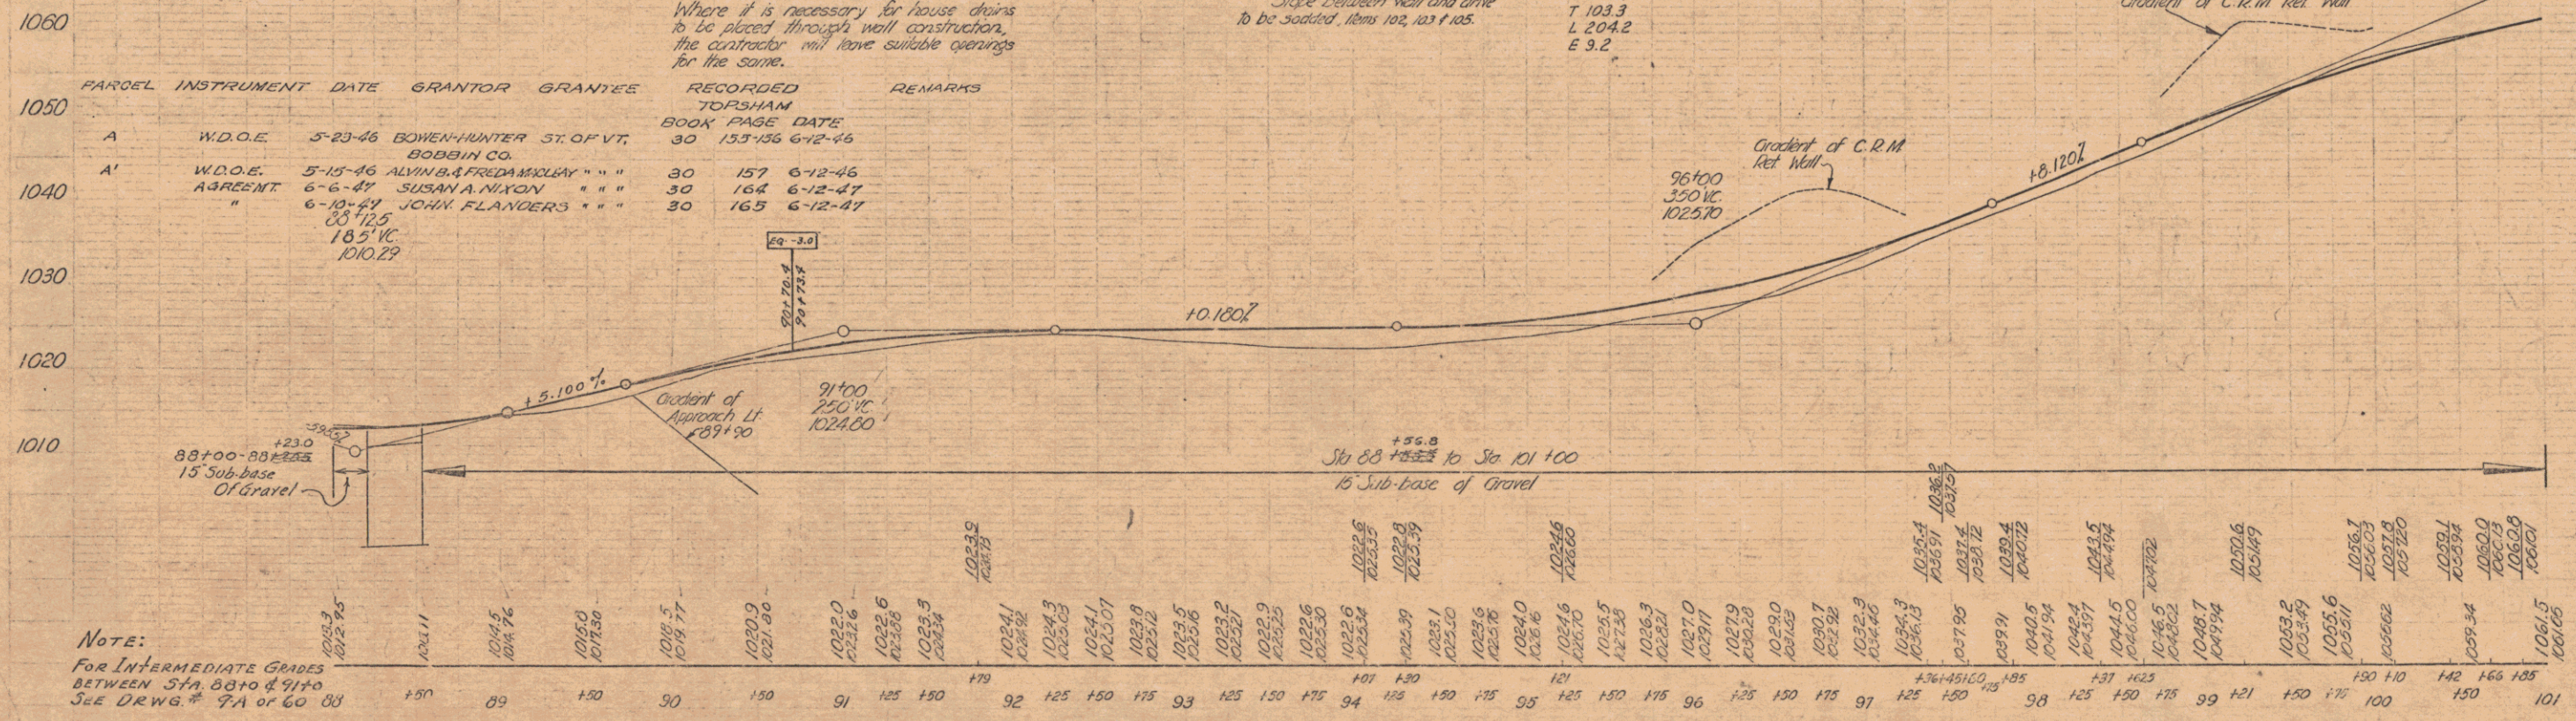

NOTE:
FOR INTERMEDIATE GRADES BETWEEN STA. 88+00 & 91+00 SEE DRWG. # 7A OF 60 88

B.M. #111 Spot on concrete bridge 10.2 ft Sta. 88+50 Elev. 1016.14
B.M. #111A Spot on 36" pipe 10.5' ft Sta. 91+07 Elev. 1026.48
B.M. #112 Spot on gas pump foundation 21' ft Sta. 91+50 Elev. 1037.20
B.M. #112A Spot on barn ramp 22' ft Sta. 100+100 Elev. 1063.31

TOPSHAM
Series 5-163 (2)
Sheet 9 of 60