ONE COURSE 5' CEMENT CONCRETE SIDEWALK (5'-0")
Lt
6+00 ~ 8+317
8+83 9+73 · App 1+00 Lt
App 1+00 Rt + 10+03 ~ 11+26.6
11+51.6 ~ 12+00

ONE COURSE 8' CEMENT CONCRETE SIDEWALK (5'-0")
Lt
8+17 ~ 8+93

GRANITE CURB

Lt	Rt
6+00 ~ 6+79	
6+99 ~ 7+895	6+00 ~ 6+03
8+089 ~ 8+291	6+33 ~ 6+879
8+421 ~ 8+678	6+98 ~ 8+065
8+849 ~ 9+731	App 1+00 Lt
App 1+00 Rt + 10+44	11+26.6 ~ 8+21 ~ 8+55
11+51.6 ~ 12+085	8+82 ~ 9+55
9+31 ~ SL 1+00	
SL 11+00 Rt ~ 10+44 Lt	

PAVED SHOULDER

Lt	Rt
6+00 ~ 11+26.6	6+00 ~ 9+00
11+51.6 ~ 12+00	

TWO CABLE GUARD RAIL

Lt	Rt
11+02 ~ 11+26.6	11+06 ~ 11+26.6
11+51.6 ~ 11+78	11+51.6 ~ 11+757

REMOVAL AND DISPOSAL OF PRESENT GUARD RAIL
Rt
11+12 ~ 11+288

DEMOLITION AND REMOVAL OF BUILDING
Rt
9+00 (1)

CONSTRUCT DRIVE

Lt	Rt
6+690	6+185
8+380	6+88
8+7542	8+12
7+95	5+70
8+75	9+70

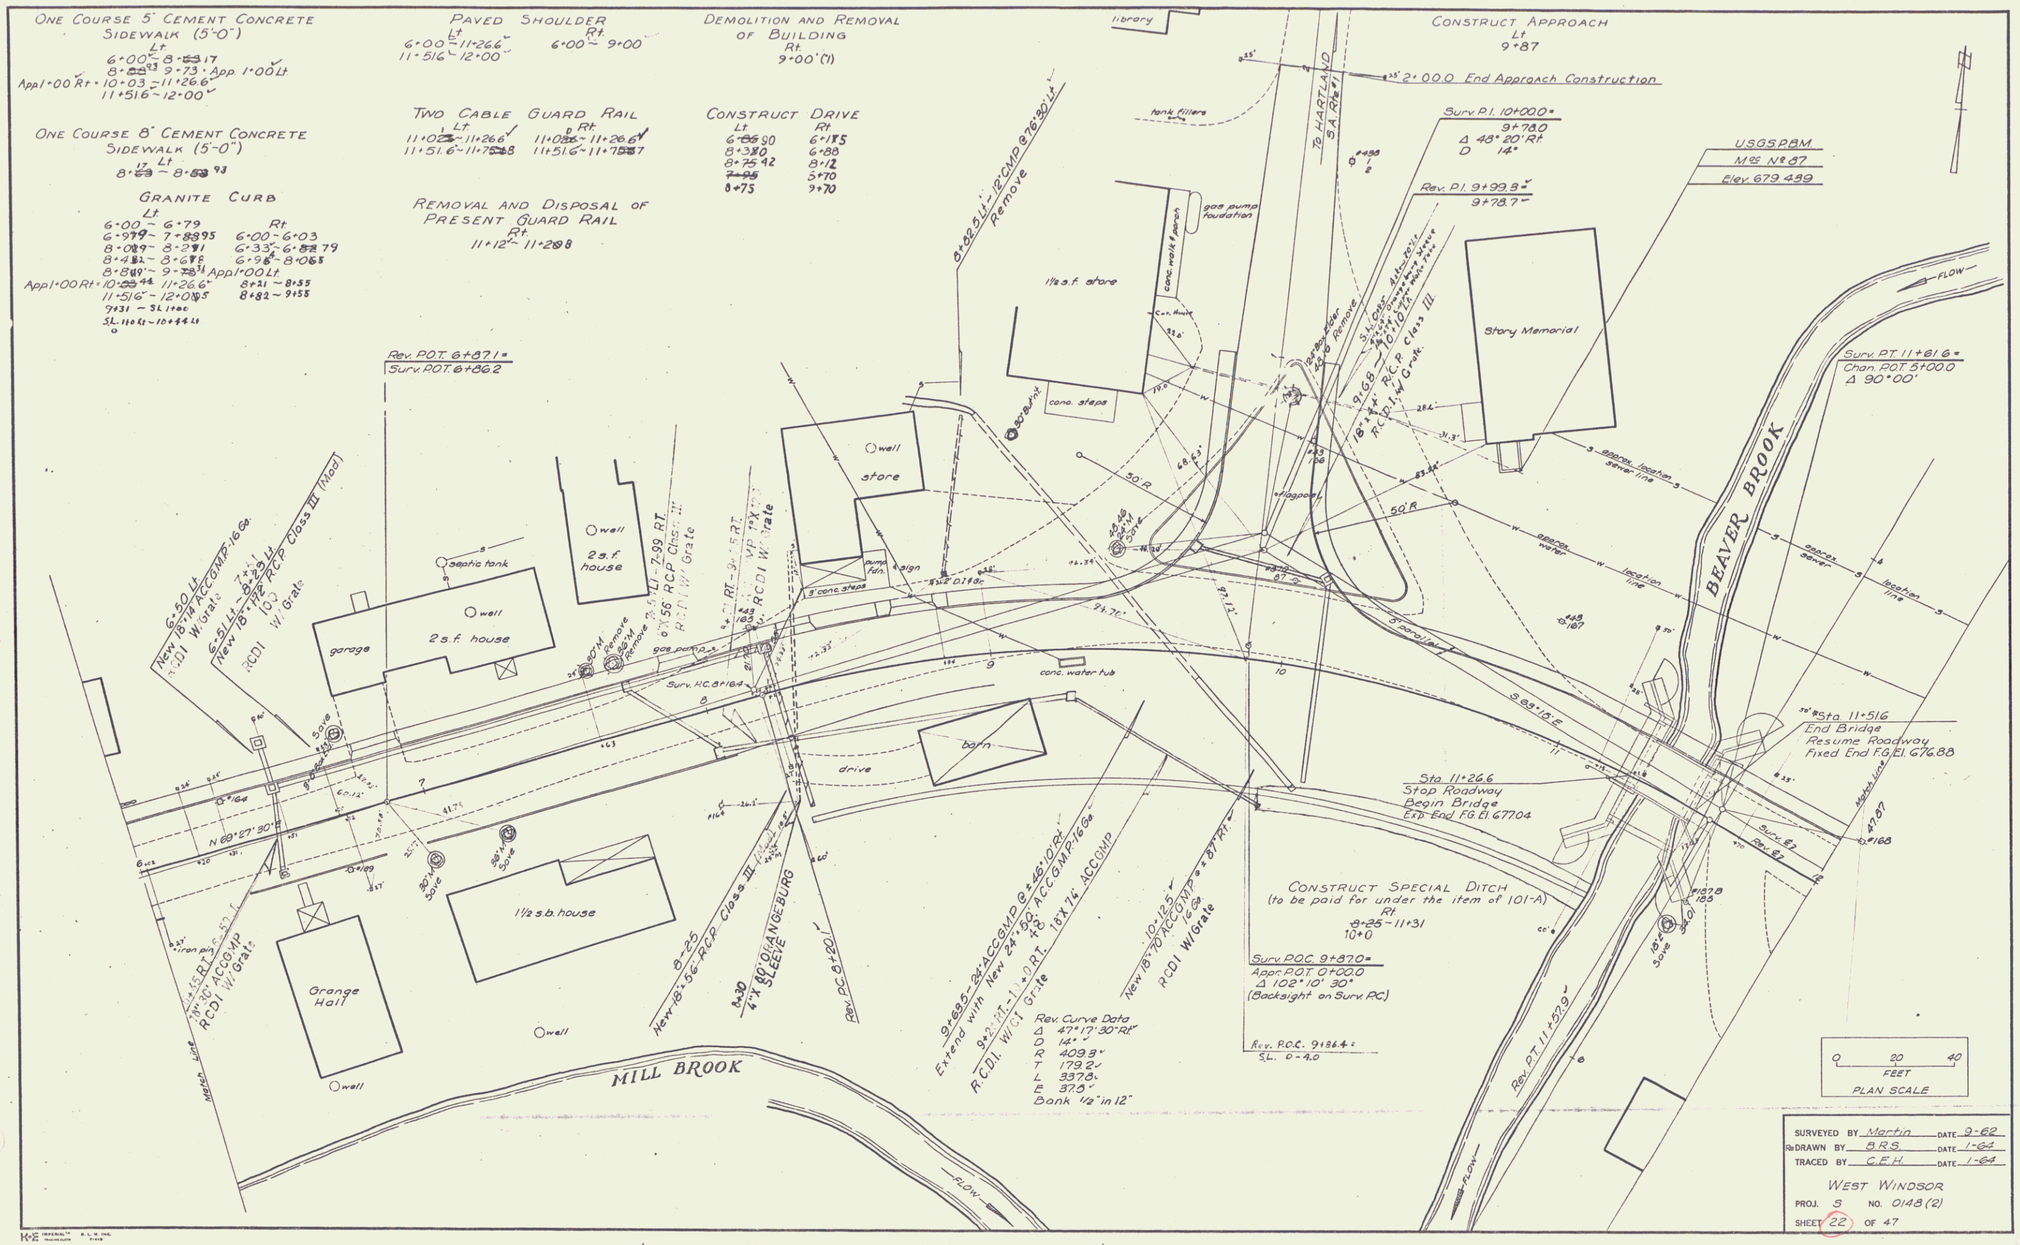

SURVEYED BY Martin DATE 9-62
DRAWN BY B.R.S. DATE 1-64
TRACED BY C.E.H. DATE 1-64

WEST WINDSOR
PROJ. S NO. 0148 (2)
SHEET 22 OF 47

5