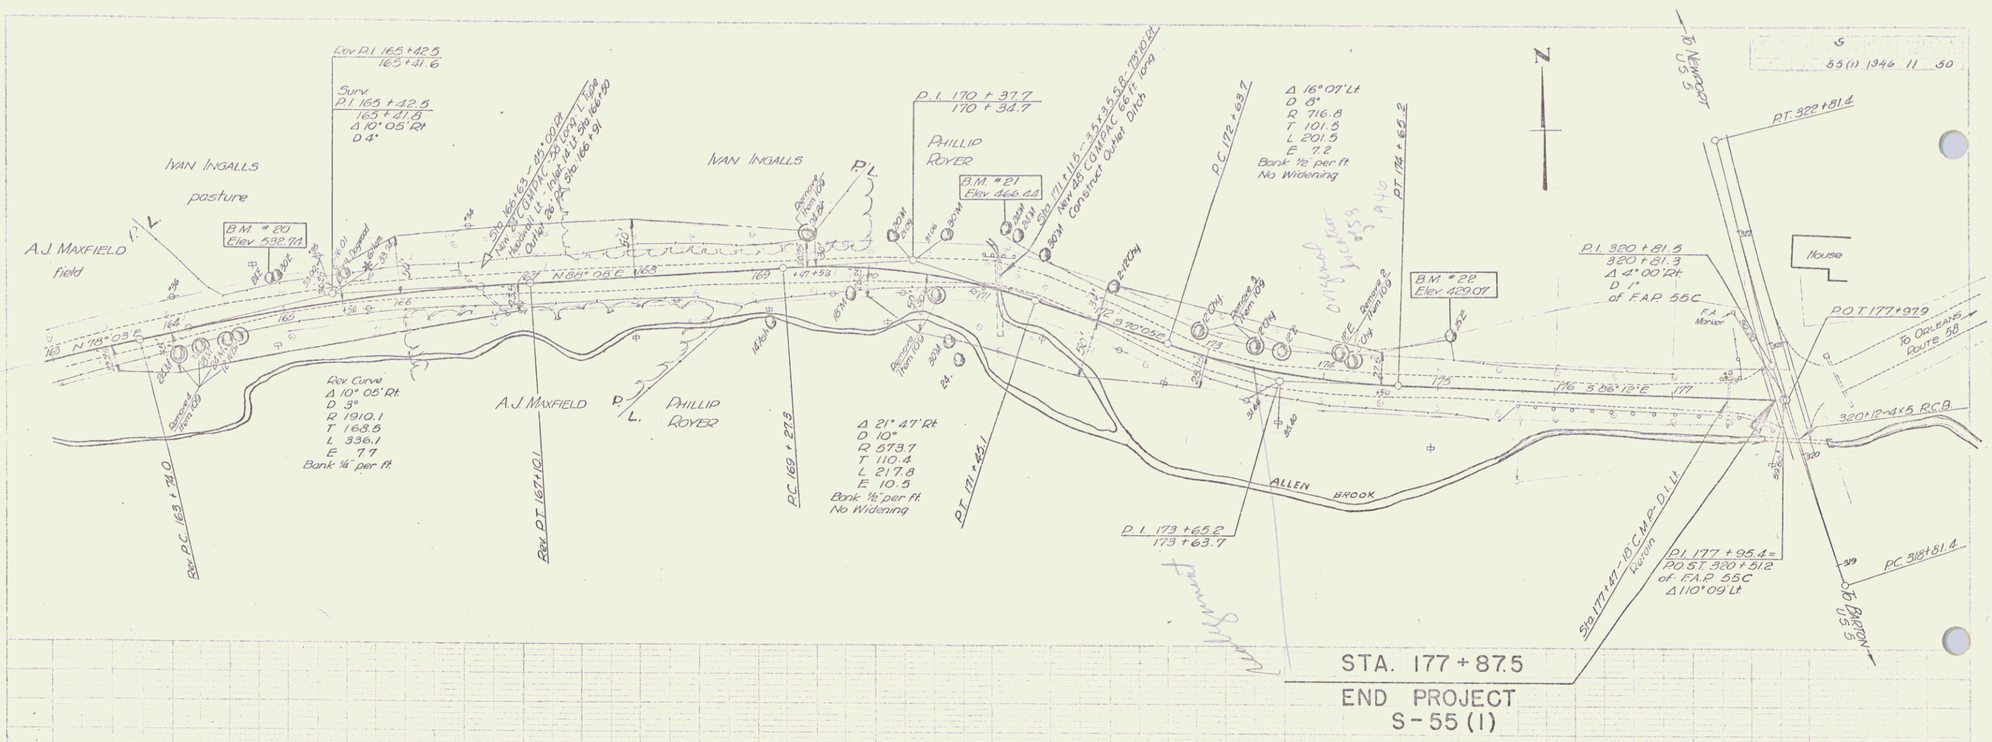

B.M. #20 -- S.I.R. 24" Elm 25 ft. lt. of sta. 164 + 92 Elev. 532.74
B.M. #21 -- S.I.R. 24" Maple 47 ft. lt. of sta. 171 + 03 Elev. 466.44
B.M. #22 -- S.I.R. 15" Elm 41 ft. lt. of sta. 175 + 08 Elev. 429.07

series S no 55(1)
sheet (11) of 50 sheets
TASBURG

9