WOOD GUARD RAIL REQUIRED

ON LEFT

Sta. 74+08 To Sta. 74+17 Length 17 FT.
" 75+53 " " 75+77 " 24 -
" 81+63 " " 81+75 " 24 -
" 84+38 " " 84+62 " 24 -
" 85+48 " " 85+72 " 24 -

ON RIGHT

Sta. 74+00 To Sta. 74+17 Length 17 FT.
75+53 " " 75+77 " 24 -
78+00 " " 78+40 " 40 -
81+63 " " 81+75 " 24 -
84+38 " " 84+62 " 24 -
85+48 " " 85+72 " 24 -

CABLE GUARD RAIL REQUIRED

ON LEFT

" 86+10 To Sta. 88+10 " 200 FT.

NEW CULVERTS

Sta. 74+05 18" Corrug. Metal Pipe Length 28 FT.
Concrete Class B 2.70 Cu. Yds.
Reinforcing Steel 33 Lbs.

Sta. 75+65 18" Corrug. Metal Pipe Length 41 FT.
Concrete Class A 1.90 Cu. Yds.
Reinforcing Steel 54 Lbs.

Concrete Class A 0.90 Cu. Yds.
Concrete Class B 1.50 Cu. Yds.
Reinforcing Steel 44 Lbs.

NEW CULVERTS

Sta. 81+75 18" Corrug. Metal Pipe Length 34 FT.
Concrete Class A 1.9 Cu. Yds.
Reinforcing Steel 54 Lbs.

Sta. 84+50 18" Corrug. Metal Pipe Length 34 FT.
Concrete Class A 3.1 Cu. Yds.
Reinforcing Steel 33 Lbs.

Sta. 85+60 18" Corrug. Metal Pipe Length 33 FT.
Concrete Class A 3.1 Cu. Yds.
Reinforcing Steel 33 Lbs.

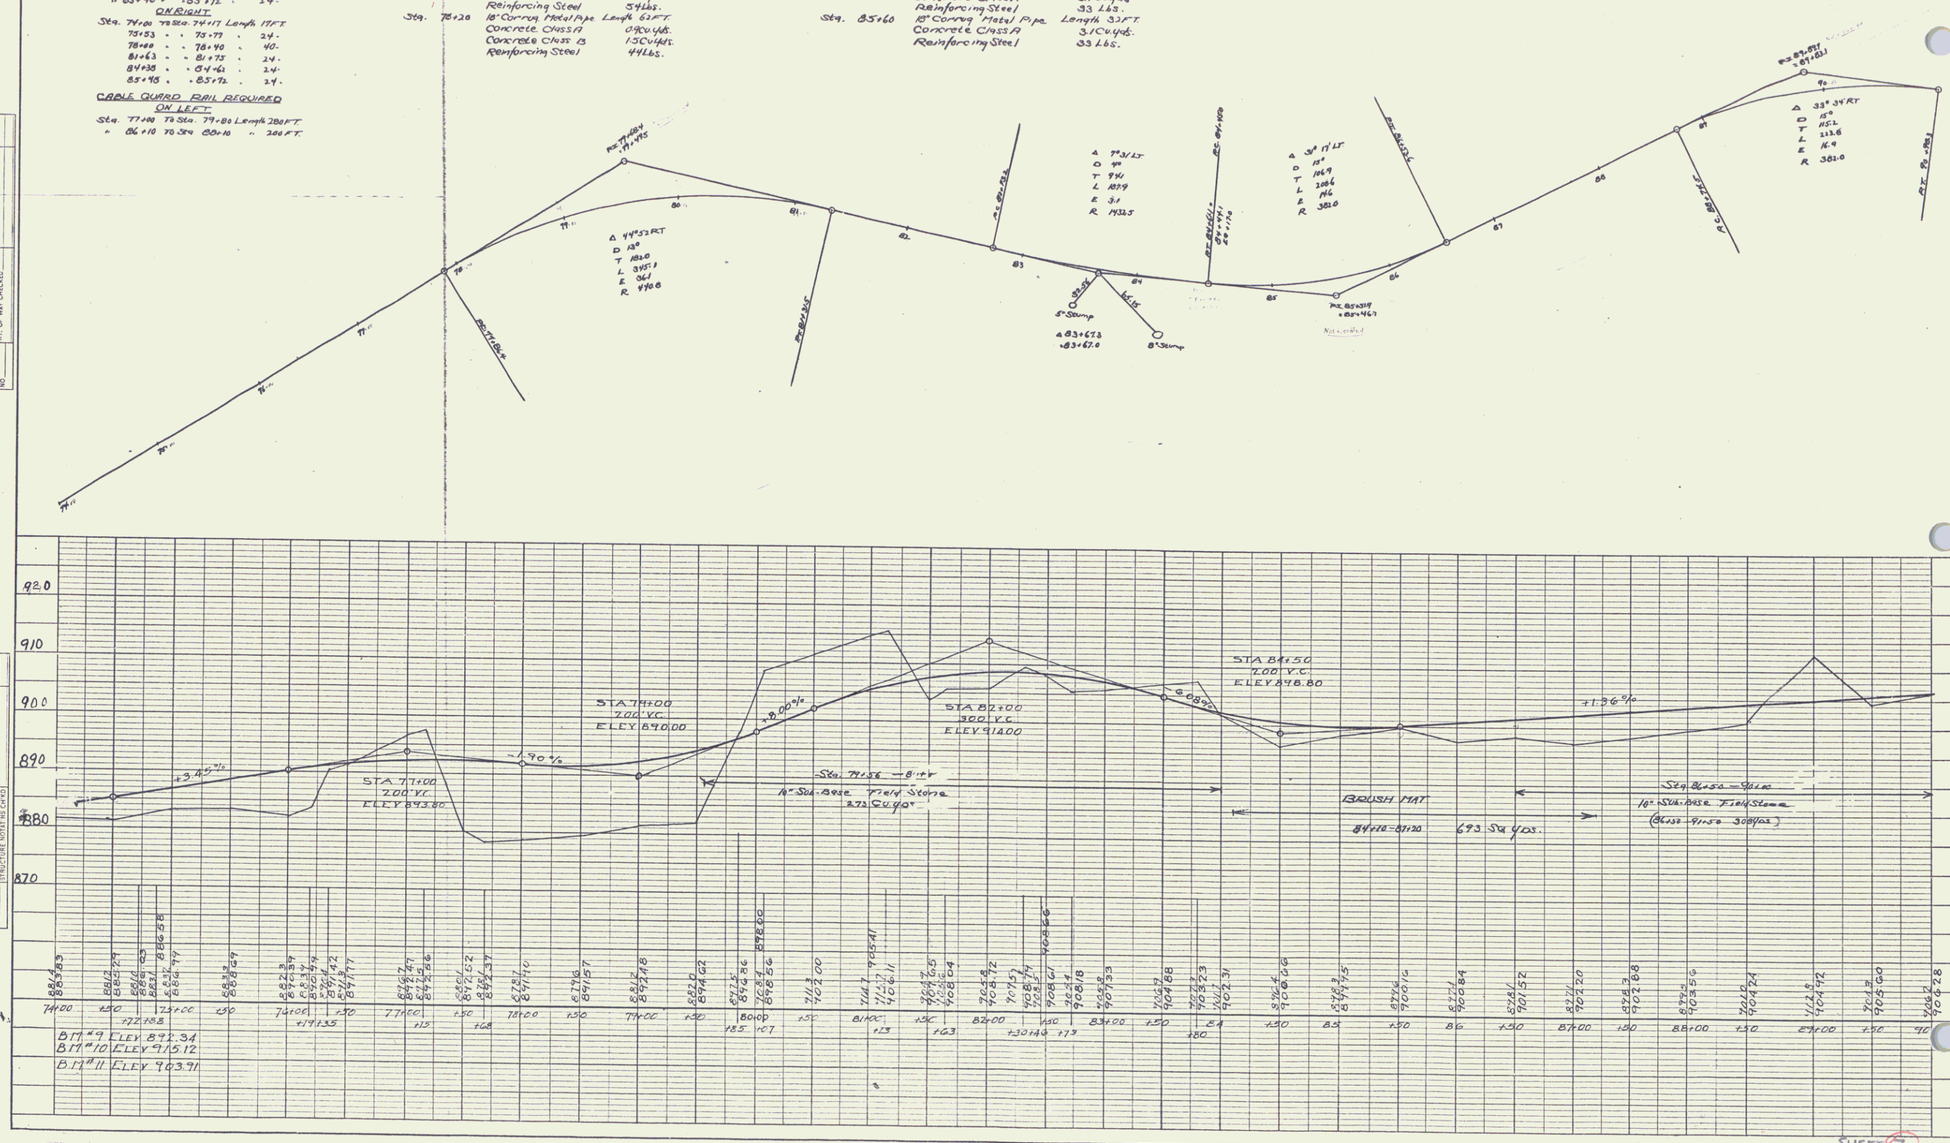

PLATE I — PLAN — PROFILE O.P.R. & R.E. STANDARD
REUTTER & ESSER CO. N.Y. NEW YORK

SHEET 7