FED. ROAD DIST. NO.	STATE	PROJECT NO.	FISCAL YEAR	SHEET NO.	TOTAL SHEETS
3	Vt.	FH 71A		16	56

FOREST HIGHWAY

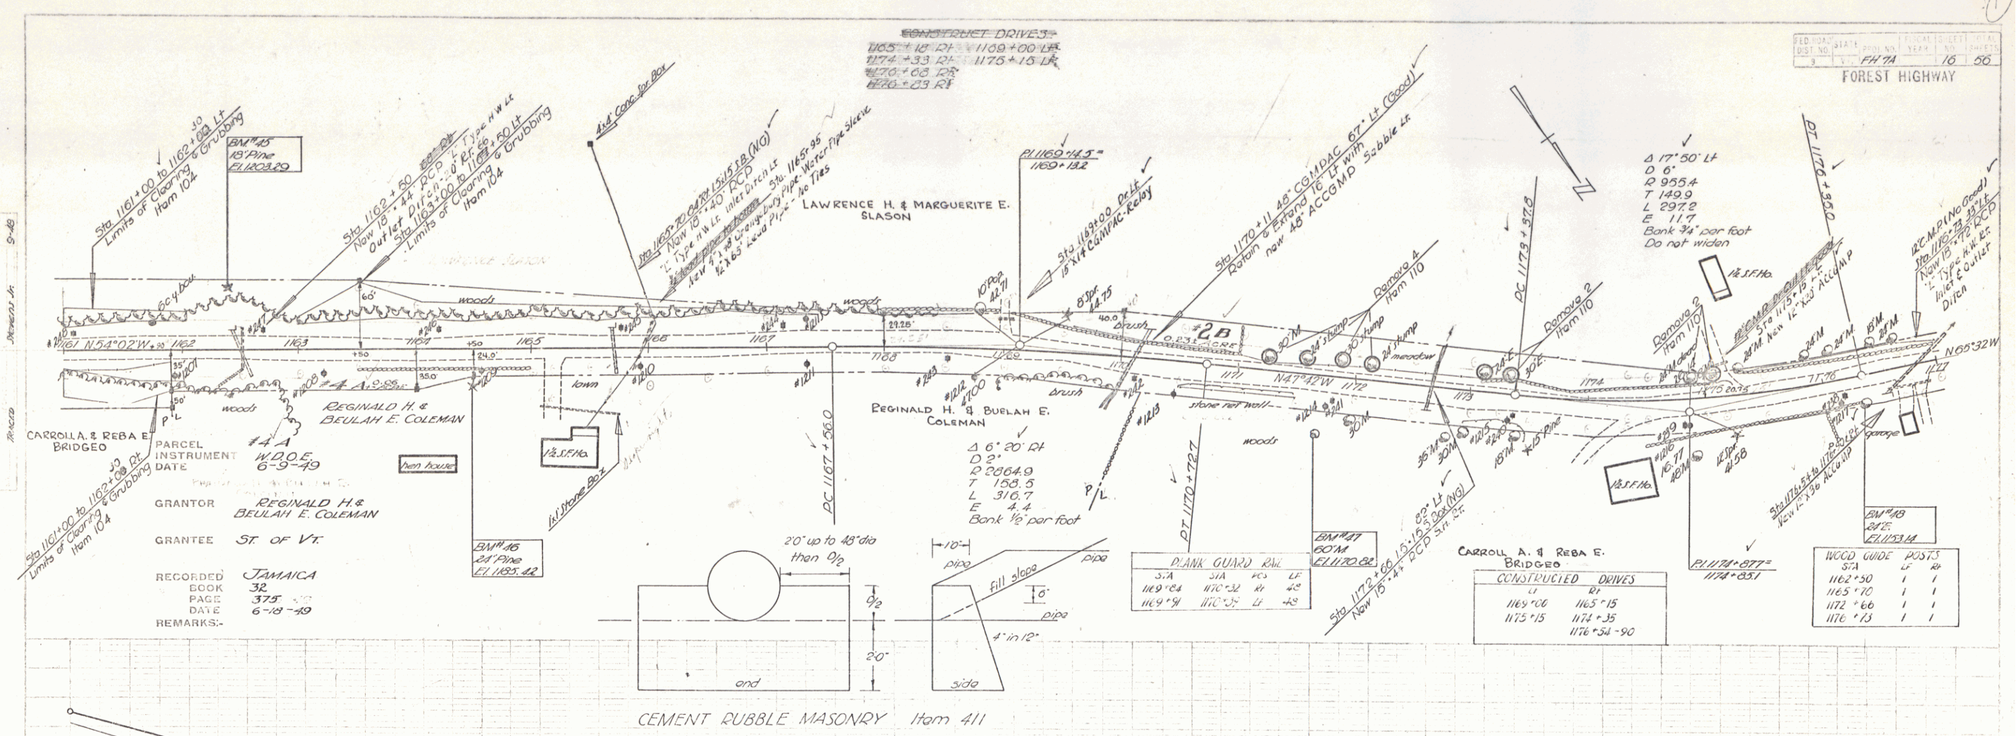

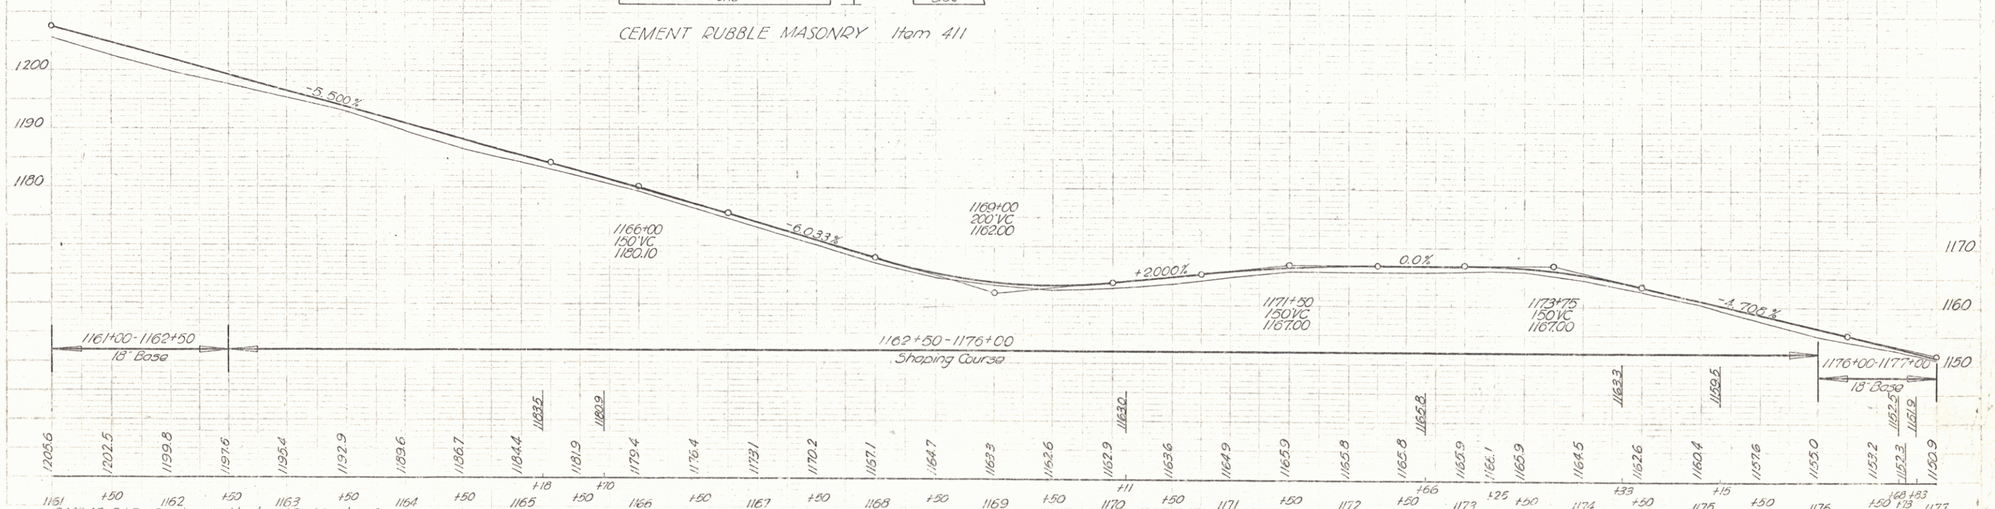

JAMAICA - WINHALL FH 71A
Sheet 16 of 56

3