VERMONT FOREST HIGHWAY
PROJECT No. 7-A
Sheet No. 21 of 56

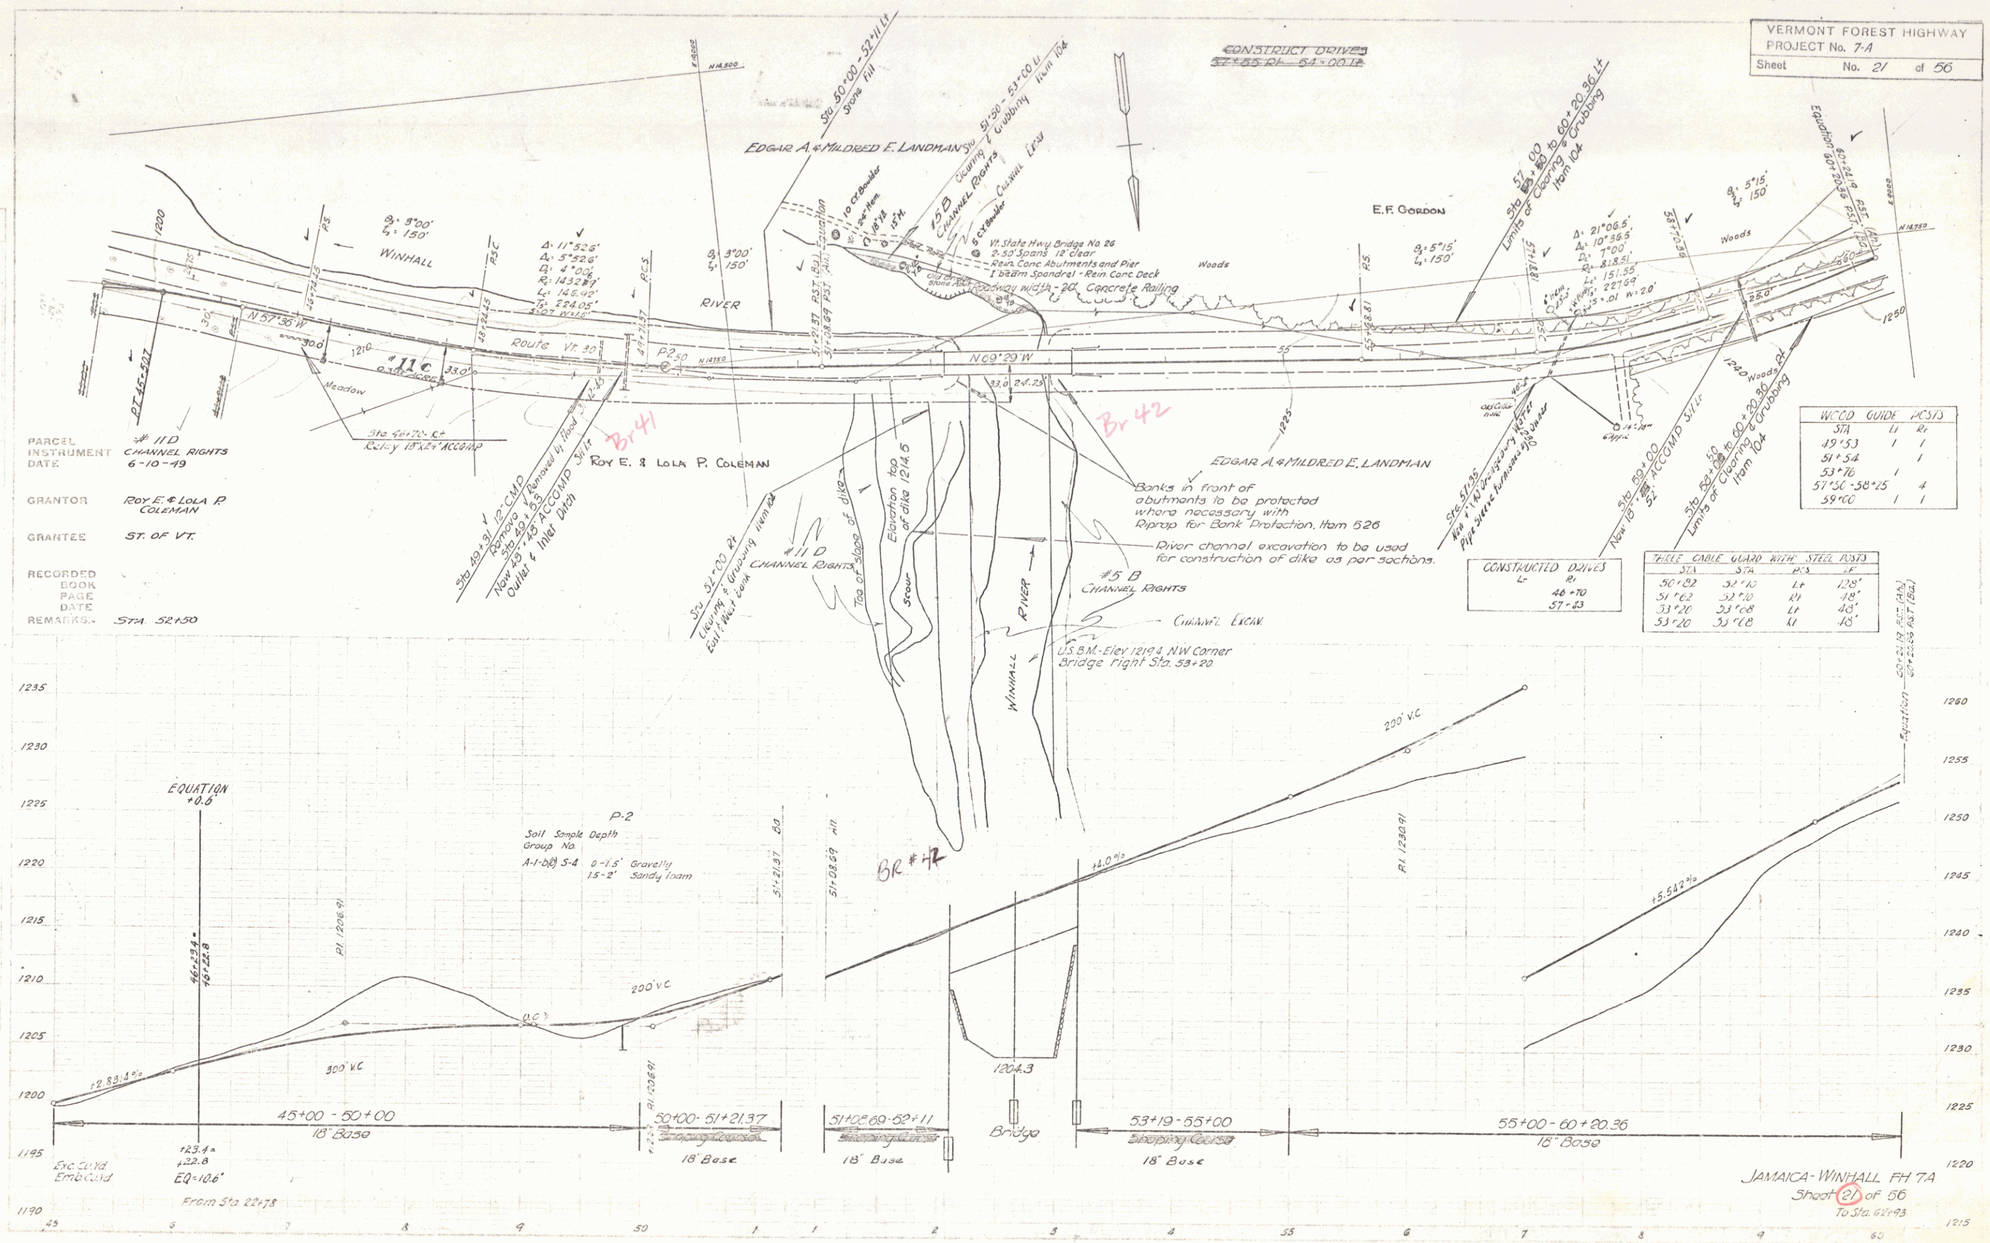

PARCEL #11D
INSTRUMENT CHANNEL RIGHTS
DATE 6-10-49

GRANTOR ROY E. & LOLA P. COLEMAN

GRANTEE ST. OF VT.

RECORDED
BOOK
PAGE
DATE

REMARKS:- STA. 52+50

WOOD GUIDE POSTS		
STA	Lt	Rt
49+53	1	1
51+54		1
53+76	1	
57+56 - 58+25		4
59+00	1	1

CONSTRUCTED DRIVES
L
46+70
57+43

TRIPLE CABLE GUARD WITH STEEL POSTS			
STA	STA	PS	LF
50+82	52+10	Lt	128'
51+62	52+10	Rt	48'
33+20	33+68	Lt	48'
53+20	53+68	Lt	48'

8