

POOR ORIGINAL COPY

VERMONT FOREST HIGHWAY
Sheet No. 5 of 76



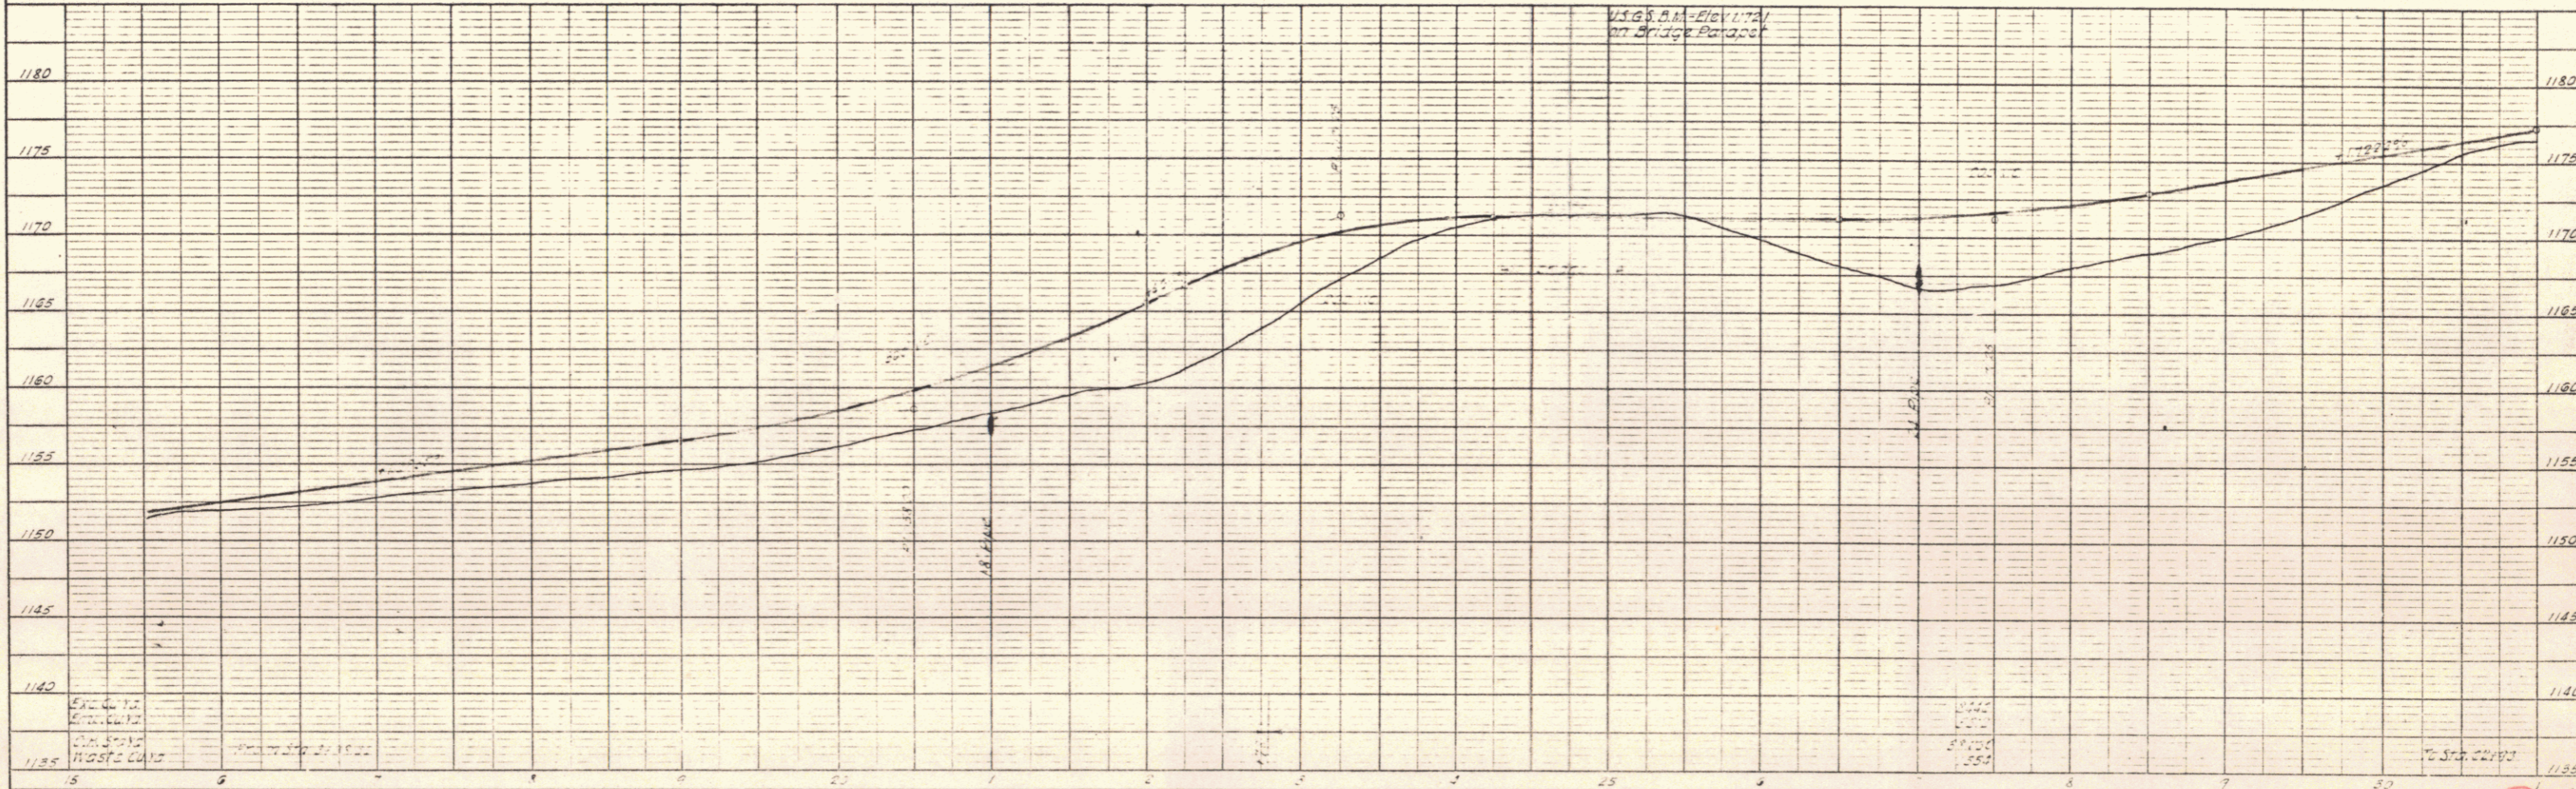
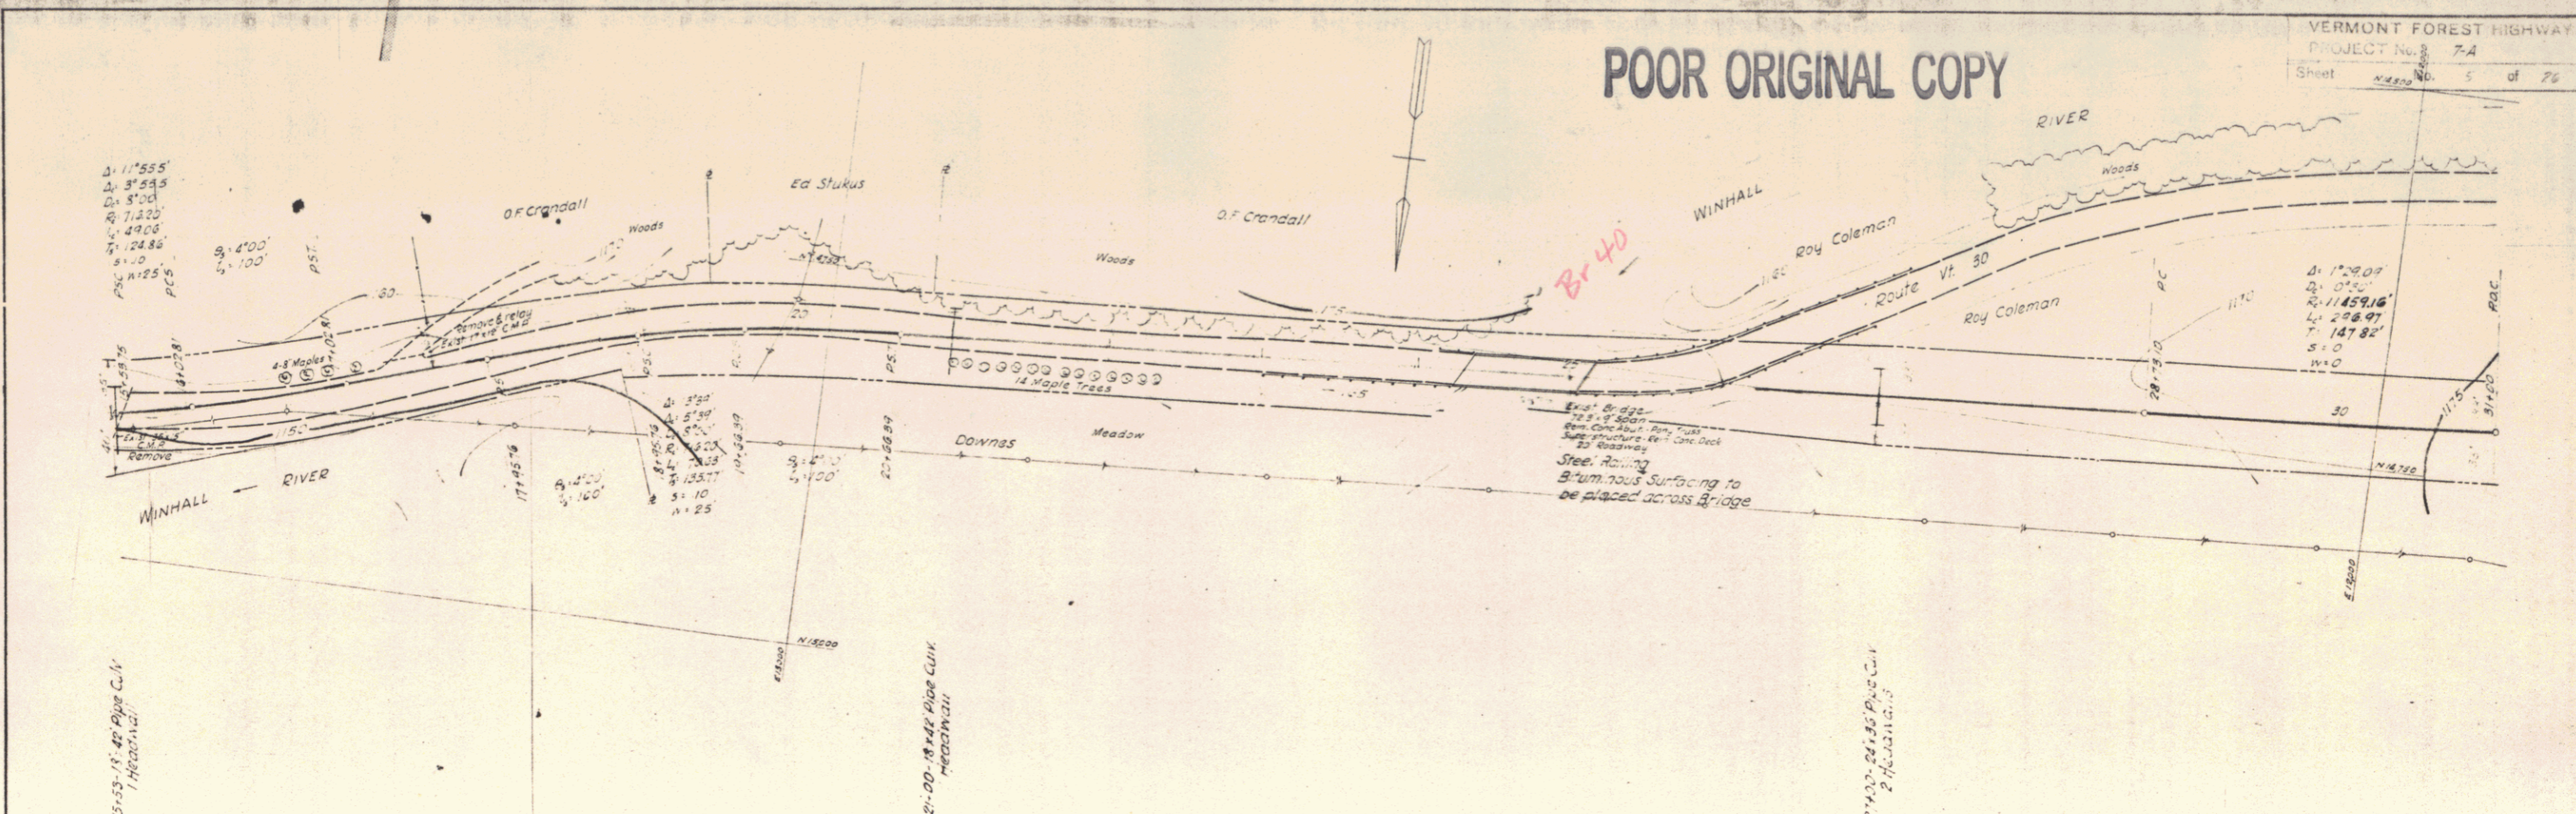



5

14