

POOR ORIGINAL COPY

PLAN

DATE	
BY	
DESIGNED	
PLOTTED	
CHECKED	
DATE	
BY	
NO.	

PROFILE

DATE	
BY	
DESIGNED	
PLOTTED	
CHECKED	
DATE	
BY	
NO.	

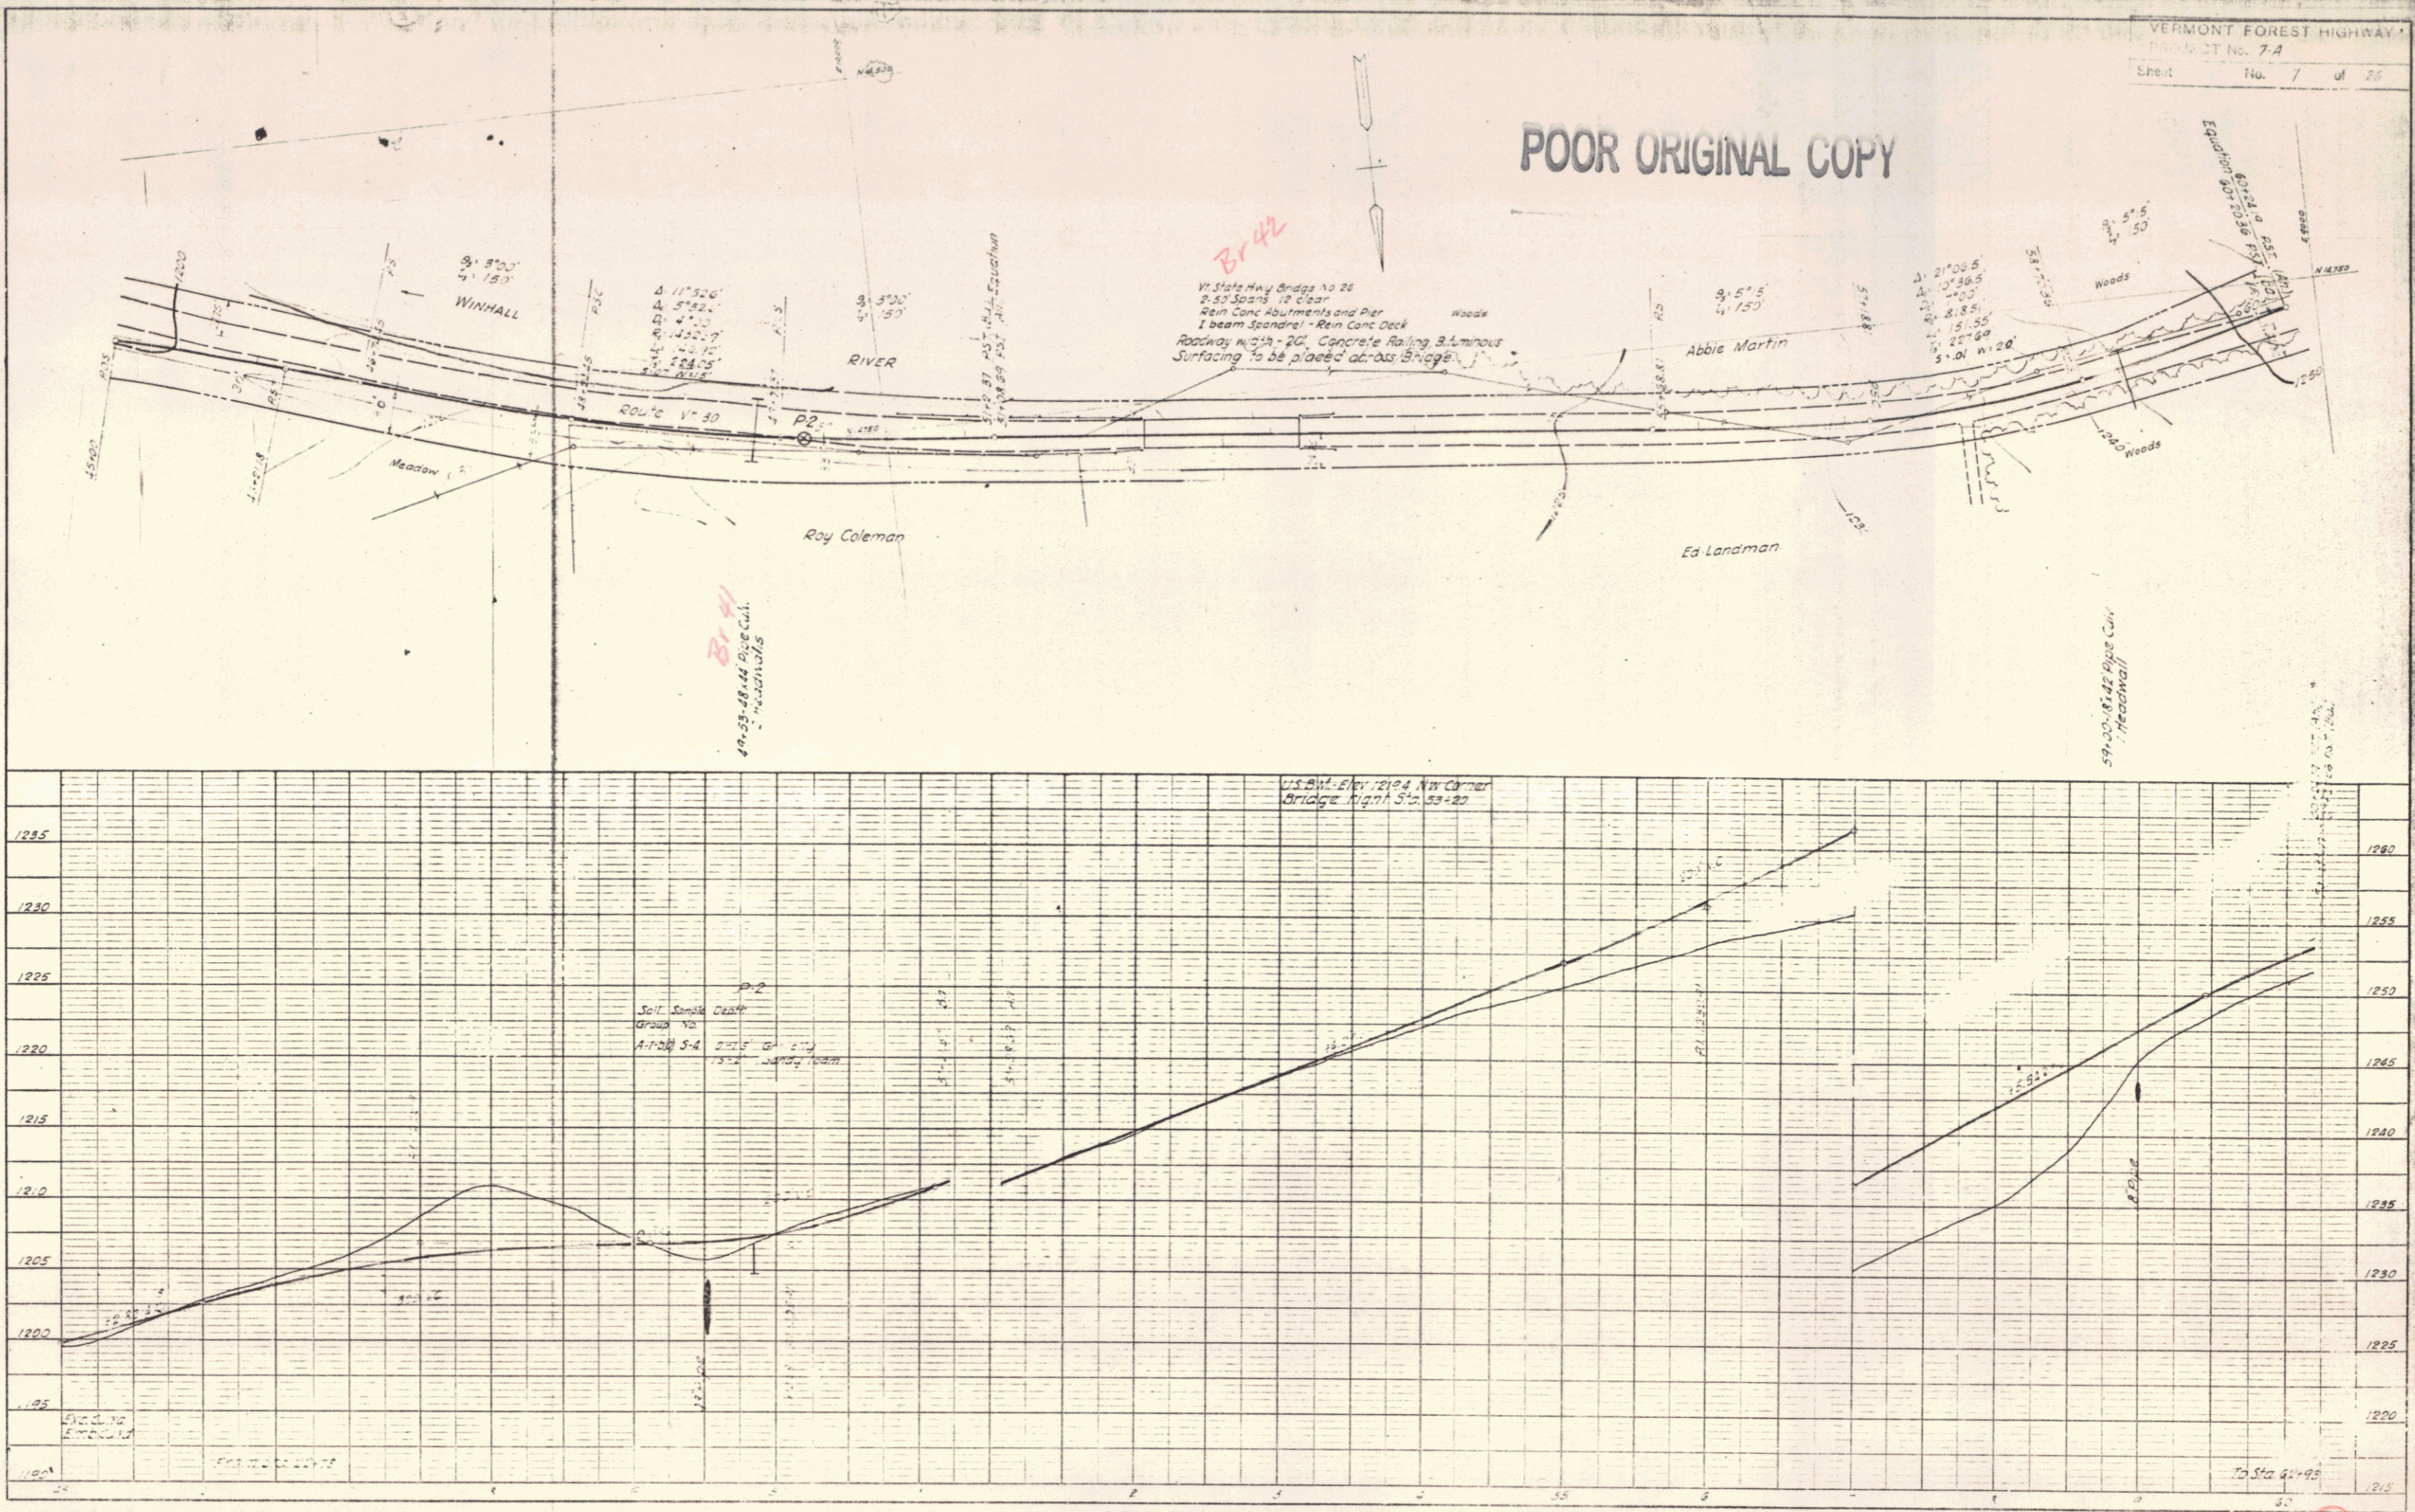


