VERMONT FOREST HIGHWAY
PROJECT No. 7-A
Sheet No. 8 of 26

POOR ORIGINAL COPY

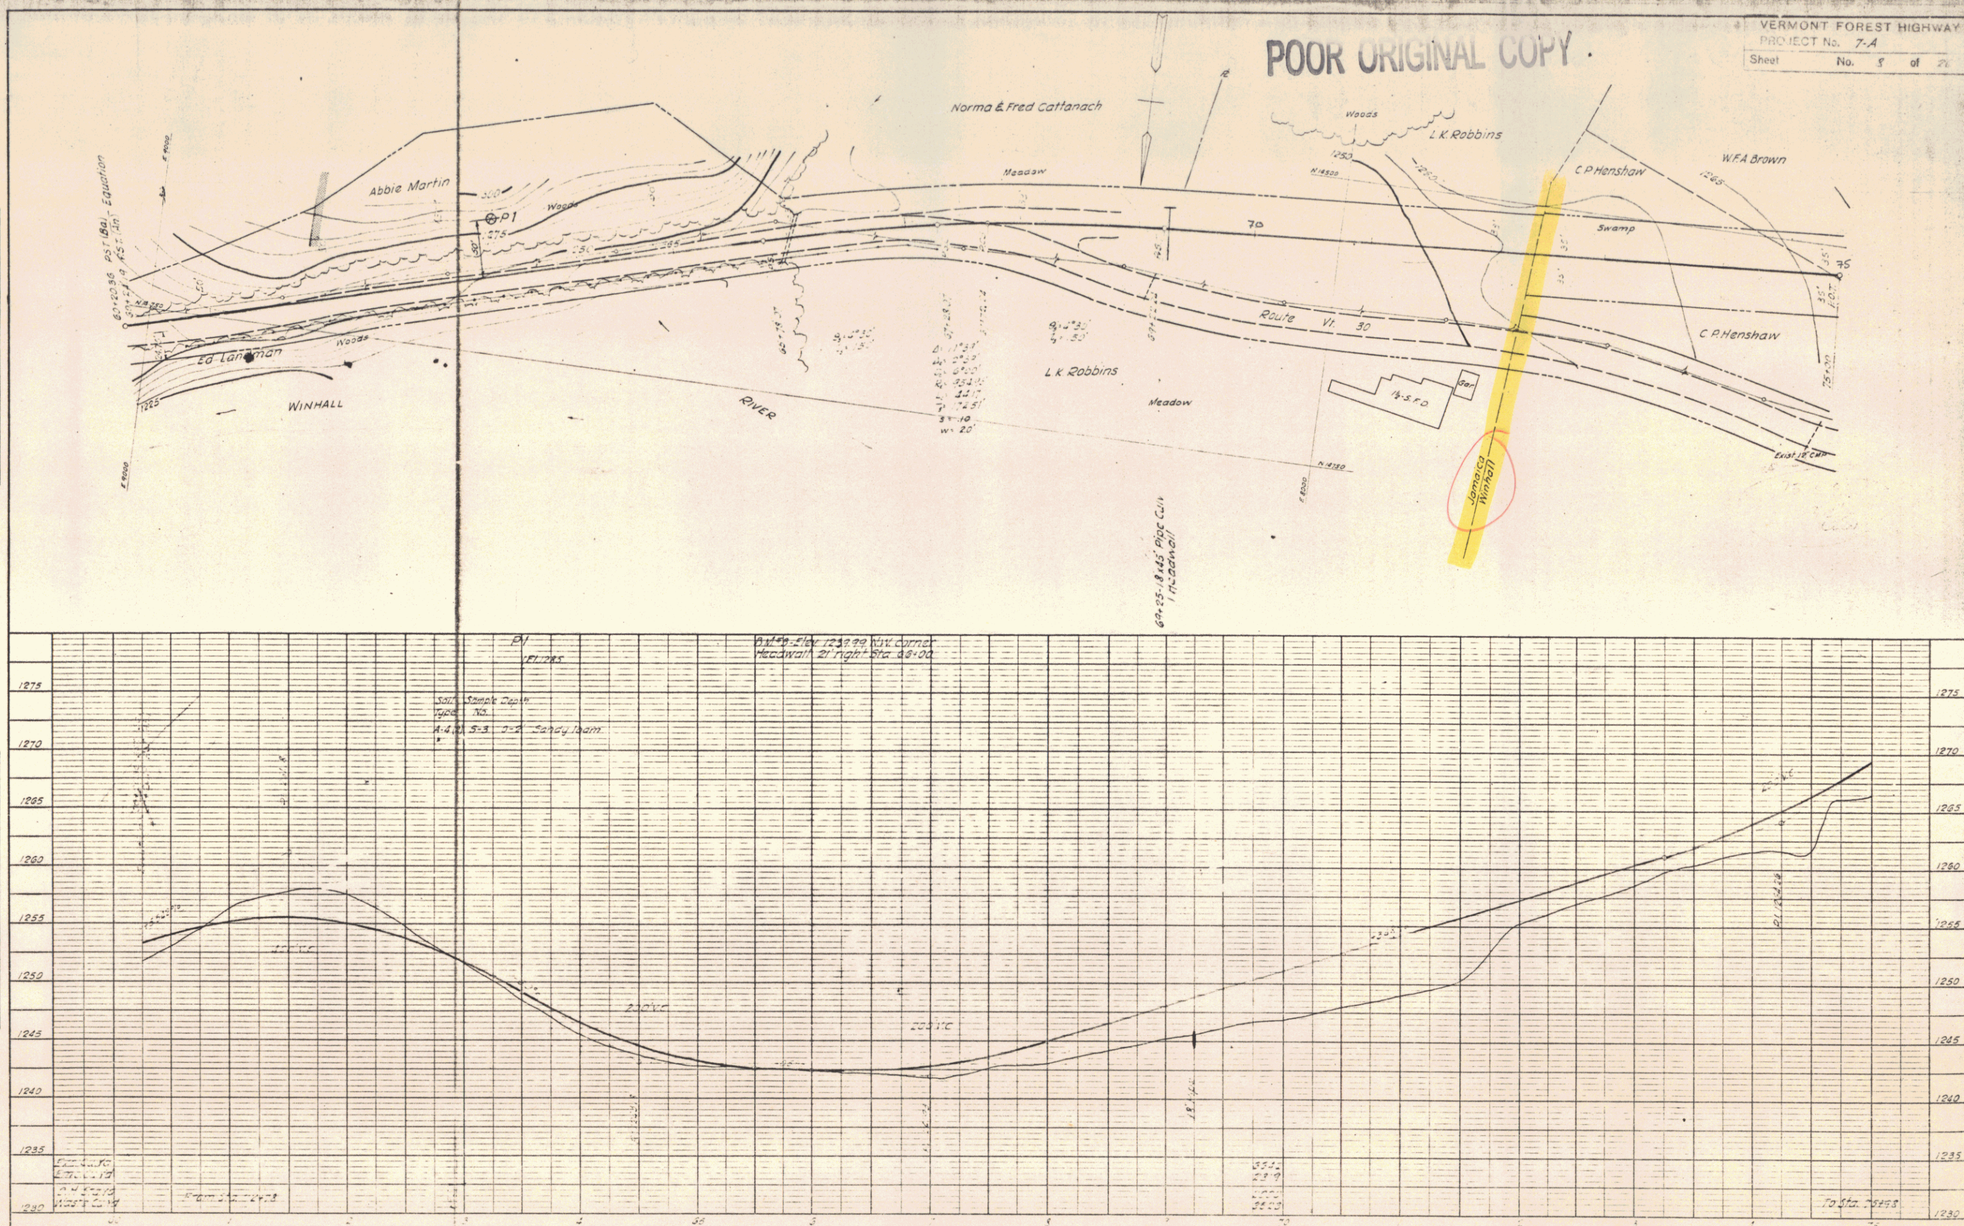

PLATE I — PLAN-PROFILE G.P.R.A.R.E. STANDARD
KEUFFEL & ESSER CO., NEW YORK

PLAN
NOTE BOOK NO.
SURVEYED
PLOTTED
ALIGNMENT CHECKED
FT. OF WAY CHECKED
BY
DATE

PROFILE
NOTE BOOK NO.
SURVEYED
GRADES CHECKED
PLOTTED
STRUCTURE NOTATIONS CHKD.
BY
DATE

8

17