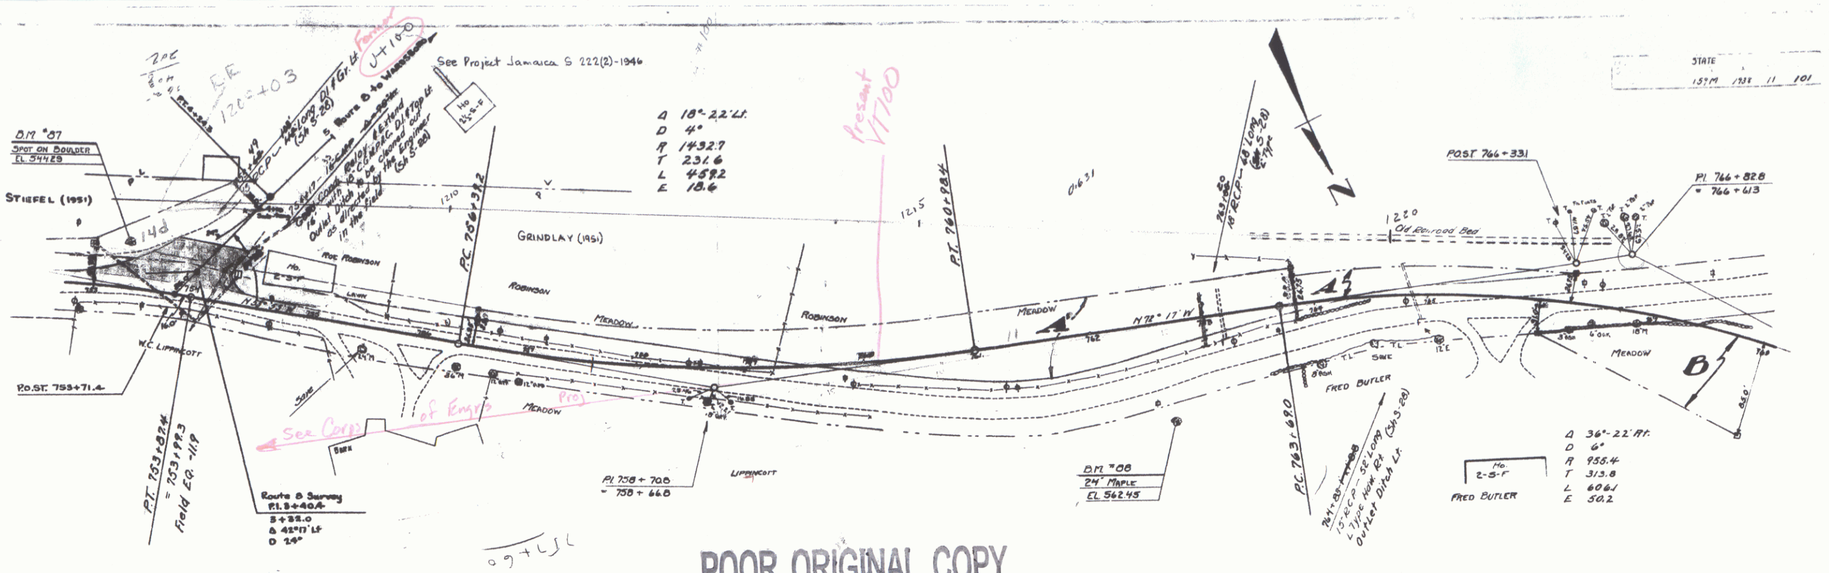

Parcel	Kind of Instrument	Date of Instrument	Grantor	Grantee	Recorded Jamaica Book	Page	Date
A-B	Q.C.D.	1-15-37	F.M. & R.P. Butler	Prop. Vt.	30	133	1-18-37
A'	Q.C.D.	1-5-38	Roe Robinson	"	30	233	1-7-38

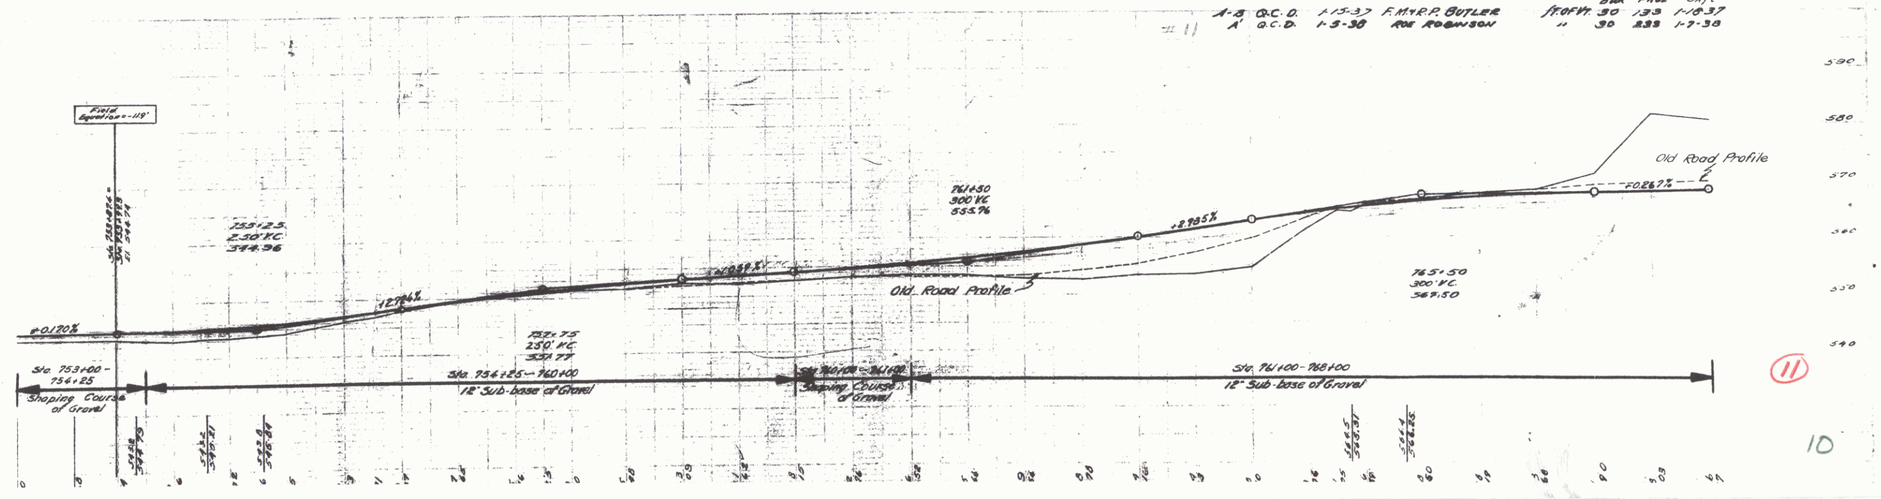

11

10