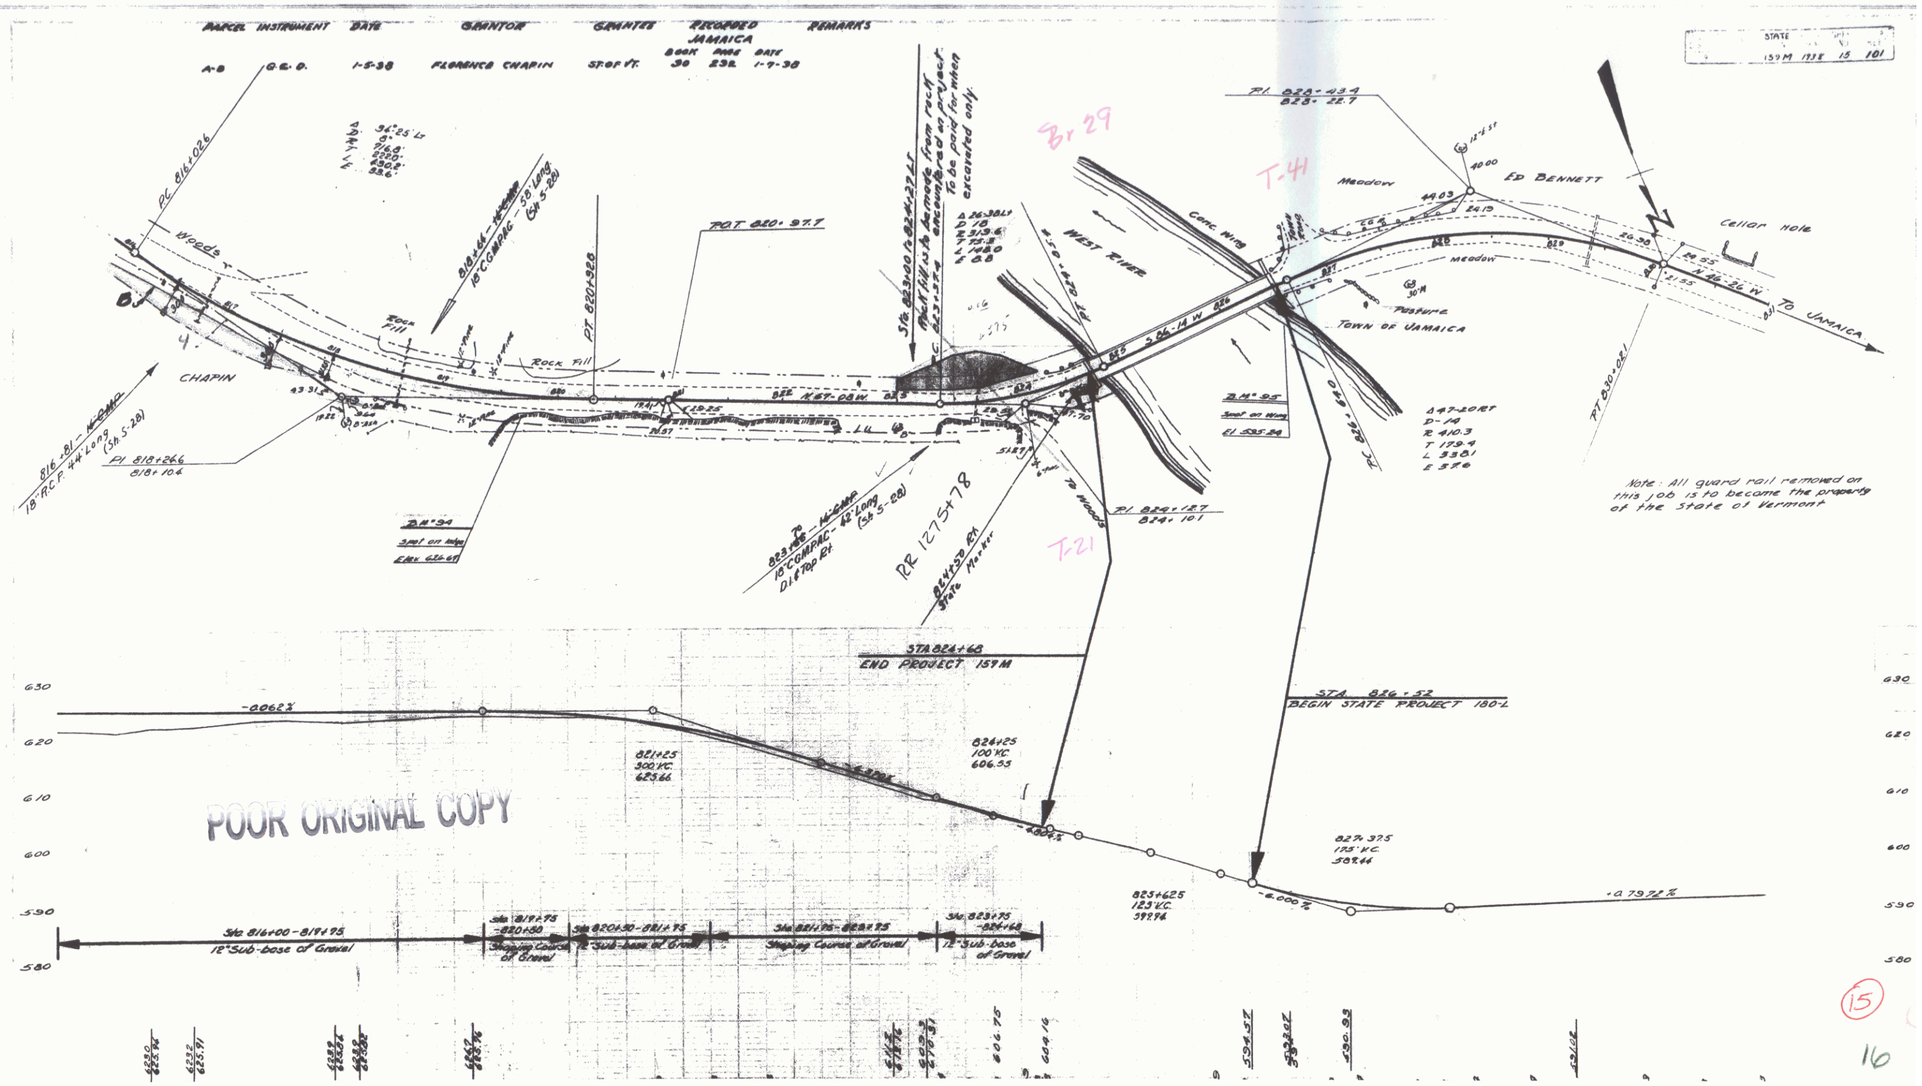PARCEL	INSTRUMENT	DATE	GRANTOR	GRANTEE	RECORDED JAMAICA BOOK	PAGE	DATE	REMARKS
A-8	G.E.D.	1-5-38	FLORENCE CHAPIN	ST. OF VT.	30	239	1-9-38