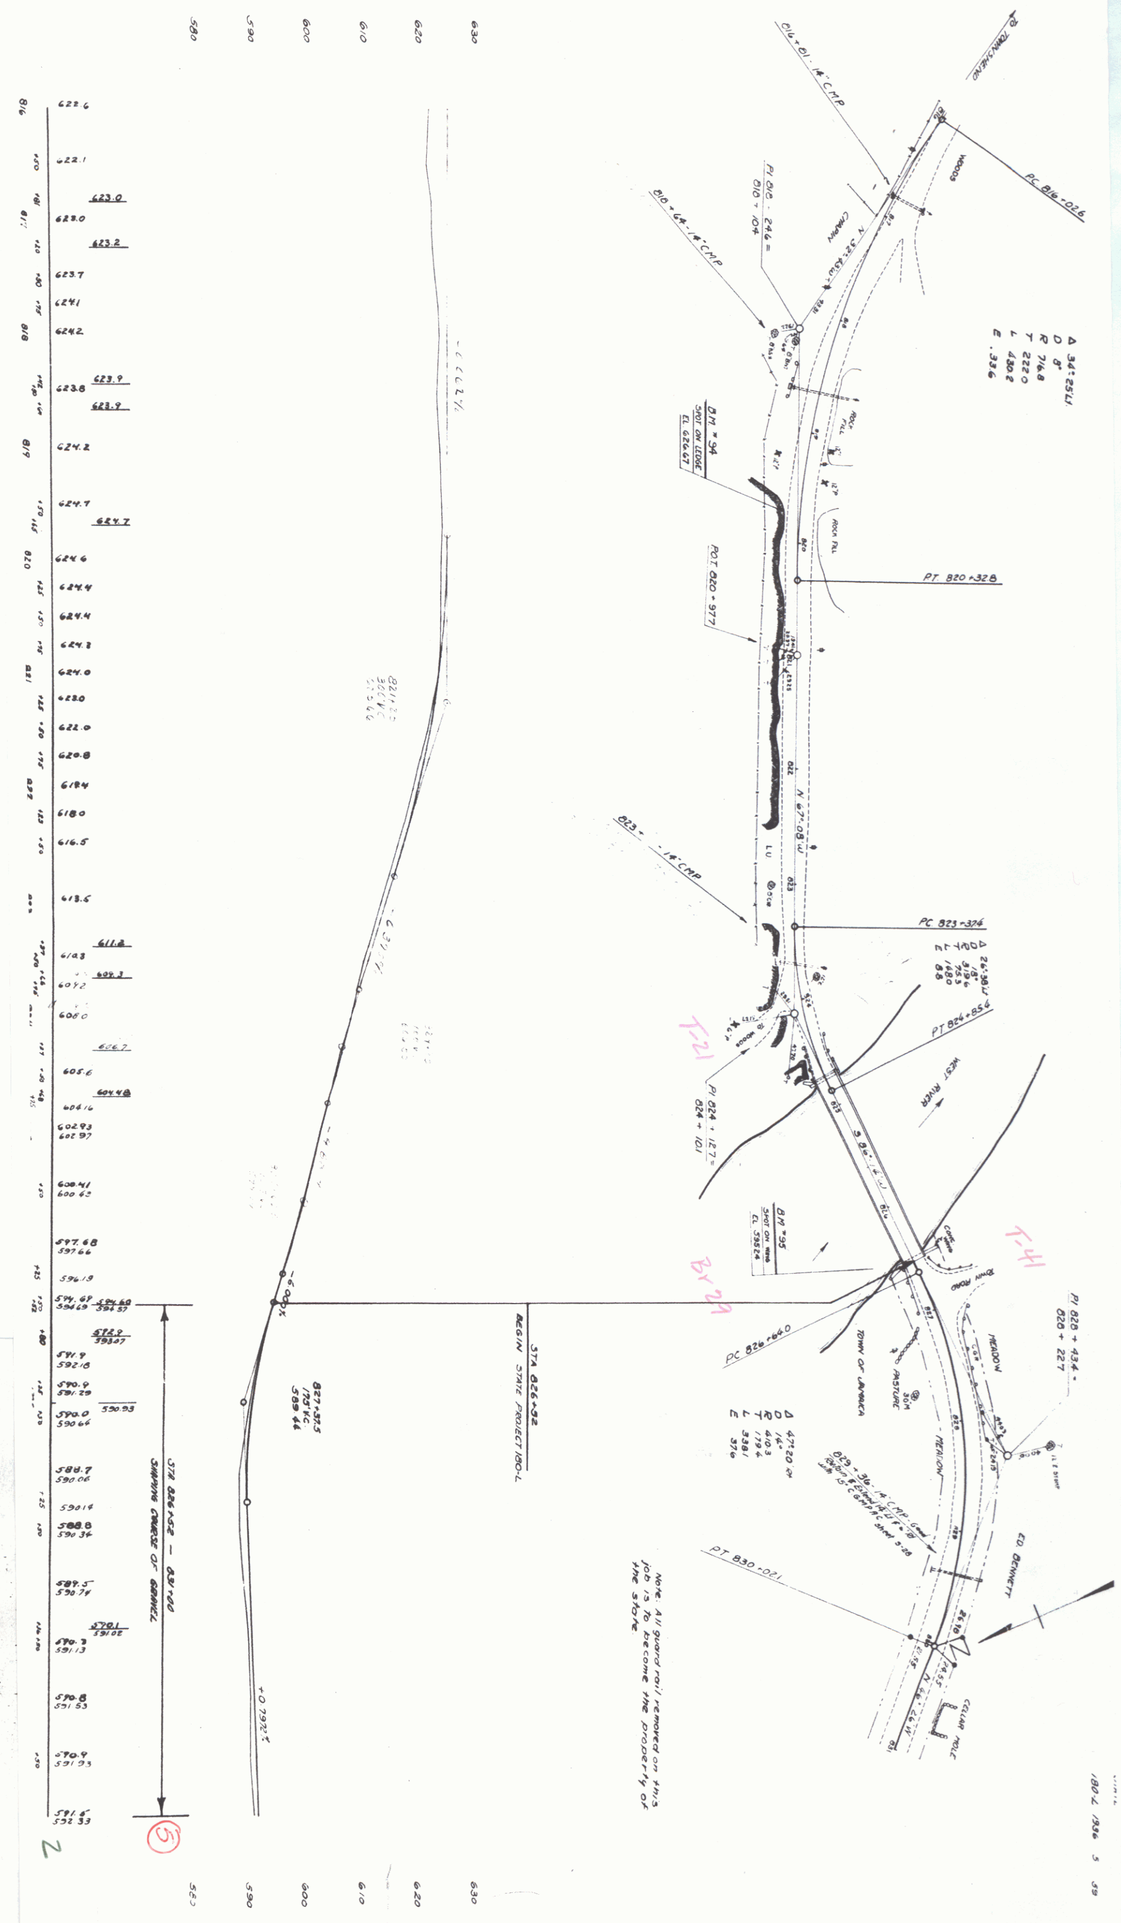
PC 819+026
PT 820+328
PC 823+326
PT 824+854
PC 826+640
PT 830+021
PI 828 + 434 =
828 + 227
Δ 34°25'41"
D 8°
R 716.8
T 222.0
L 430.2
E .356
Δ 34°20'04"
D 16°
R 403
T 124
L 239
E .376
Δ 26°40'14"
D 8°
R 716.8
T 170.0
L 333.4
E .198
BM 795
SHOT ON HOOD
EL 592.4
BM 794
SHOT ON LEDGE
EL 626.67
POT 820 + 977
PI 824 + 101
PI 824 + 127.7
STA 826+52
BEGIN STATE PROJECT 1801-L
STA 826+52 — 831+00
SHOWING CHANGE OF GRADE
827+375
170' KC
589.44
+0.79%
-5.00%
T-21
T-41
NOTE: All guard rail removed on this job is to become the property of the state.