STATE
180-L 1936 13 59

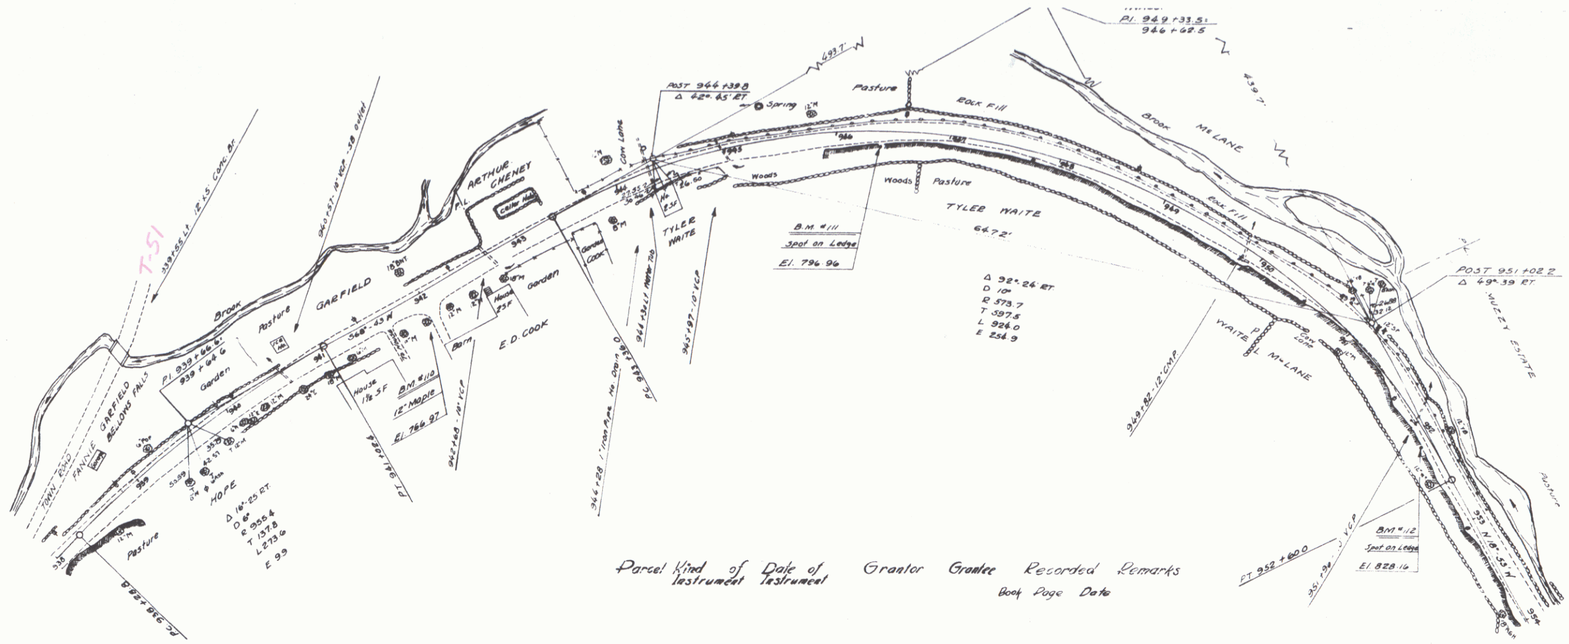

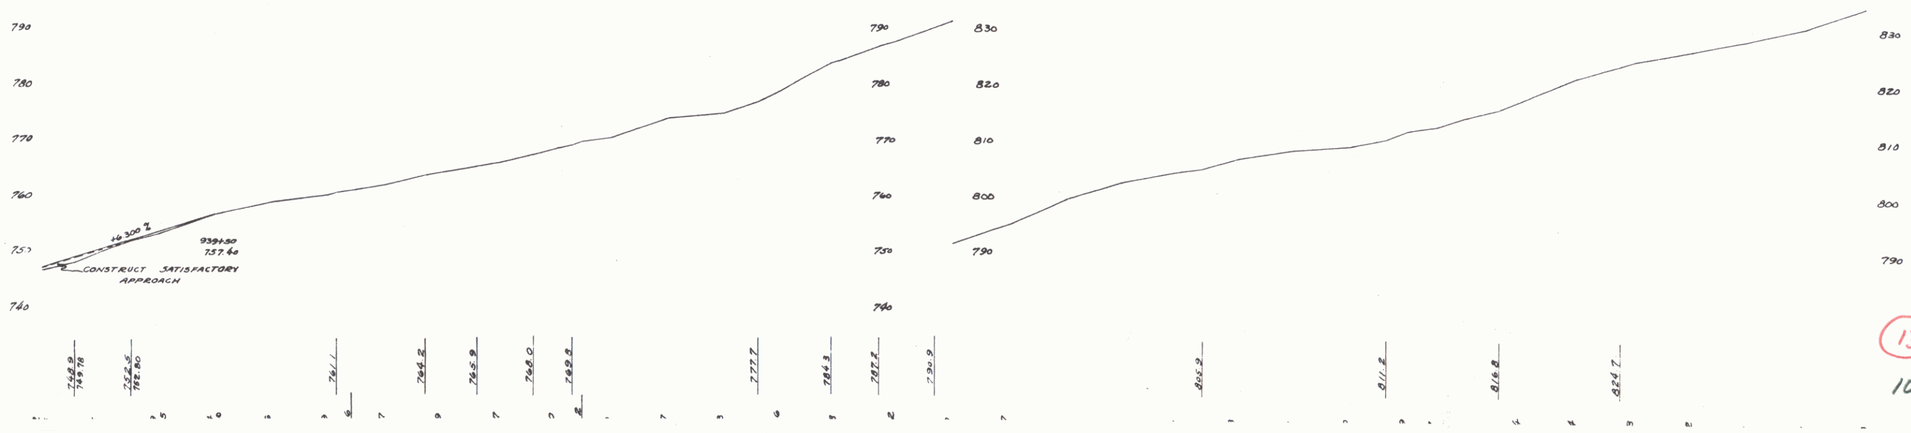

13

10