THREE CABLE GUARD RAIL WITH STEEL POSTS
158+94 - 160+38 Rt
170+20 - 172+00 Rt

5' Cl Guide Posts
160+68 - 161+16 Rt
166+50 - 166+98 Rt

CONSTRUCT APPROACH
156+00 Lt

CONSTRUCT DRIVES
Lt 155+85, 165+25
Rt 163+20

INACC. P.I. 166+90.3*
166+12.9

POST 160+25.0

School
Town Road
Born
113 S.F. House
Meadow
Woods
Pasture
Shack
Brush
Approx. Locat.
Limits of Uncl. Chan. Exc.

HARRY P. & MARTHA M. EDGERTON

#19 B
0.01 Acre±
Sta. 160+03 - 160+58 Rt

#19 A
0.33 Acre±
Sta. 157+68 - 161+07 ℄

HARRY P. & MARTHA M. EDGERTON

ROBERT B. & HAZEL I. SLADE

#20 A
0.79 Acre±
Sta. 160+98 - 170+00 ℄

#20 B
0.02 Acre±
Sta. 161+07 - 161+68 Rt.

HAROLD & ELEANOR J. LEFURGY

Lat 43°08'49.26"
Long 72°54'01.38"
By USGS Transit
Traverse - Junction of road SW.

#17 B
0.03 Acre±
Sta. 167+00 - 168+25 Rt.

SULO & MARY SALO

#21
1.10 Acre±
Sta. 168+25 - 178+31 Rt.

B.M. #7
S.I.R. 15" Elm
El. 1365.95

Δ 38°48' Rt
D 2°
R 2864.9
T 1006.6
L 1958.8
E 171.0
Bank 1/2" per ft

PARCEL	INSTRUMENT	DATE	GRANTOR	GRANTEE	RECORDED TOWN OF	Book	Page	Date	REMARKS
19A,B	W.D.O.E.	5-24-55	HARRY P. & MARTHA M. EDGERTON	ST. OF VT.	WINHALL	17	489-490-491	7-14-55	
	W.D.O.E.		HARRY D. & MARTHA M. EDGERTON	ST. OF VT.	WINHALL				
20A,B,C	W.D.O.E.	5-24-55	ROBERT B. & HAZEL I. SLADE	ST. OF VT.	WINHALL	17	493-494	7-14-55	See also Sheet 16
21	W.D.O.E.	5-24-55	SULO & MARY SALO	ST. OF VT.	WINHALL	17	495-496	7-14-55	See also Sheets 16 & 17

Limits of section of old highway between station 155+00 - 55' Lt and station 165+50 - 50' Lt relinquished to town of Winhall
recorded book 18 page 197-200 date 1-31-57

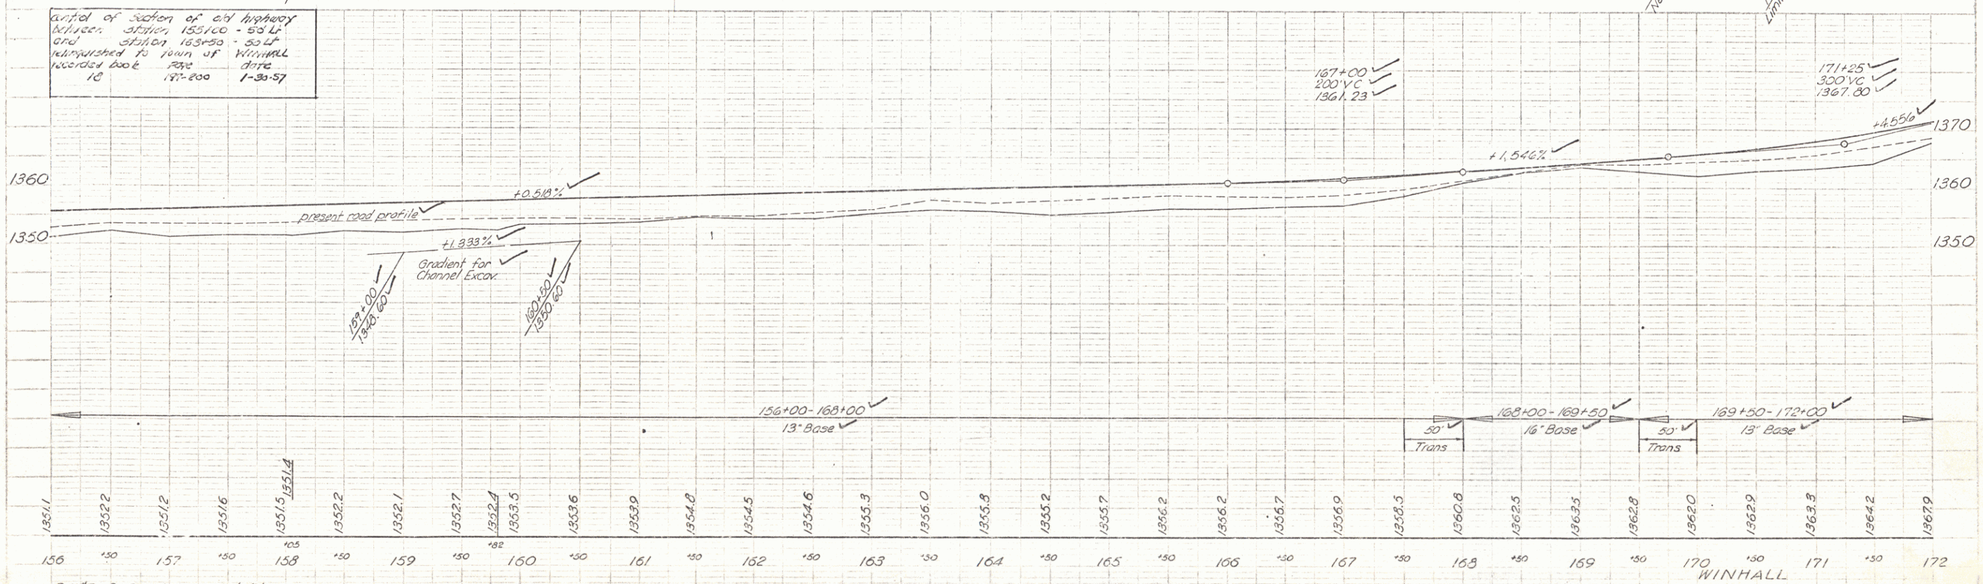

B.M. #7 S.I.R. 15" Elm 66' Lt Sta 171+19 El 1365.95

WINHALL
Proj. F-H No. 7-B
Sheet 15 of 78

8