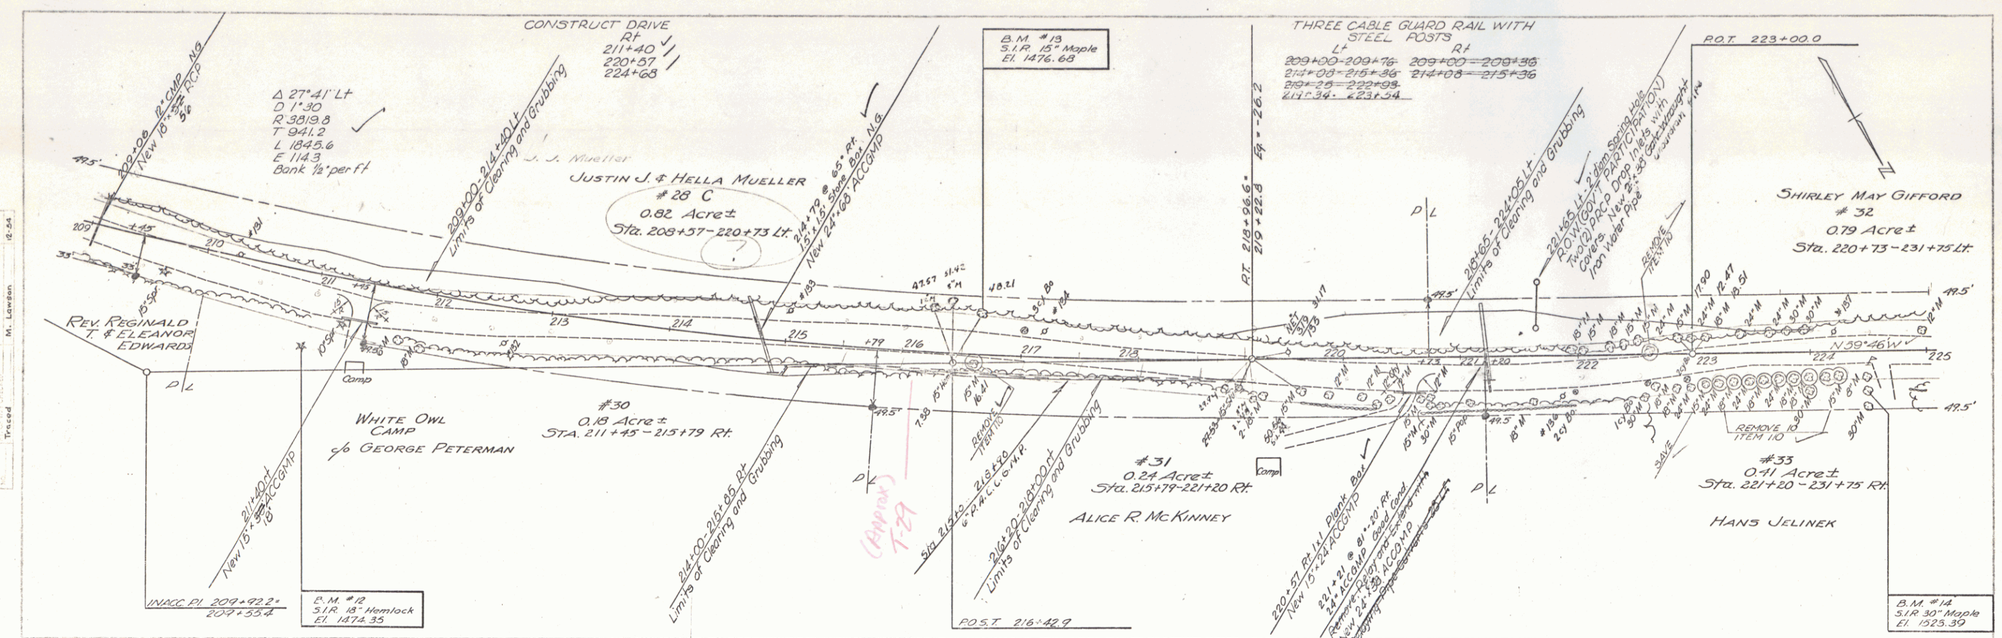

PARCEL	INSTRUMENT	DATE	GRANTOR	GRANTEE	RECORDED TOWN OF	Book	Page	Date	REMARKS	
30	COND.	2-25-55	WHITE OWL CAMP	ST. OF VT	WINHALL	17	382-400	3-3-55	See report & notice of hearing	216+00
31	COND.	2-25-55	ALICE R. MCKINNEY	ST. OF VT	WINHALL	17	382-400	3-3-55	See report & notice of hearing	300' VC
32	WDOE.	5-31-55	SHIRLEY MAY GIFFORD	ST. OF VT.	WINHALL	18	16-17	7-14-55	See also Sheet 20.	1474.80
33	COND.	2-25-55	HANS JELINEK	ST. OF VT	WINHALL	17	382-400	3-3-55	See report & notice of hearing See also Sheet 20	

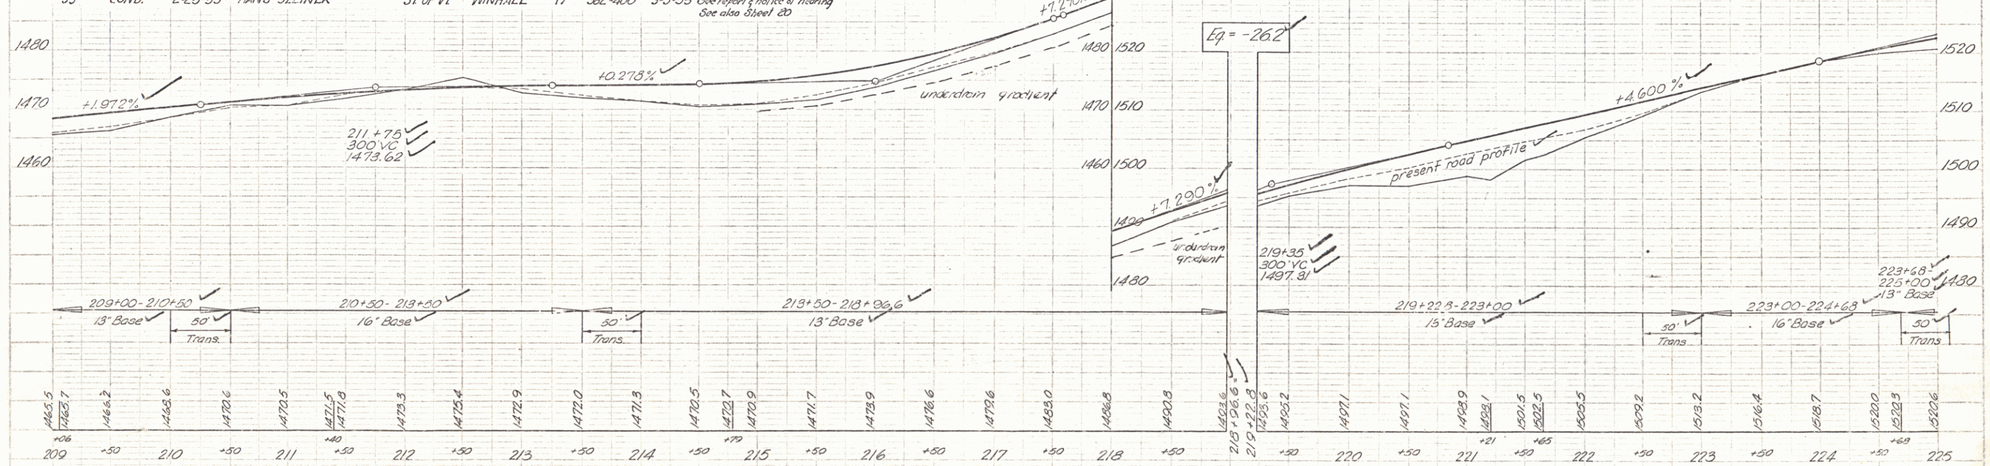

B.M. #12 S.I.R. 18" Hemlock Sta 210+96 64' Rt. El. 1474.35
B.M. #13 S.I.R. 15" Maple Sta 216+67 35' Lt. El. 1476.68
B.M. #14 S.I.R. 30" Maple Sta 224+49 34' Rt. El. 1523.39

WINHALL
Project FHA-78
Sheet 17 of 78