


Traced by M. Lawson 12-54

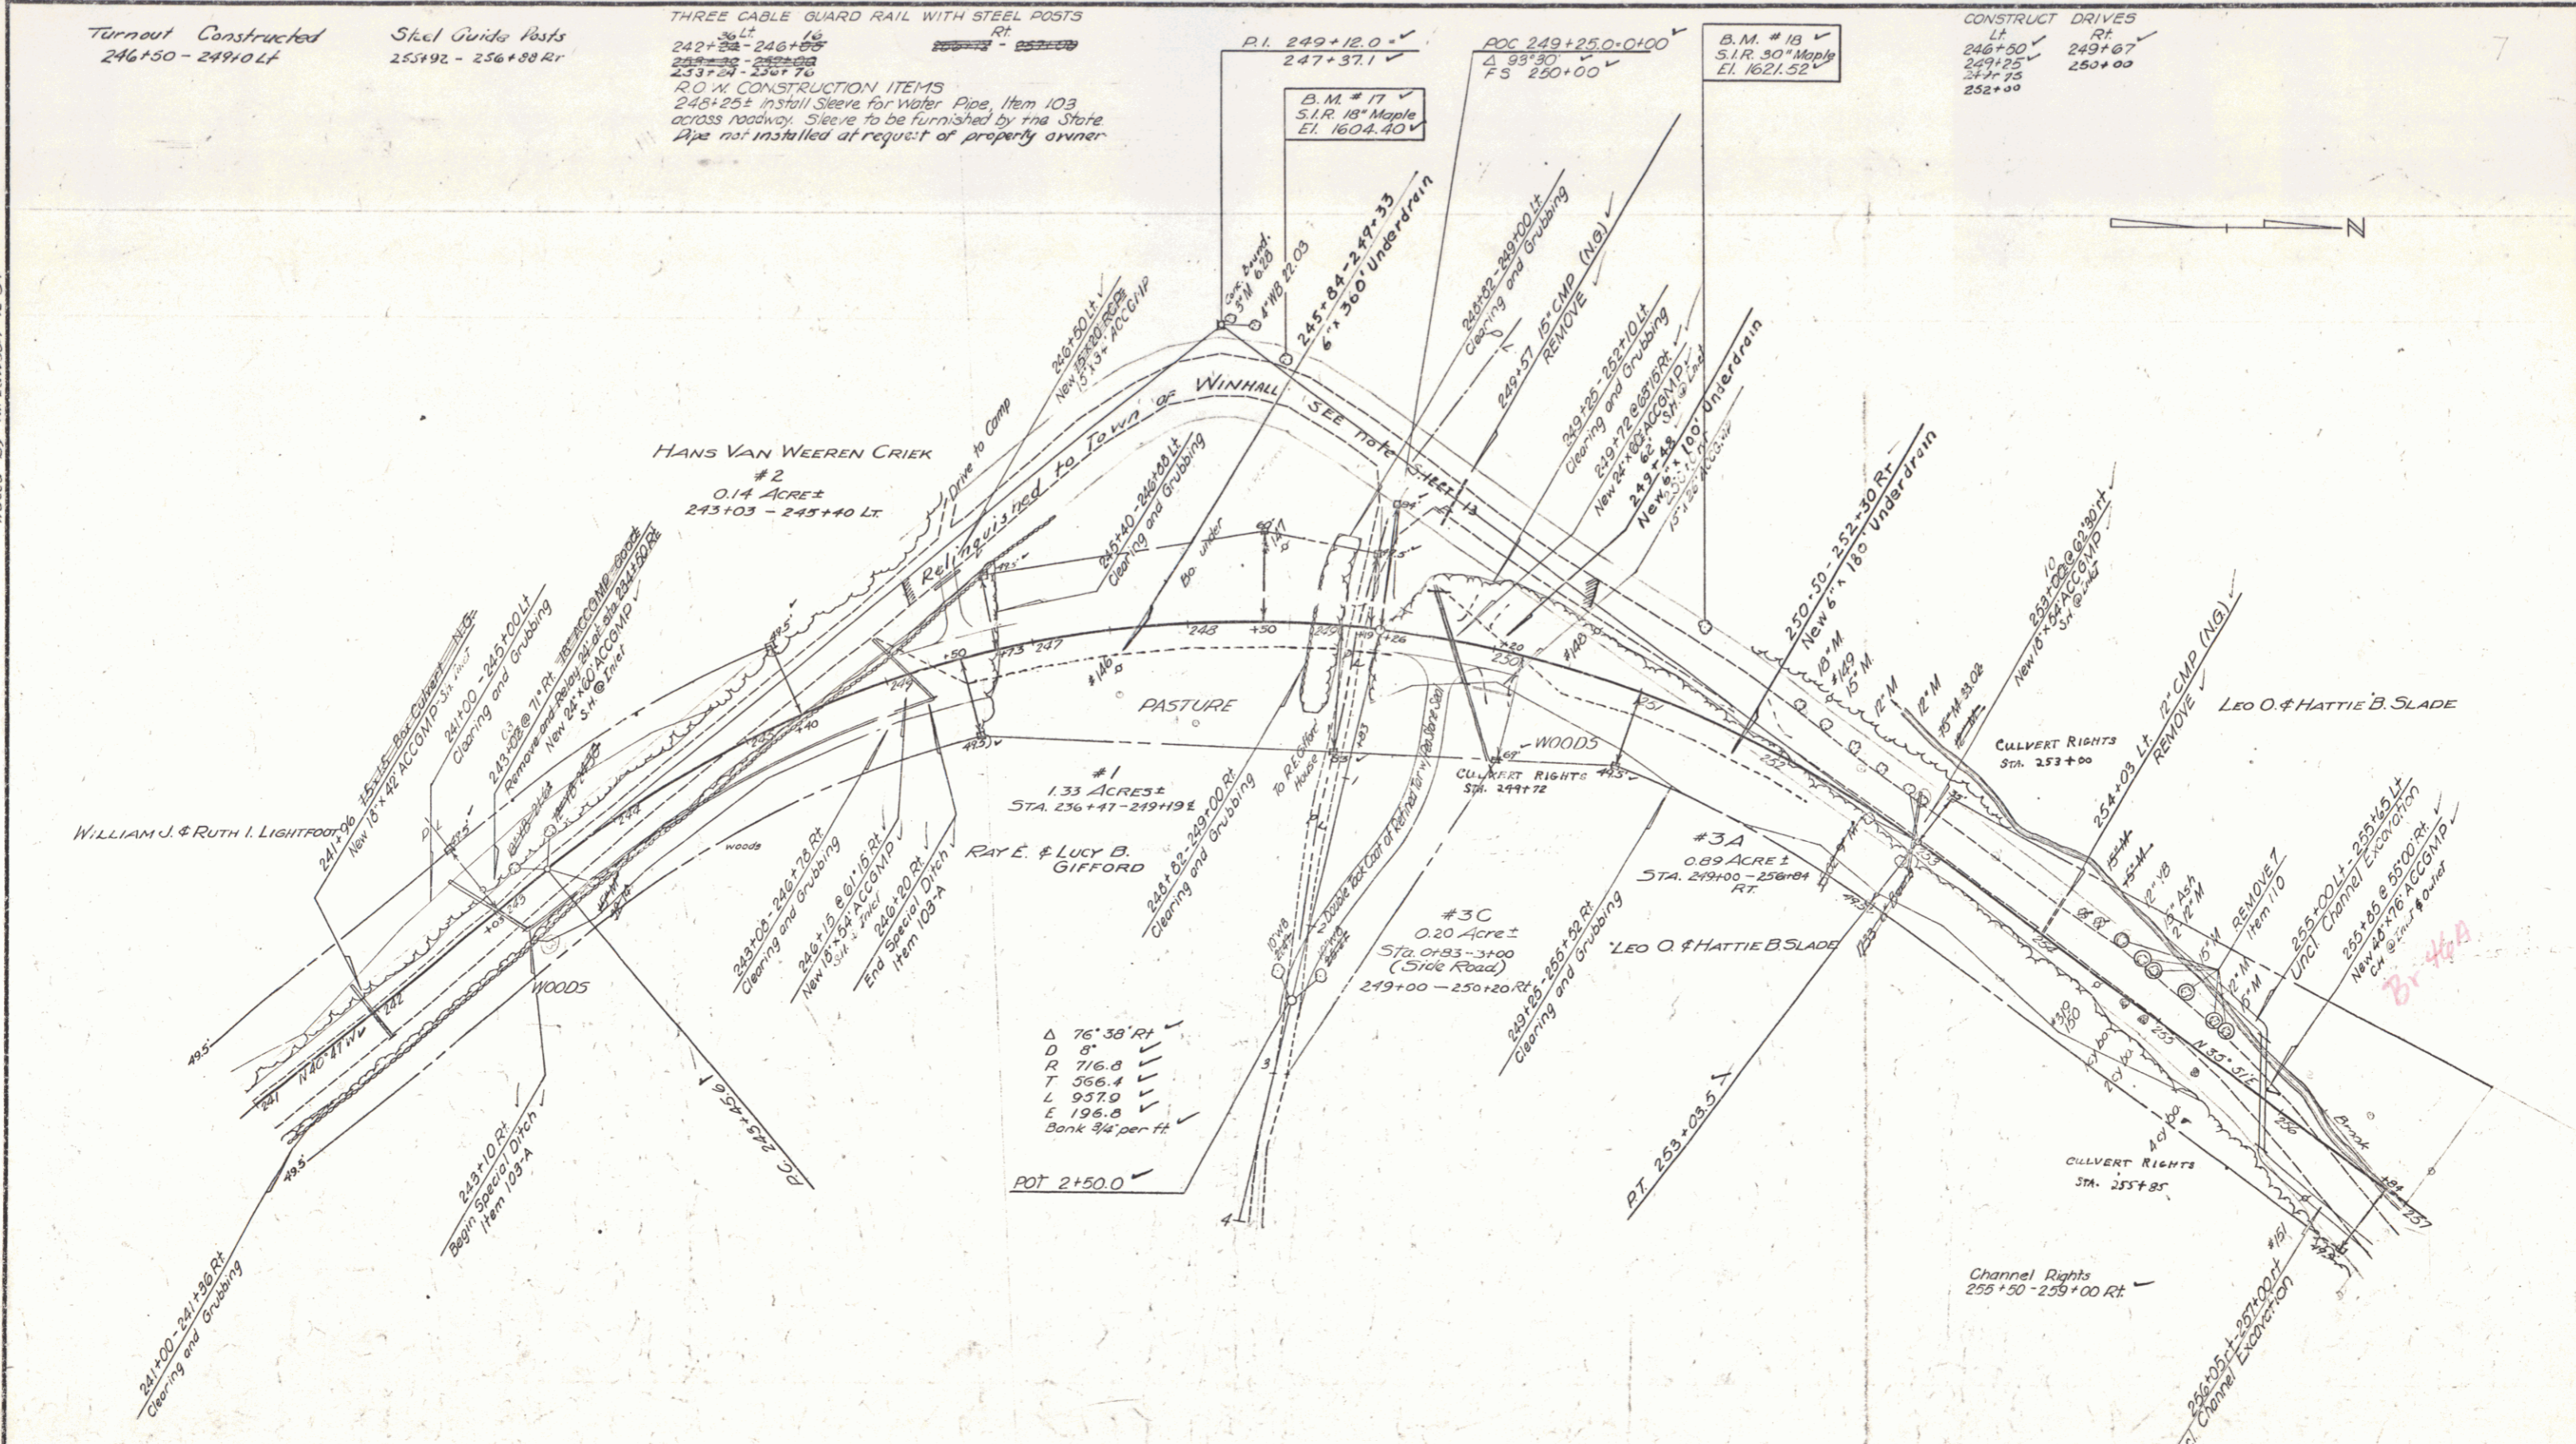

PARCEL	INSTRUMENT	DATE	GRANTOR	GRANTEE	RECORDED	BOOK	PAGE	DATE	REMARKS
1	W.D.E.	1-19-54	RAY E. & LUCY B. GIFFORD	ST OF VT	WINHALL	43	108-109	2-3-54	See also sheet 14
2	Cond.	7-8-35	HANS VAN WEEREN CRIEK	ST OF VT	WINHALL	17	445-460	7-9-35	See ref. notice of hearing.

WINHALL
 Project #143 (L)
 Sheet 14 of 155