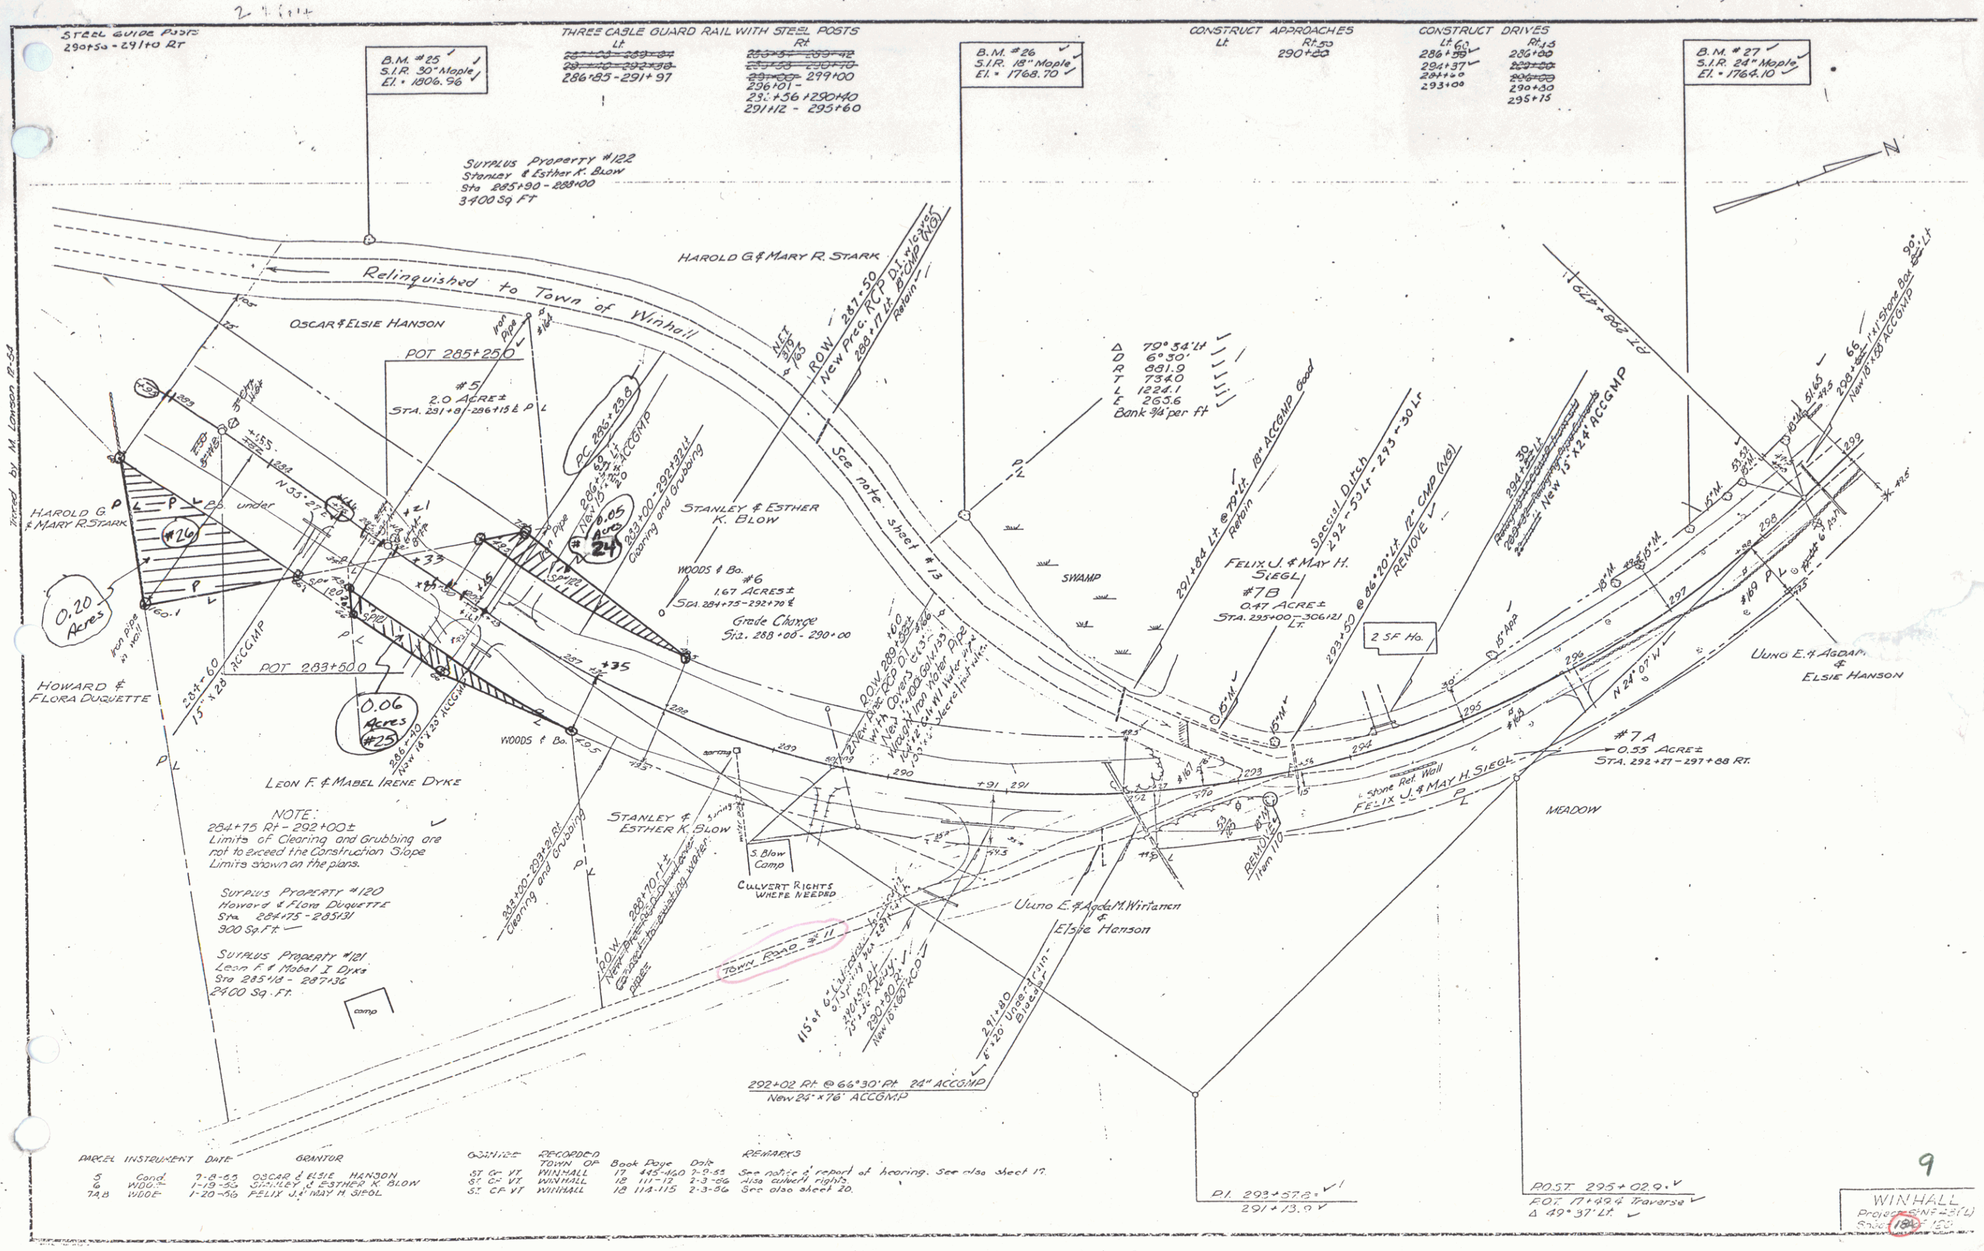

PARCEL	INSTRUMENT	DATE	GRANTOR	GRANTEE	RECORDED	Book	Page	Date	REMARKS
5	Cond.	7-8-55	OSCAR & ELSIE HANSON	ST. GR. VT.	TOWN OF WINHALL	17	443-460	7-8-55	See notice & report of hearing. See also sheet 17.
6	WDE	1-19-56	STANLEY & ESTHER K. BLOW	ST. GR. VT.	WINHALL	18	111-112	2-3-56	also culvert rights.
7A,B	WDE	1-20-56	FELIX J. & MAY H. SIEGL	ST. GR. VT.	WINHALL	18	114-115	2-3-56	See also sheet 20.

Work by M. Lawson 12-54