STEEL GUIDE POSTS
324+0 APPROACH LT

THREE CABLE GUARD RAIL WITH STEEL POSTS
Lt ~~[illegible]~~
Rt

CONSTRUCT DRIVES
Lt
316+00
Rt
~~319+50~~
~~323+50~~
320+60
321+22

CONSTRUCT APPROACH
Lt
324+65
Rt

PLANK GUARD RAIL
320+25 LT.

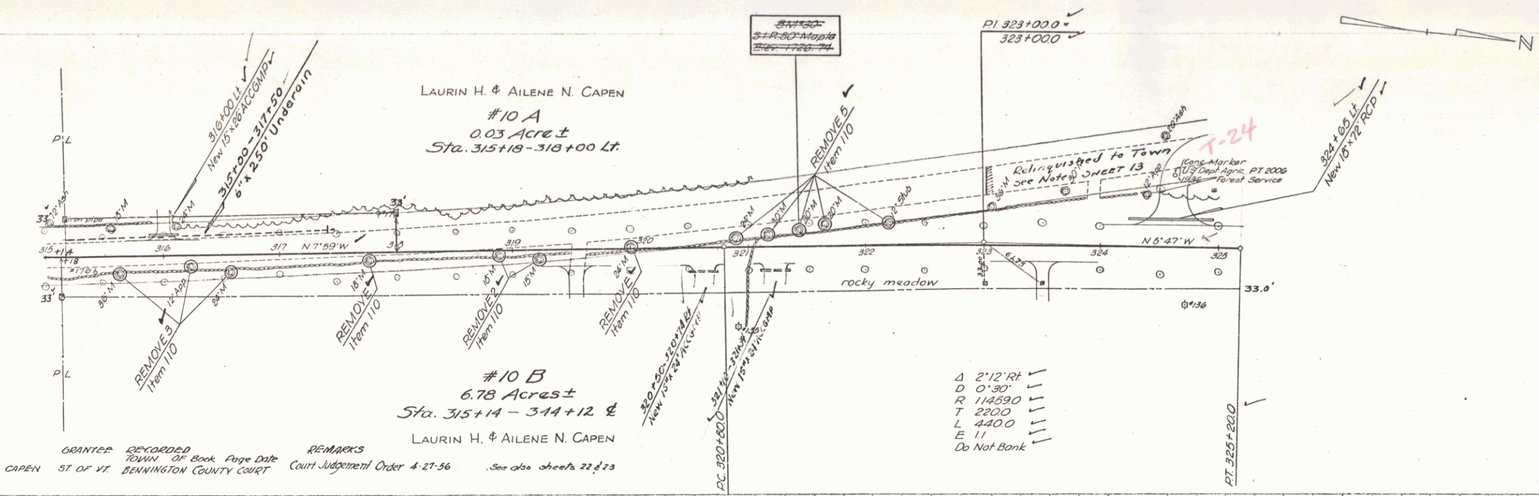

PARCEL	INSTRUMENT	DATE	GRANTOR	GRANTEE	RECORDED Town	Bk. Page	Date	REMARKS
10 ABC	C.J.O.		LAURIN H. & AILENE N CAPEN	ST OF VT.	BENNINGTON COUNTY COURT			Court Judgement Order 4-27-56

See also sheets 22 & 23

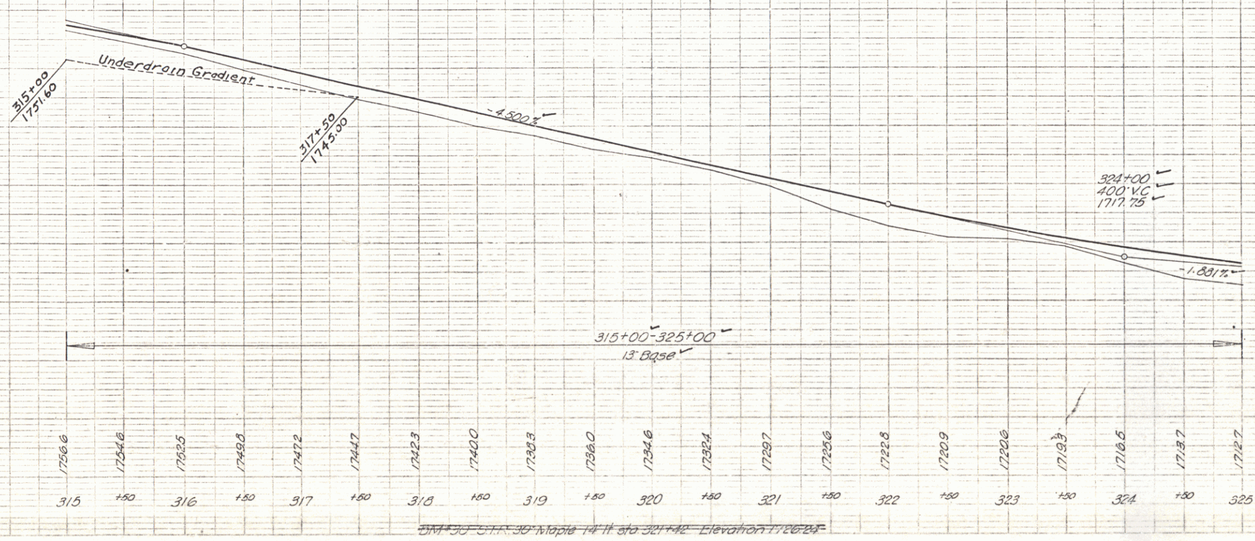

~~SM-50 S-H-50 Maple 14 ft sta 321+42 Elevation 1726.88~~

WINHALL
Proj. STR 43(1)
Sheet 21 of 120

11