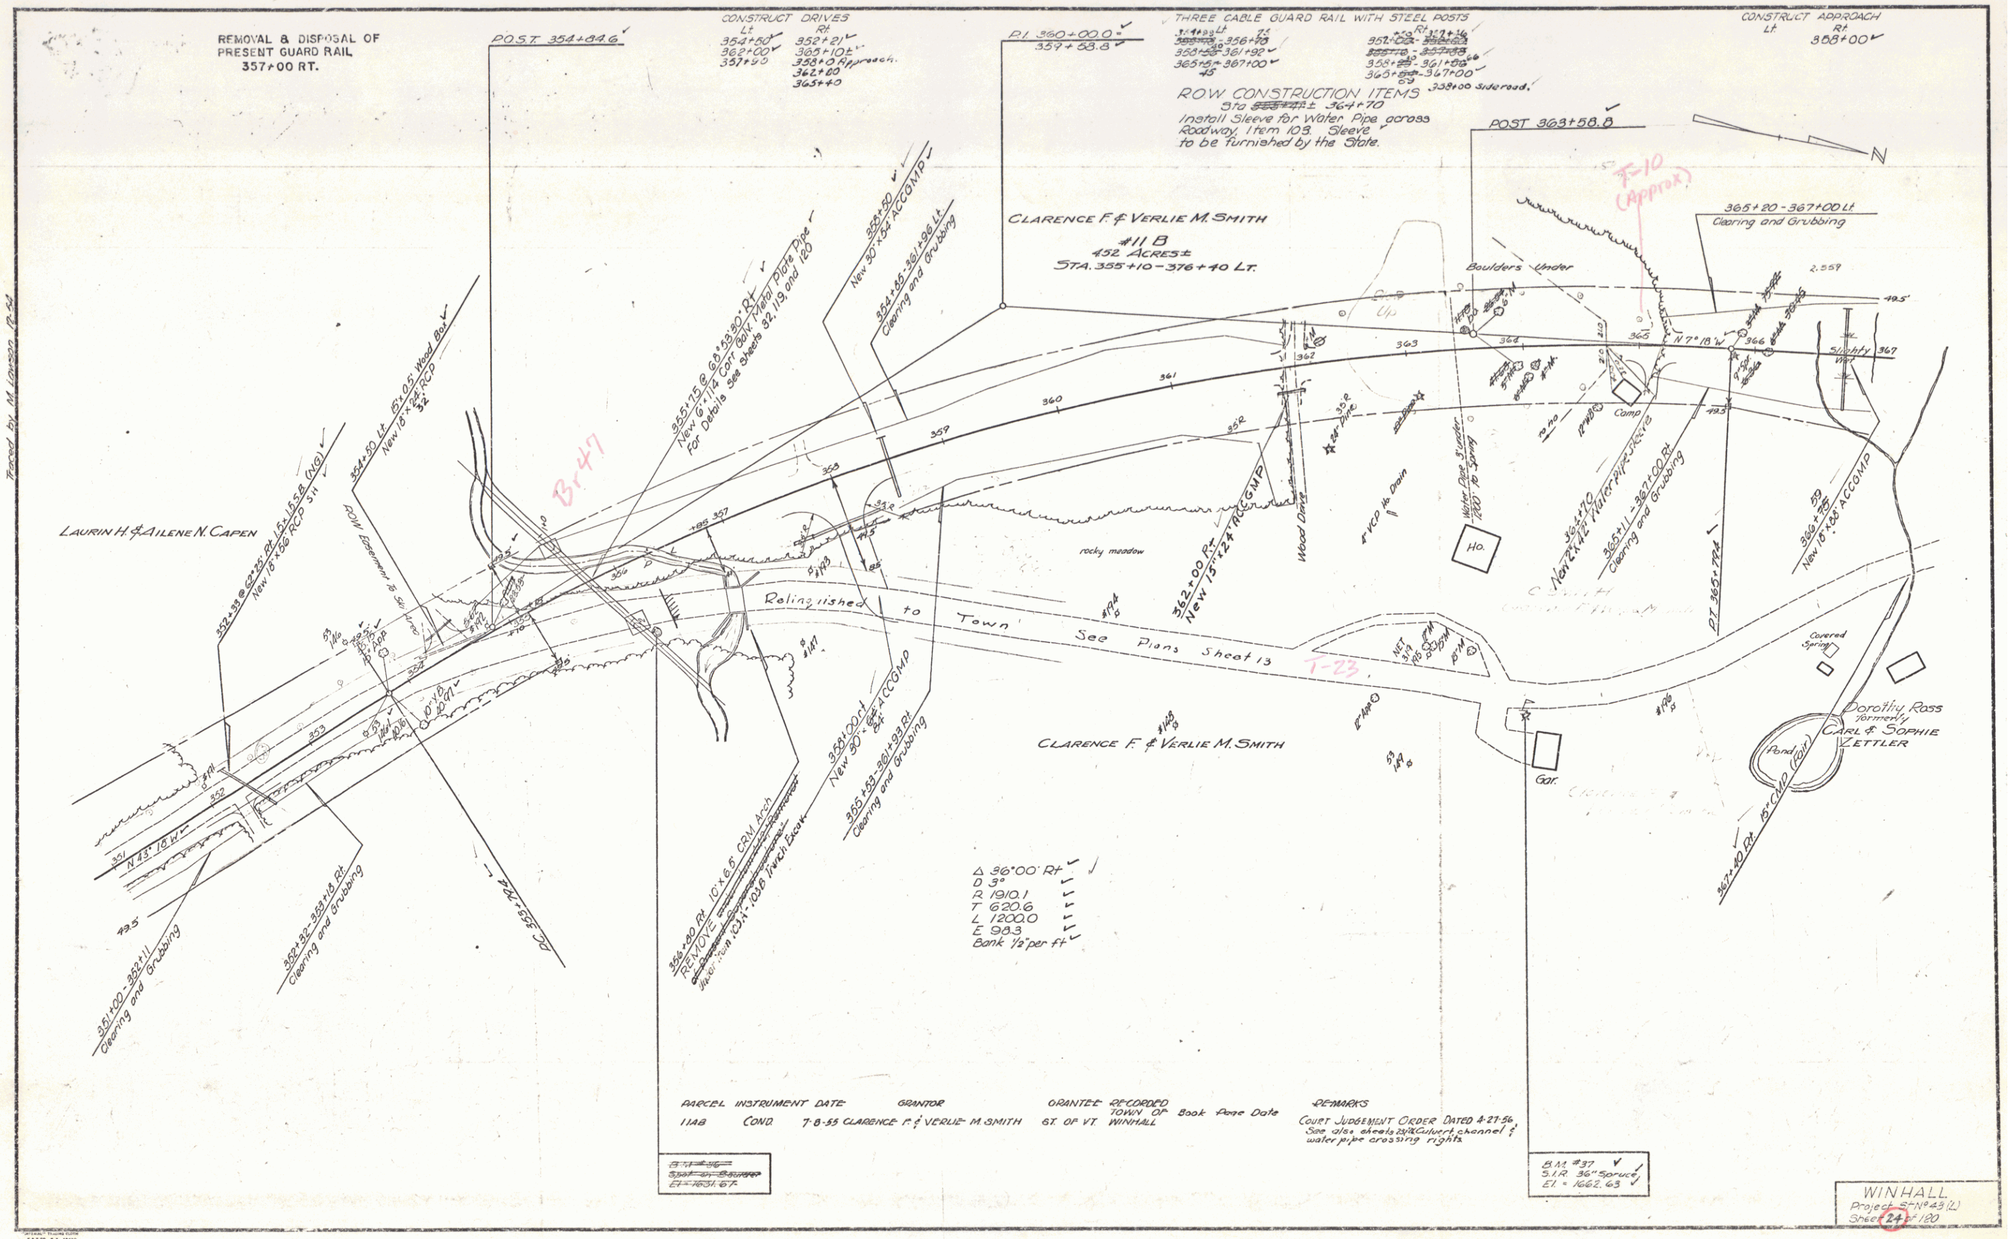
REMOVAL & DISPOSAL OF PRESENT GUARD RAIL 357+00 RT.
POST 354+44.6
CONSTRUCT DRIVES
Lt. 354+60, 362+00, 357+50
Rt. 352+21, 365+10 Lt., 358+0 Approach, 362+80, 365+40
PI 360+00.0
359+58.8
THREE CABLE GUARD RAIL WITH STEEL POSTS
CONSTRUCT APPROACH Rt. 368+00
ROW CONSTRUCTION ITEMS
Sta. 364+70
Install Sleeve for Water Pipe across Roadway, Item 108. Sleeve to be furnished by the State.
POST 363+58.8
CLARENCE F. & VERLIE M. SMITH
#11 B
452 ACRES±
STA. 355+10 – 376+40 LT.
365+20 - 367+00 Lt.
Clearing and Grubbing
Boulders Under
LAURIN H. & AILENE N. CAPEN
ROW Easement & Sec. Lines
rocky meadow
Relinquished to Town See Plans Sheet 13
CLARENCE F. & VERLIE M. SMITH
Covered Spring
Dorothy Ross formerly CARL & SOPHIE VETTLER
Pond
Garr.
Δ 36°00' Rt
D 3°
R 1910.1
T 620.6
L 1200.0
E 98.3
Bank 1/2" per ft
PARCEL INSTRUMENT DATE GRANTOR GRANTEE RECORDED TOWN OF Book Page Date REMARKS
11AB COND. 7-8-55 CLARENCE F. & VERLIE M. SMITH GT. OF VT. WINHALL
Court Judgement Order Dated 4-27-56 See also sheets 23 & 24 Culvert channel & water pipe crossing rights
B.M. #37
S.I.R. 36" Spruce
El. = 1662.63
WINHALL
Project S-F-N° 43(2)
Sheet 24 of 120