


FED. ROAD DIST. NO.	STATE	FAS PROJ. NO.	FISCAL YEAR	SHEET NO.	TOTAL SHEETS
9	VT	43 (1)	1963	4	36

E LINE
SEE SHEET 14 OF 36 FOR
DETAILS OF CONSTRUCTION

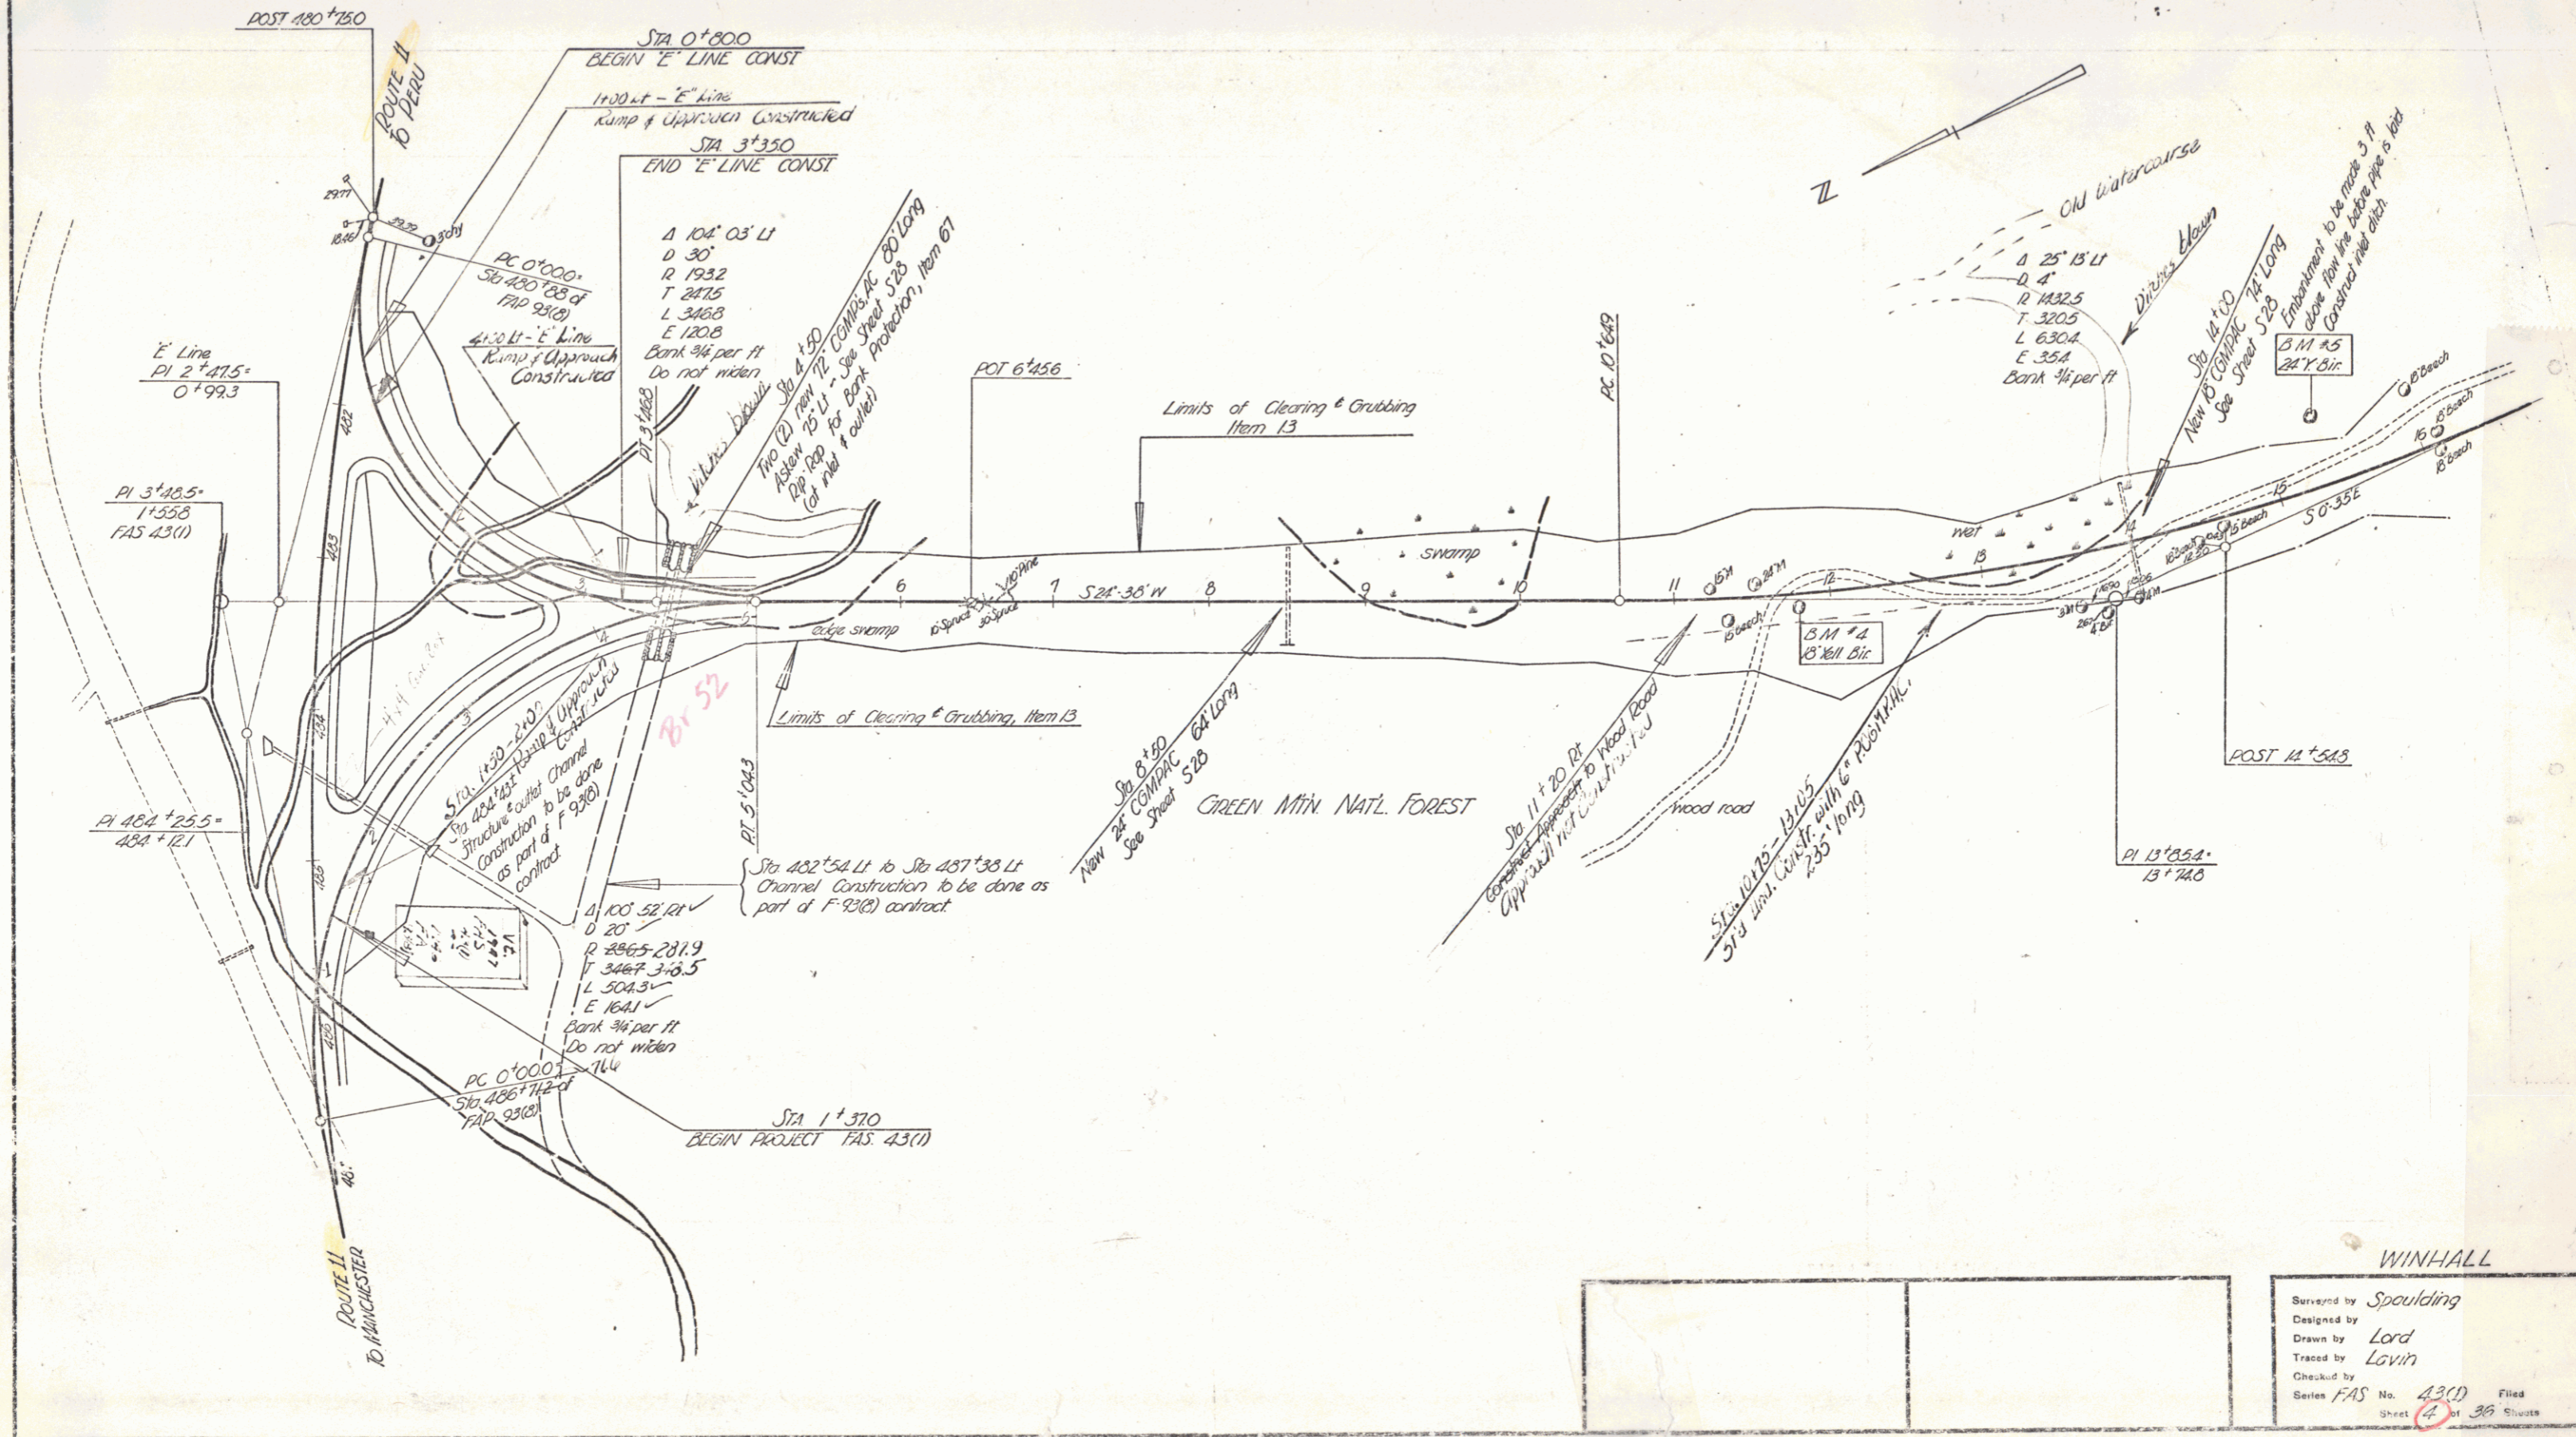

WINHALL

Surveyed by Spaulding
Designed by Lord
Drawn by Lovin
Traced by
Checked by
Series FAS No. 43(1) Filed
Sheet 4 of 36 Shows