FED. ROAD DIST. NO.	STATE	F.A.S. PROJ. NO.	FISCAL YEAR	SHEET NO.	TOTAL SHEETS
9	VT.	43(1)	1963	7	36

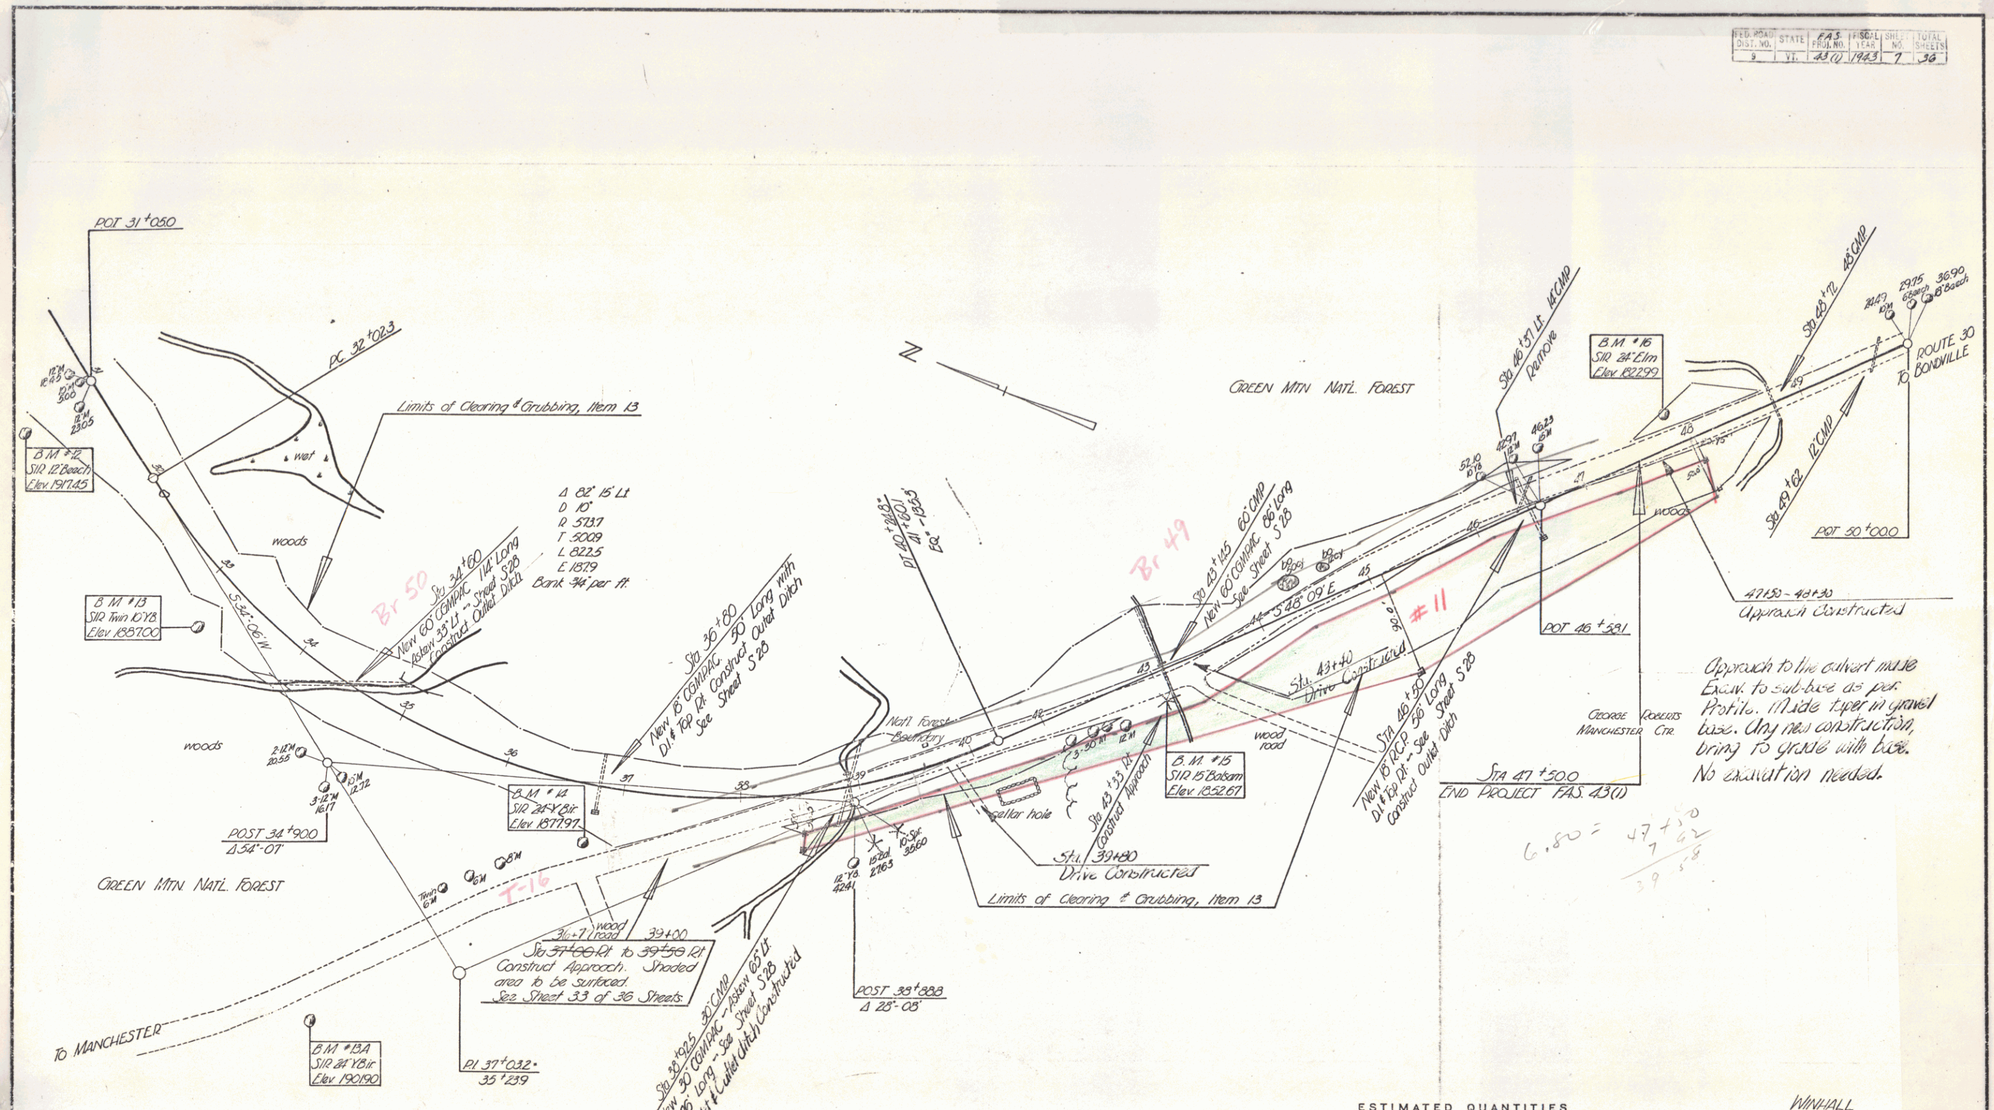

ESTIMATED QUANTITIES

WINHALL

Surveyed by Clone 641
Designed by
Drawn by
Traced by Loulou 546
Checked by
Series FAS No. 43(1) Filed
Sheet 7 of 36 sheets

4