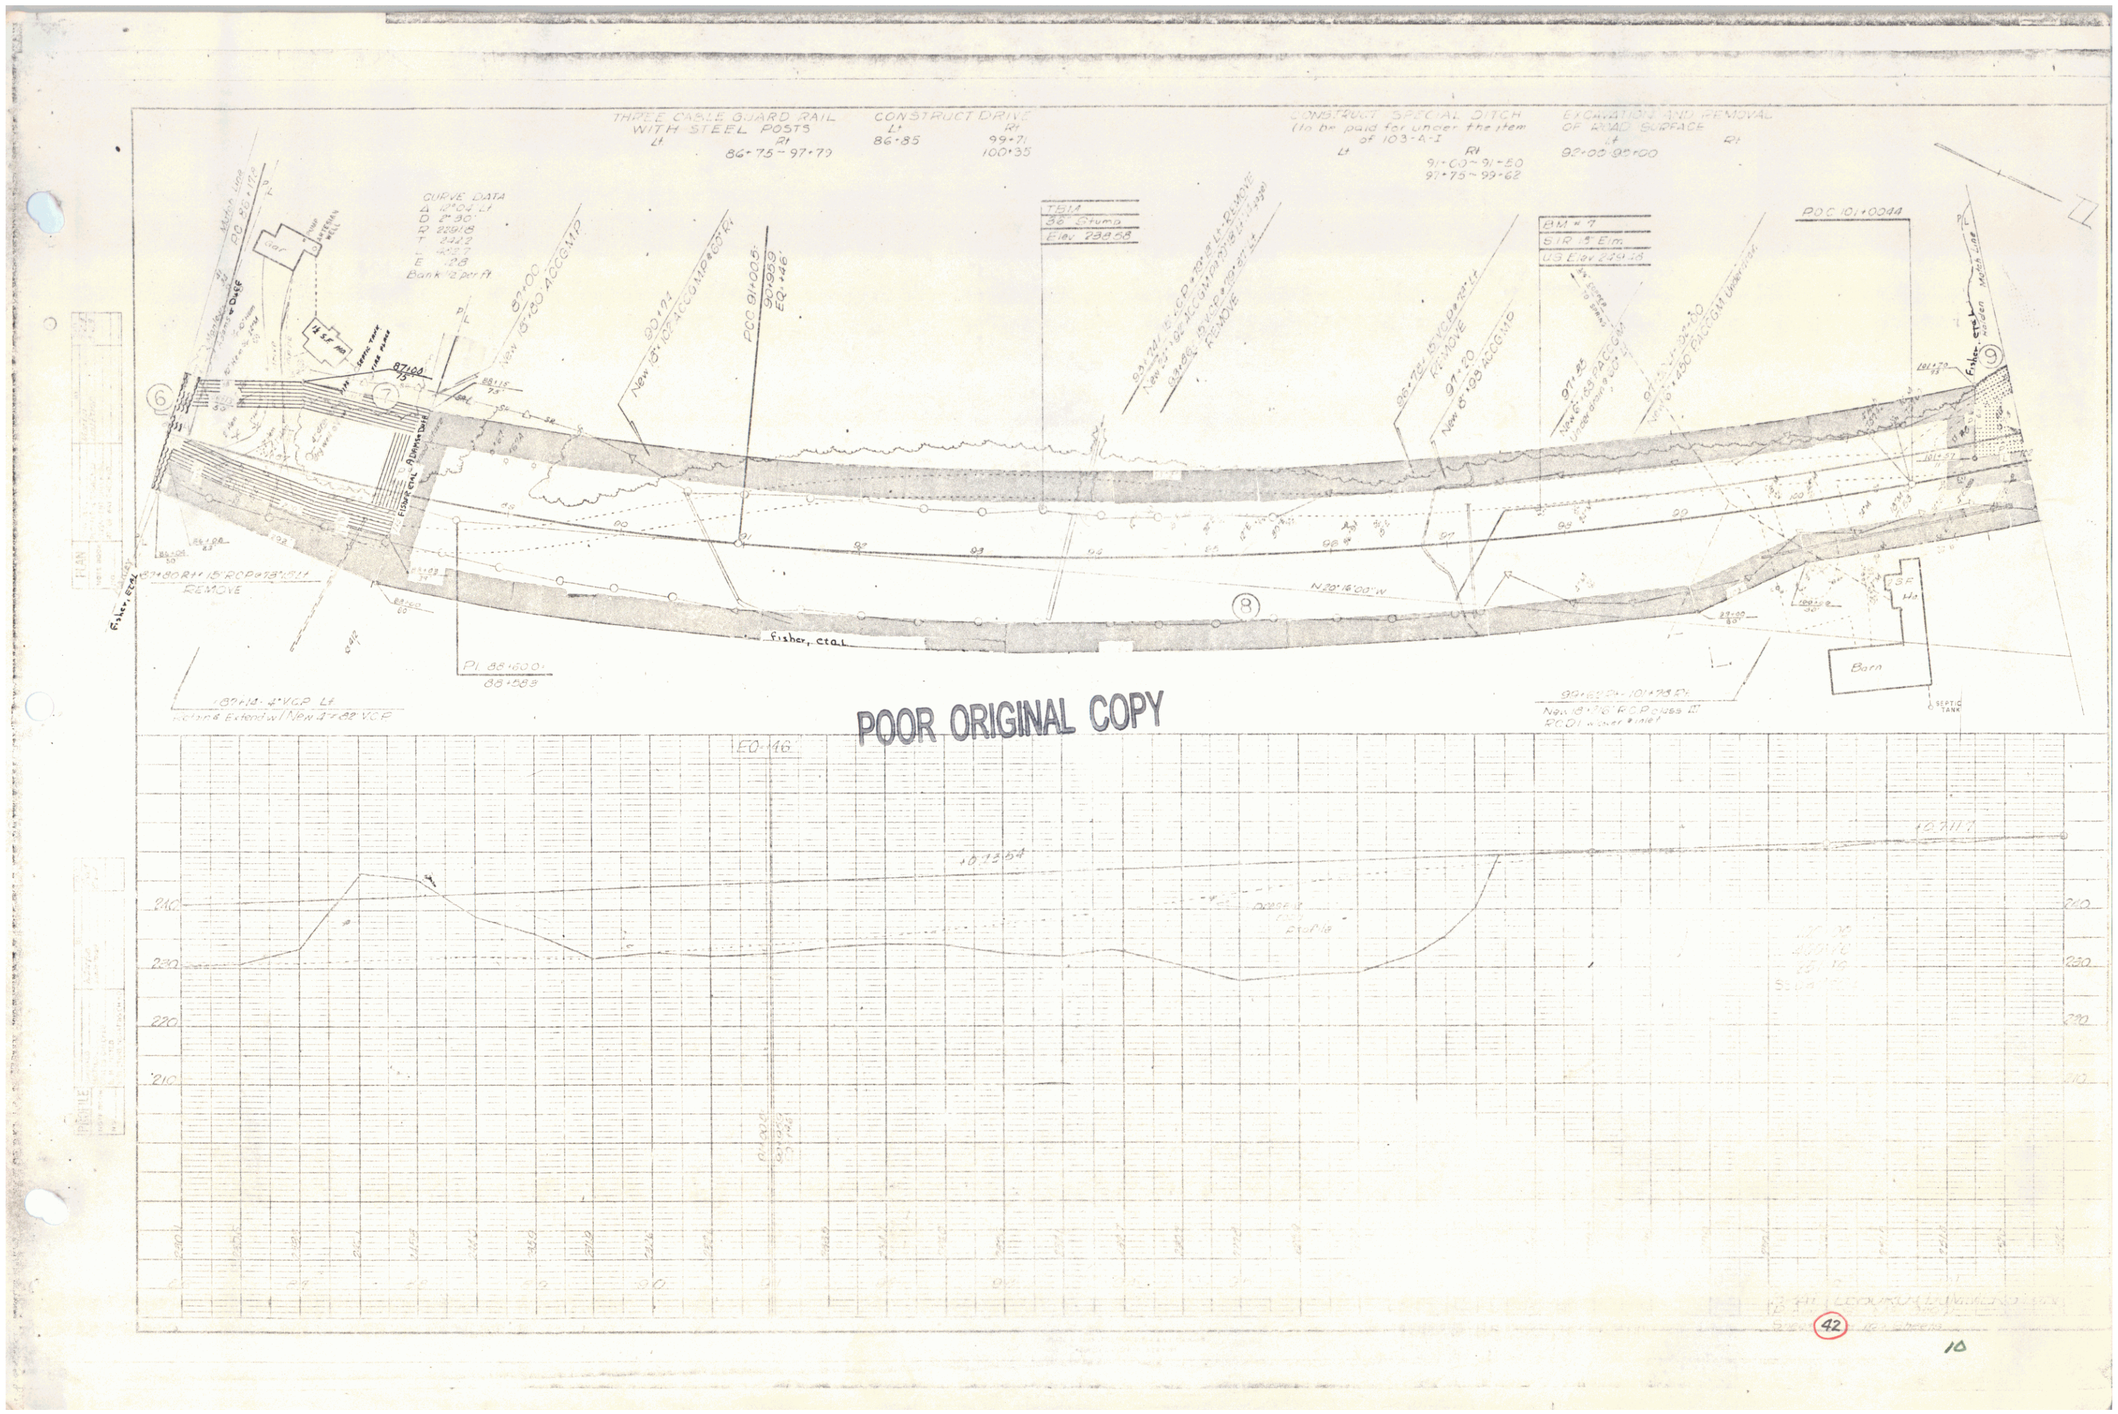
THREE CABLE GUARD RAIL WITH STEEL POSTS
Lt 86+75 – 97+79 Rt
CONSTRUCT DRIVE
Lt 86+85 Rt 99+71, 100+35
CONSTRUCT SPECIAL DITCH (to be paid for under the item of 103-A-1)
Lt 91+00 – 91+50, 97+75 – 99+62 Rt
EXCAVATION AND REMOVAL OF ROAD SURFACE
Lt 89+00, 99+00 Rt
CURVE DATA
Bank 12 per Pl
TBM 36" Stump Elev. 238.88
BM # 7
S.I.R. 3" Elm
U.S. Elev. 234.18
P.O.C. 101+00.44
Fisher, Ctr.L.
Fisher, Ctr.L.
Fisher, Ctr.L.
Fisher, Ctr.L.
Barn
Pl. 88+60.0
88+58.3
N 20°16'00" W
REMOVE
Existing Extend w/ New 4'+22' VCP
New 18"x76' R.C.P. Class III
P.O.C. 101+00.44
EQ. 146
Pl. 88+60.0
Fisher, Ctr.L.
Fisher, Ctr.L.
Fisher, Ctr.L.
Fisher, Ctr.L.
Barn
SEPTIC TANK
POOR ORIGINAL COPY
EQ. 146
240
230
220
210
42
10