



CONSTRUCT DRIVE WITH STEEL POSTS 18100-116+50 106+50
 THREE CABLE GUARD RAIL WITH STEEL POSTS 112+25-112+73 110+25-112+31 112+02-113+00
 DRILLING AND BLASTING OF SOLID ROCK SUBGRADE 104+75-105+75 106+75-110+75 115+00-113+00
 DEMOLITION AND DISPOSAL OF BUILDING 117+50(±)
 EXCAVATION AND REMOVAL OF ROAD SURFACE ON ROADWAYS 104+50-110+20
 UNCLASSIFIED CHANNEL EXCAVATION (East Side of the West River) 116+50-113+00 See sheets 174-175 of 125 sheets
 REMOVAL AND DISPOSAL OF PRESENT GUARD RAIL 125+22-110+50 112+10-112+30 112+24-112+38 112+60-113+00

CURVE DATA
 Δ 33° 38' 30" LT
 P 3626.50
 T 1296.0
 L 2493.0
 E 713.9
 Cone 4th per ft

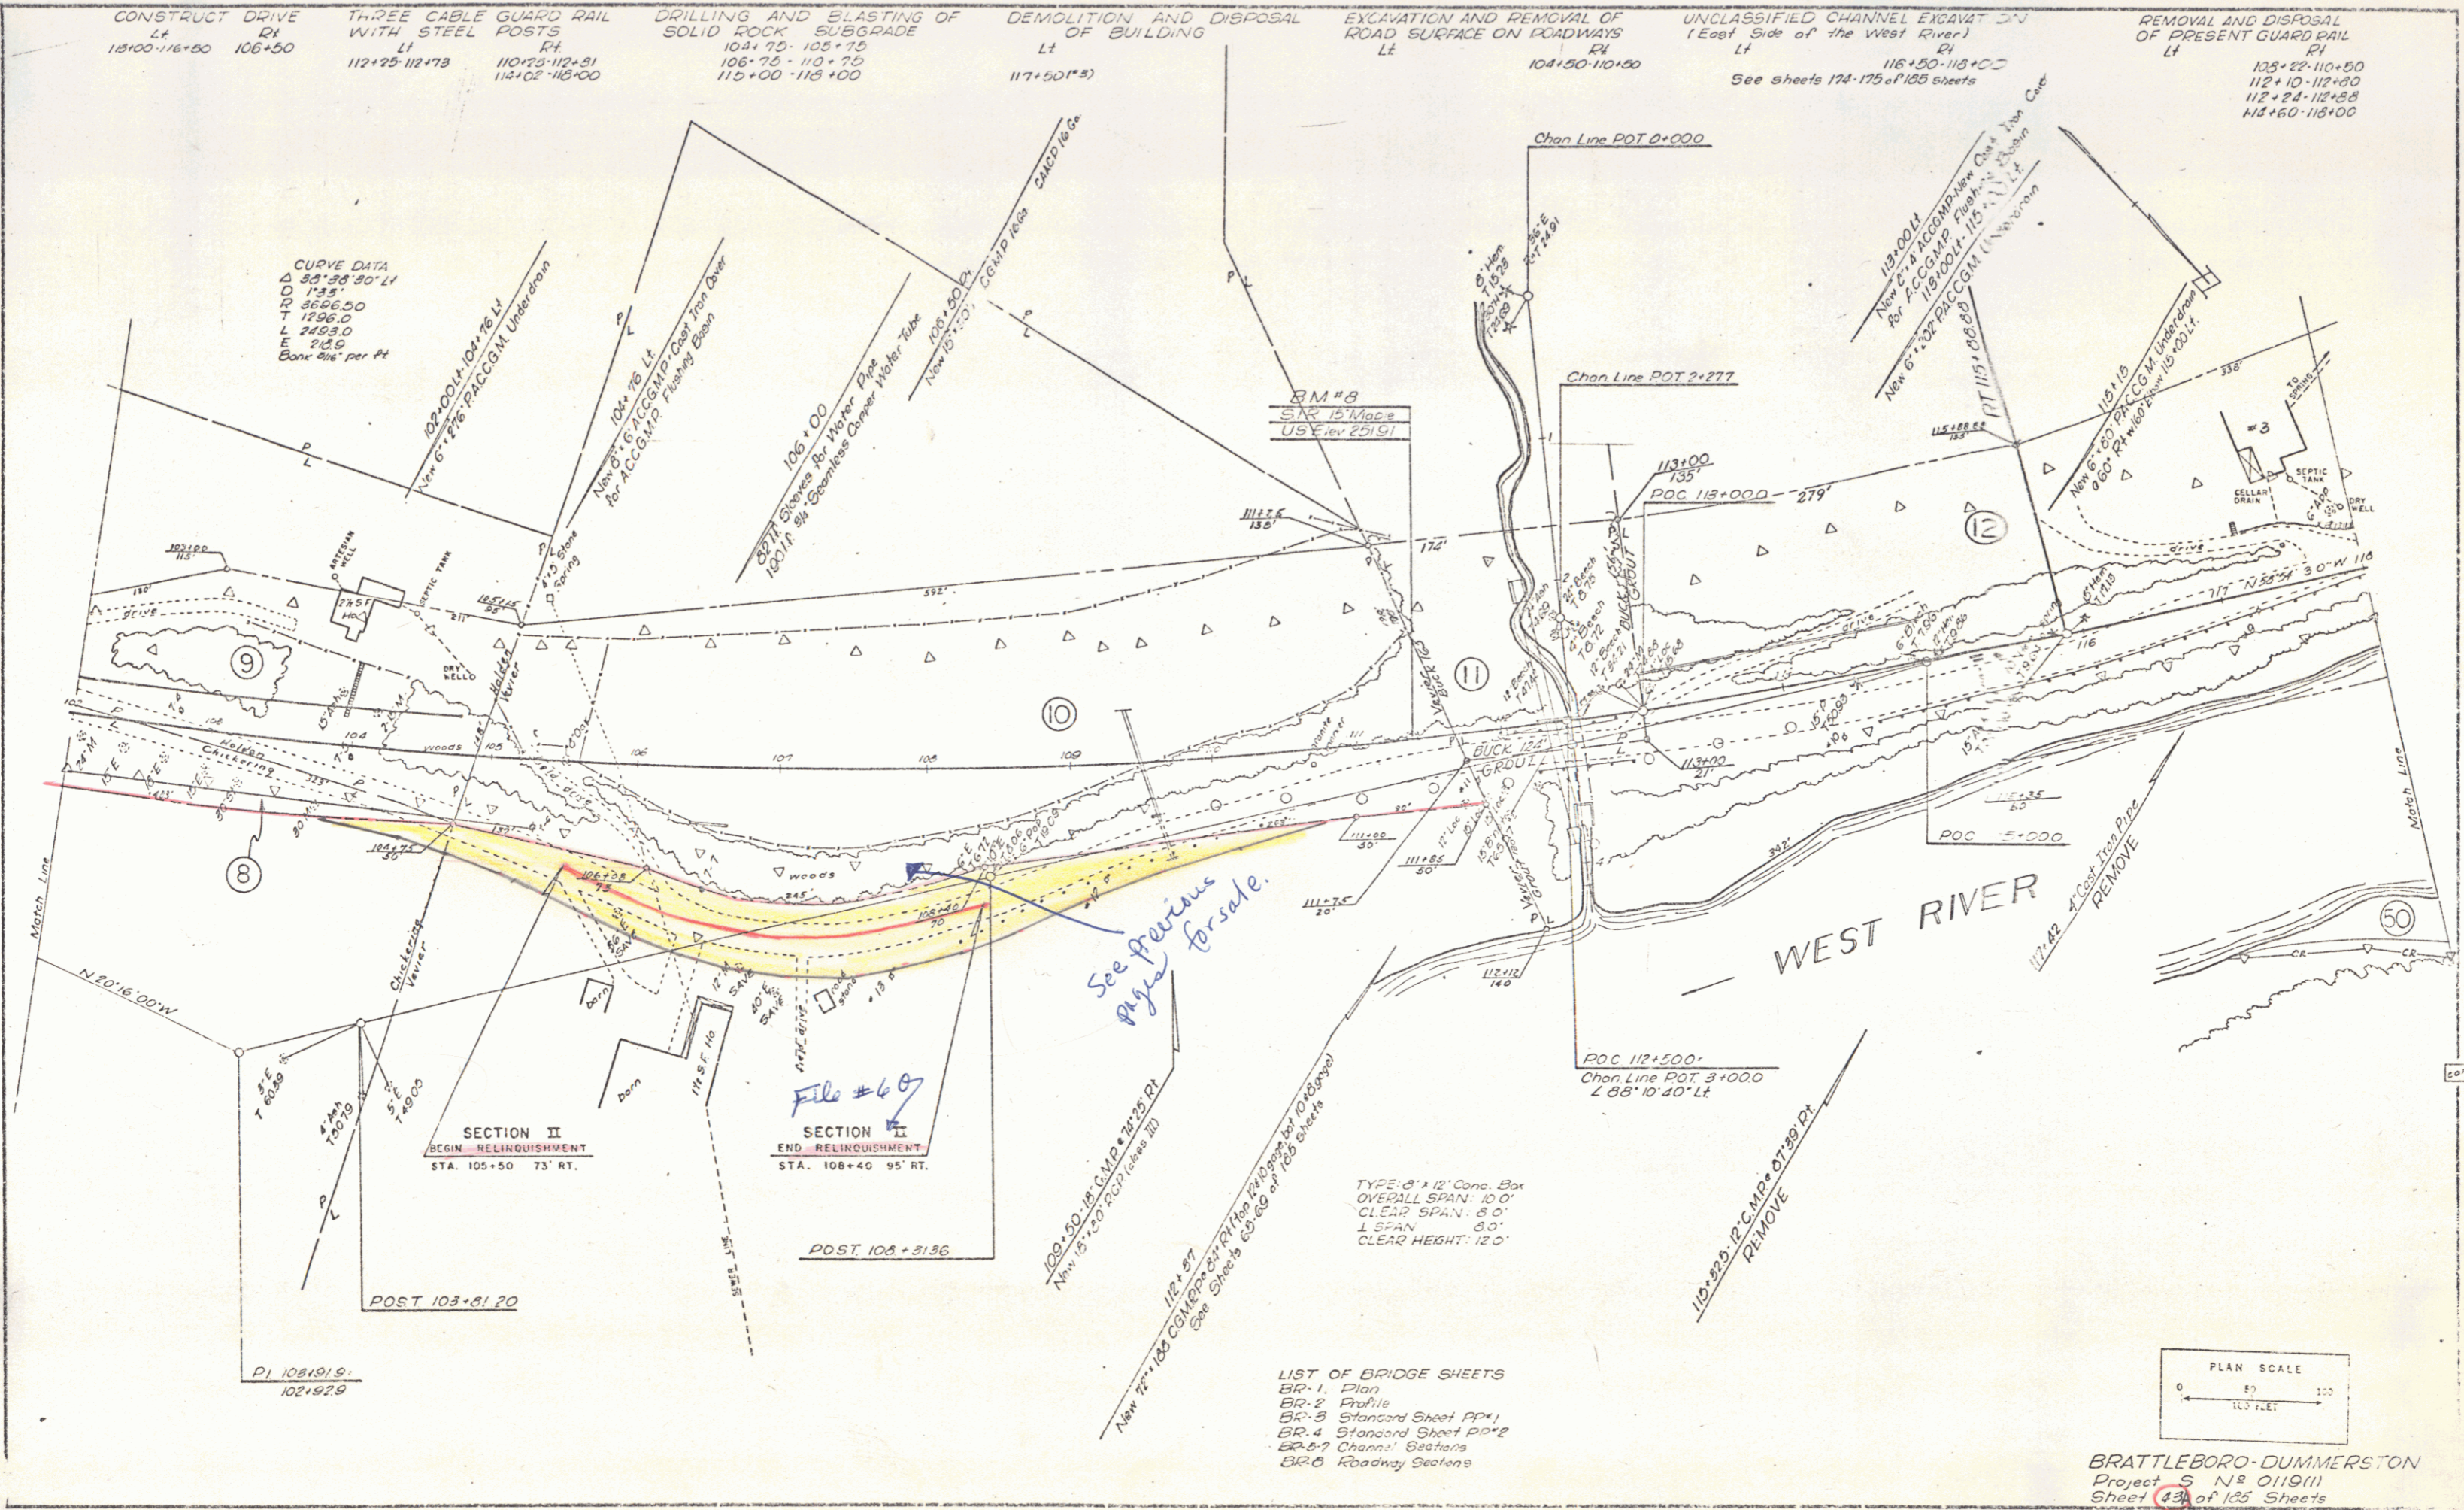

- LIST OF BRIDGE SHEETS
 BR-1 Plan
 BR-2 Profile
 BR-3 Standard Sheet AP*1
 BR-4 Standard Sheet PP*2
 BR-5 Chann'l Sections
 BR-6 Roadway Sections

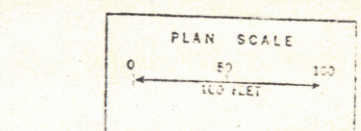

BRATTLEBORO-DUMMERSTON
 Project S N 0119111
 BR 1 of 6