THREE CABLE GUARD RAIL WITH STEEL POSTS
Lt Rt
352+00-354+65
355+10-361+88
362+95-362+98
363+16-368+30

STONE FILL FOR SLOPE PROTECTION (Heavy Type)
Lt Rt
Appr 0+30 Lt - Appr 1+47 Lt
355+80-360+75

UNCLASSIFIED CHANNEL EXCAVATION
Lt Rt
Appr 0+30 Lt - Appr 1+47 Lt
355+80-360+75

REMOVAL AND DISPOSAL OF PRESENT GUARD RAIL
Lt Rt
362+90-362+95
363+16-363+38

CONSTRUCT DRIVE
Lt Rt
358+58
359+75
360+87
354+75
366+00
355+60

CONSTRUCT APPROACH
Lt Rt
365+09
363+20

EXCAVATION AND REMOVAL OF ROAD SURFACES AND/OR PAVEMENTS
Lt Rt
352+00-352+50
362+25-362+95
363+25-368+00

WIDEN SHOULDER 4 FEET
Lt Rt
352+15-357+85

STONE FILL FOR SLOPE PROTECTION (Light Type)
Lt Rt
352+00-354+42

2" TOPSOIL
Lt Rt
358+50-360+00

STEEL GUIDE POSTS @ 16' c/c
Lt Rt
Appr 0+50 Rt - Appr 2+54 Rt
Appr 0+30 Lt - Appr 2+25 Lt

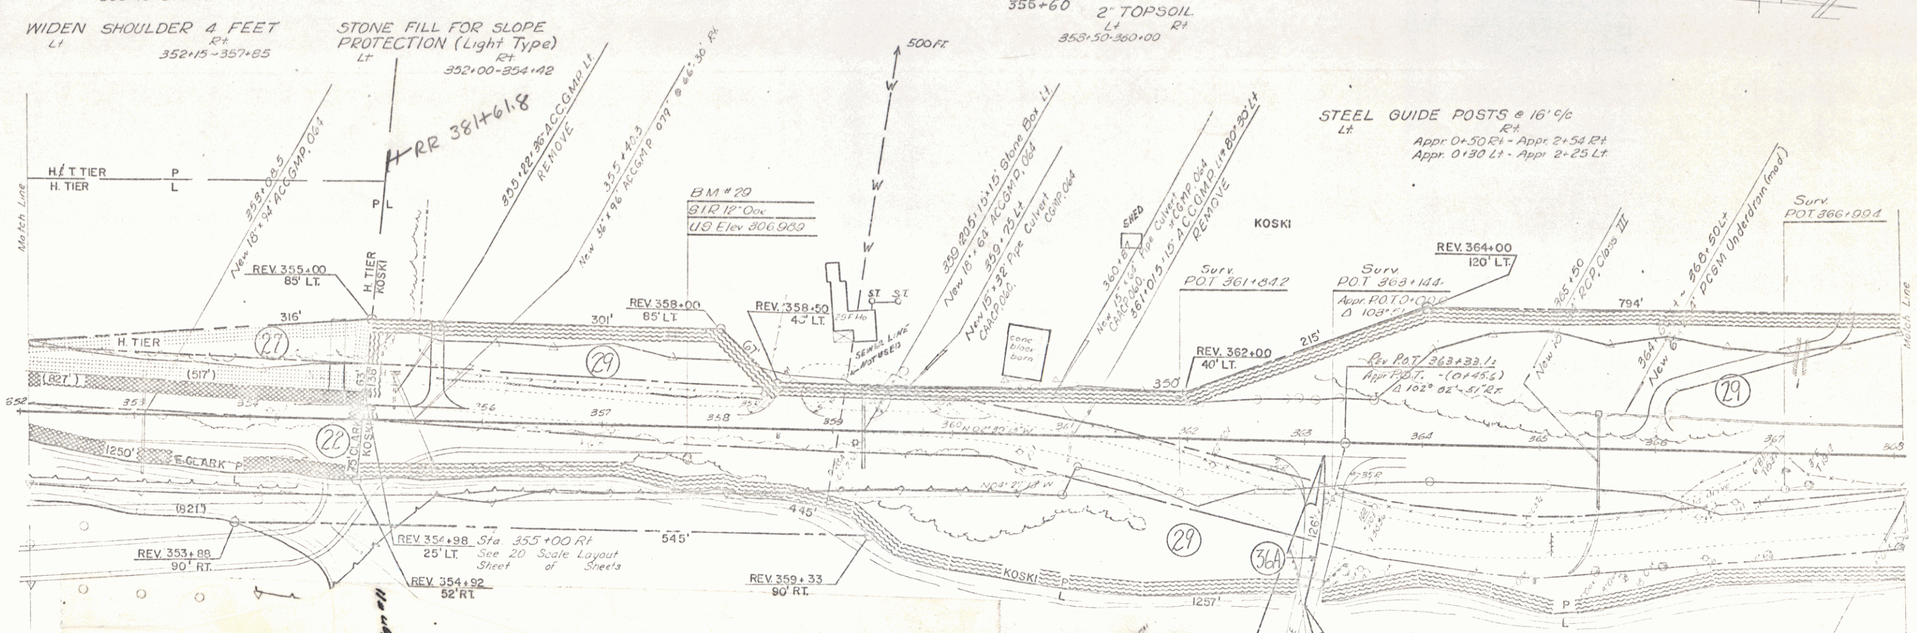

SURVEYED BY Jewett DATE Sep 1964
DRAWN BY Banks DATE Nov 1964
TRACED BY Lourman DATE Dec 1964
DUMMERSTON
PROJ. 3 NO. 0119(2)
SHEET 22 OF 44