THREE CABLE GUARD RAIL WITH STEEL POSTS
Lt 438+41-439+37
Rt 444+47-445+00

TREATED TIMBER CURB
Lt
Rt 434+00-440+01

DRILLING AND BLASTING OF SOLID ROCK SUBGRADE
432+00-442+50

EXCAVATION AND REMOVAL OF ROAD SURFACES & PAVEMENTS
Lt
Rt 432+00-445+00

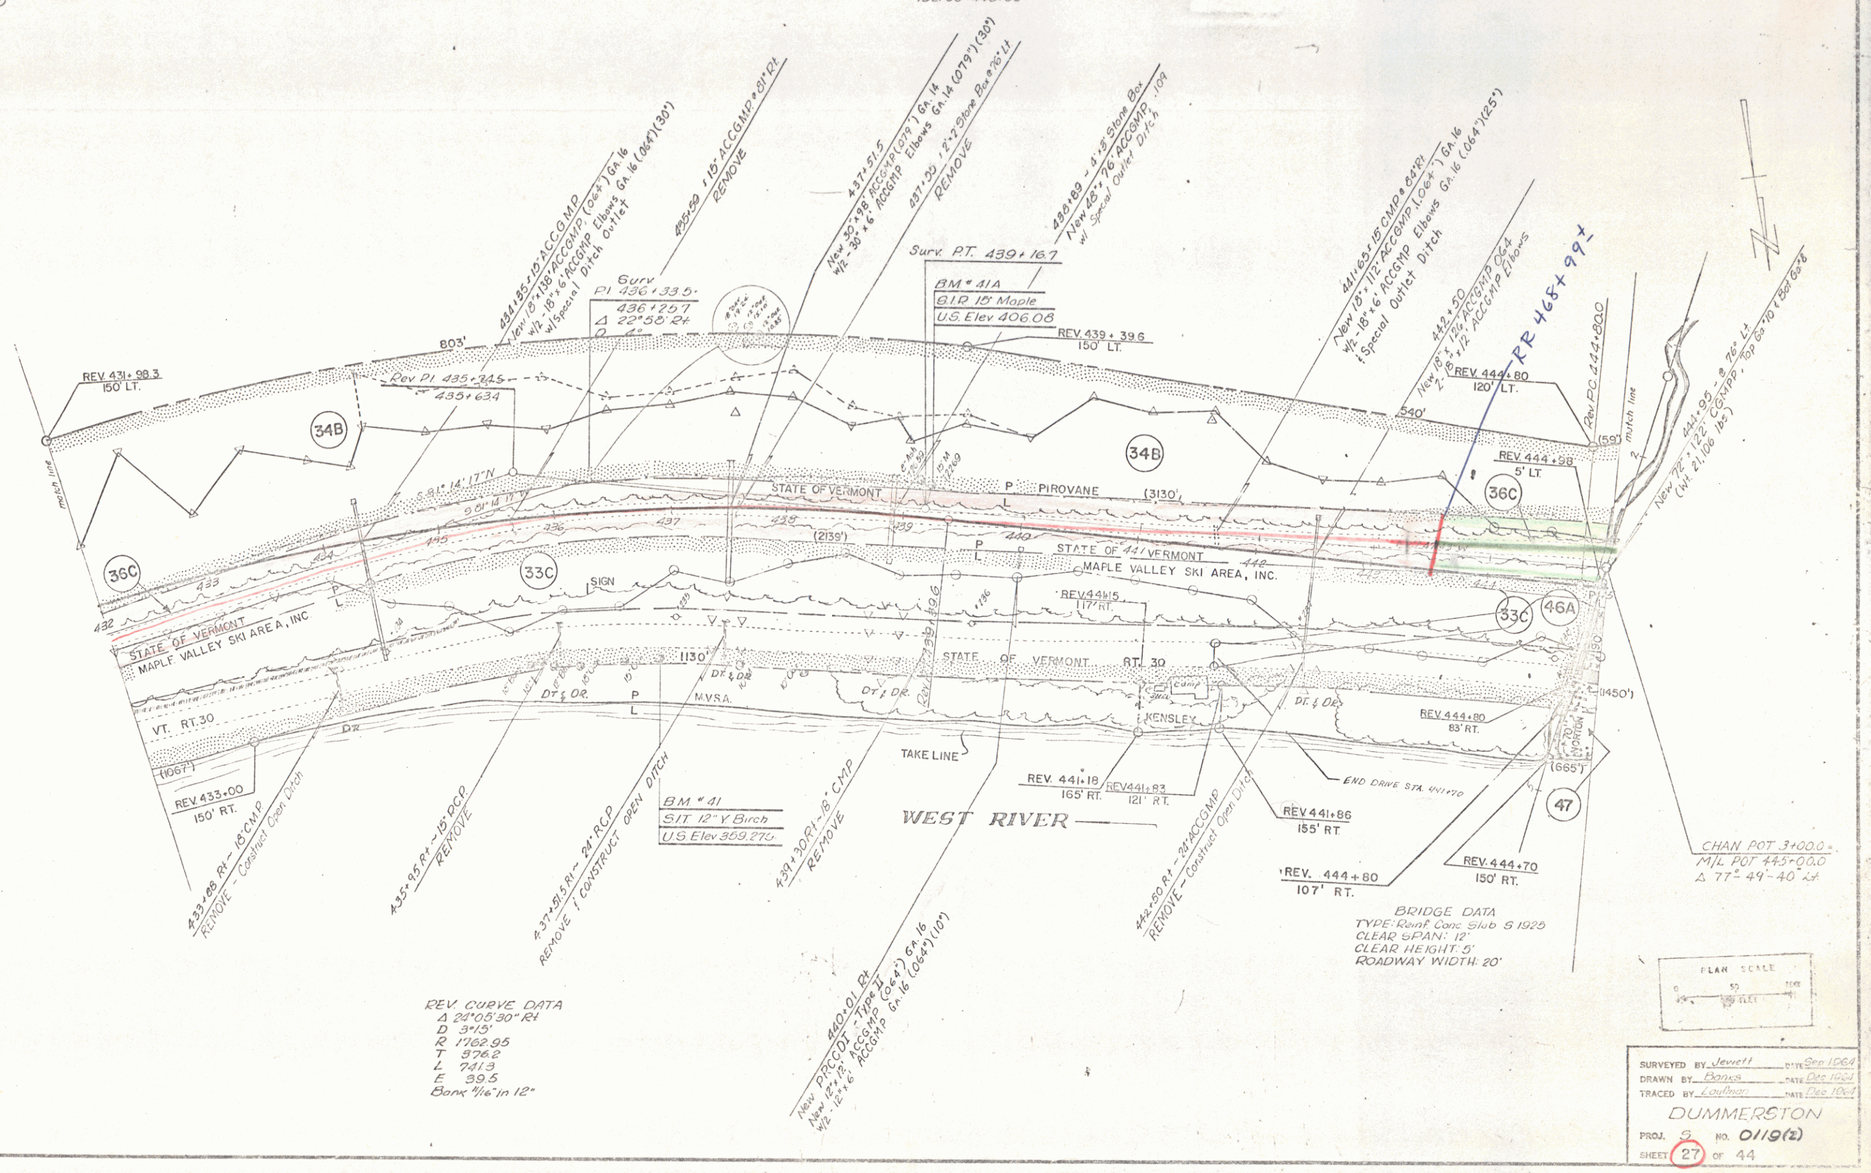

REV. CURVE DATA
Δ 24°05'30" Rt
D 3°15'
R 1762.95
T 376.2
L 741.3
E 39.5
Bank 1/16" in 12"

SURVEYED BY Jewett DATE Sep 1964
DRAWN BY Banks DATE Dec 1964
TRACED BY Laufman DATE Dec 1964

DUMMERSTON
PROJ. S NO. 0119(2)
SHEET 27 OF 44

15