


1.08: All ground now in place on this project except that designated to be rest is to be removed and is to become the property of the State of Vermont.

PARCEL	INSTRUMENT	DATE	GRANTOR	GRANTEE	RECORDED	REMARKS
ABC	M.O.	8-25-37	A.G. SHAFER	STATE OF VT	29 408-410	8-28-37

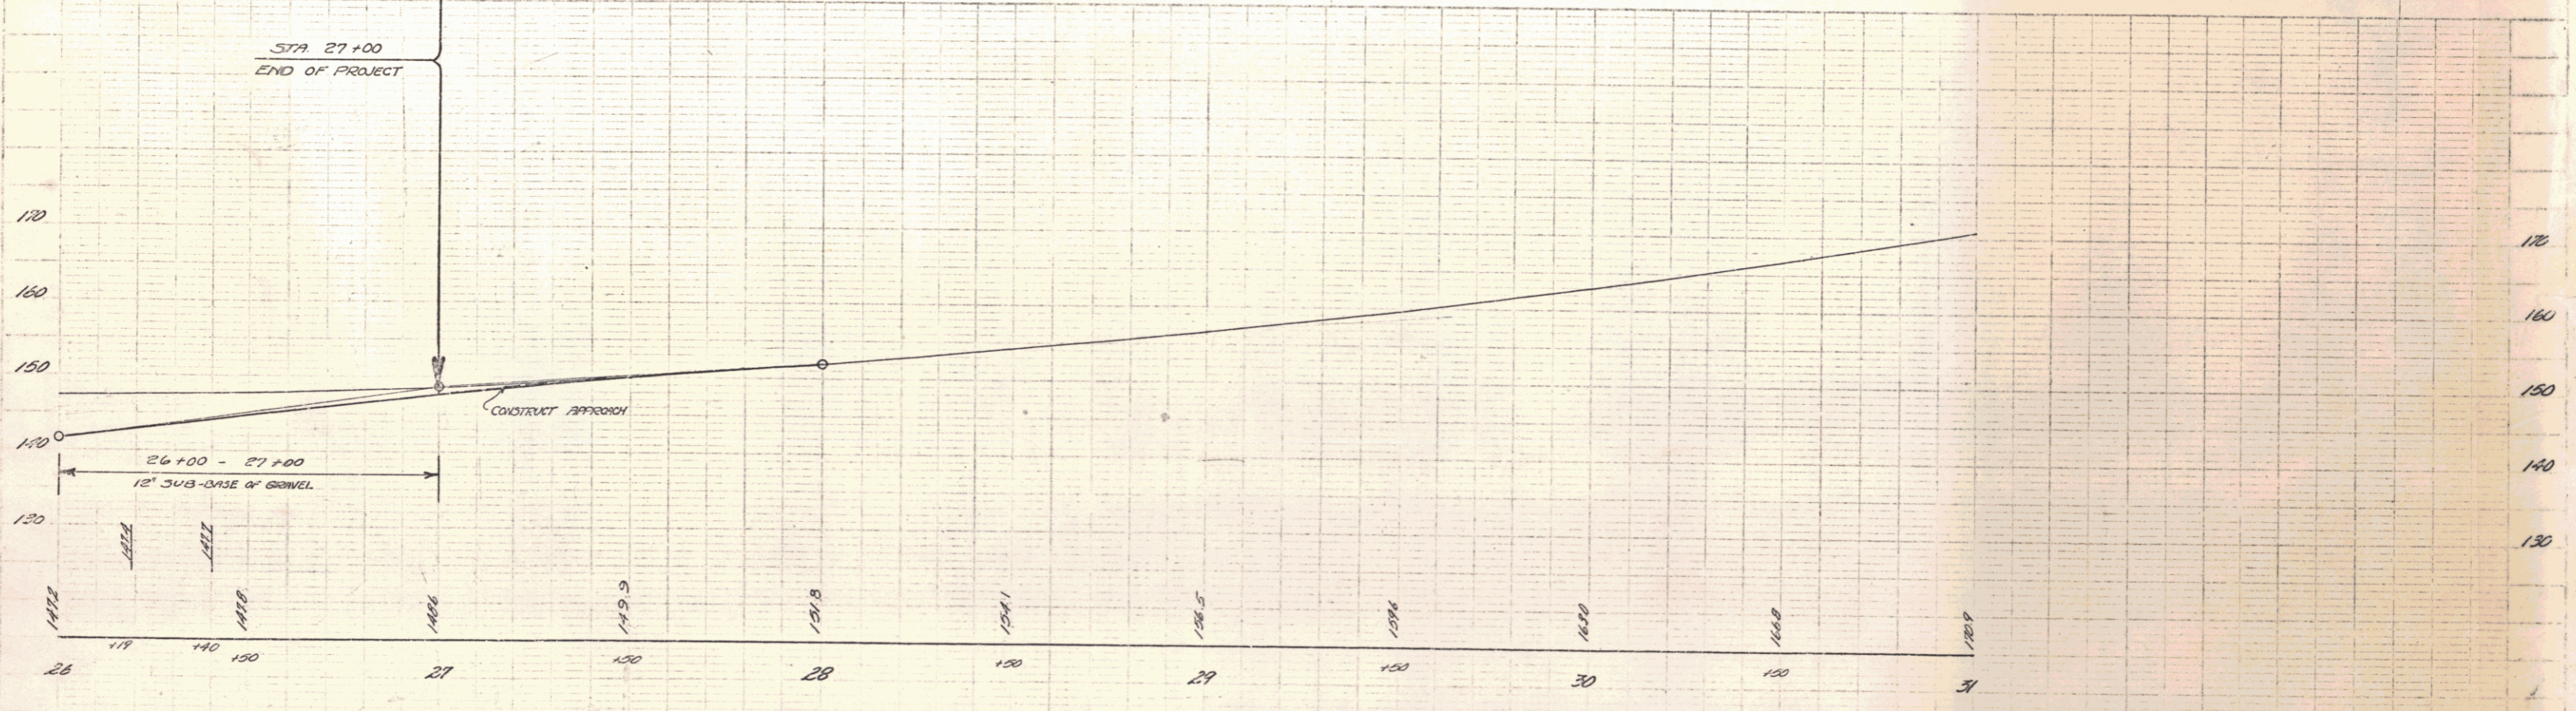

B.M. NPS, Elev. in Bed of 18' 00" 36' 12" 1/2" 36" 23" Elev. 149.32