INDEX

Sheets 16A + 16B refer to alternate line.

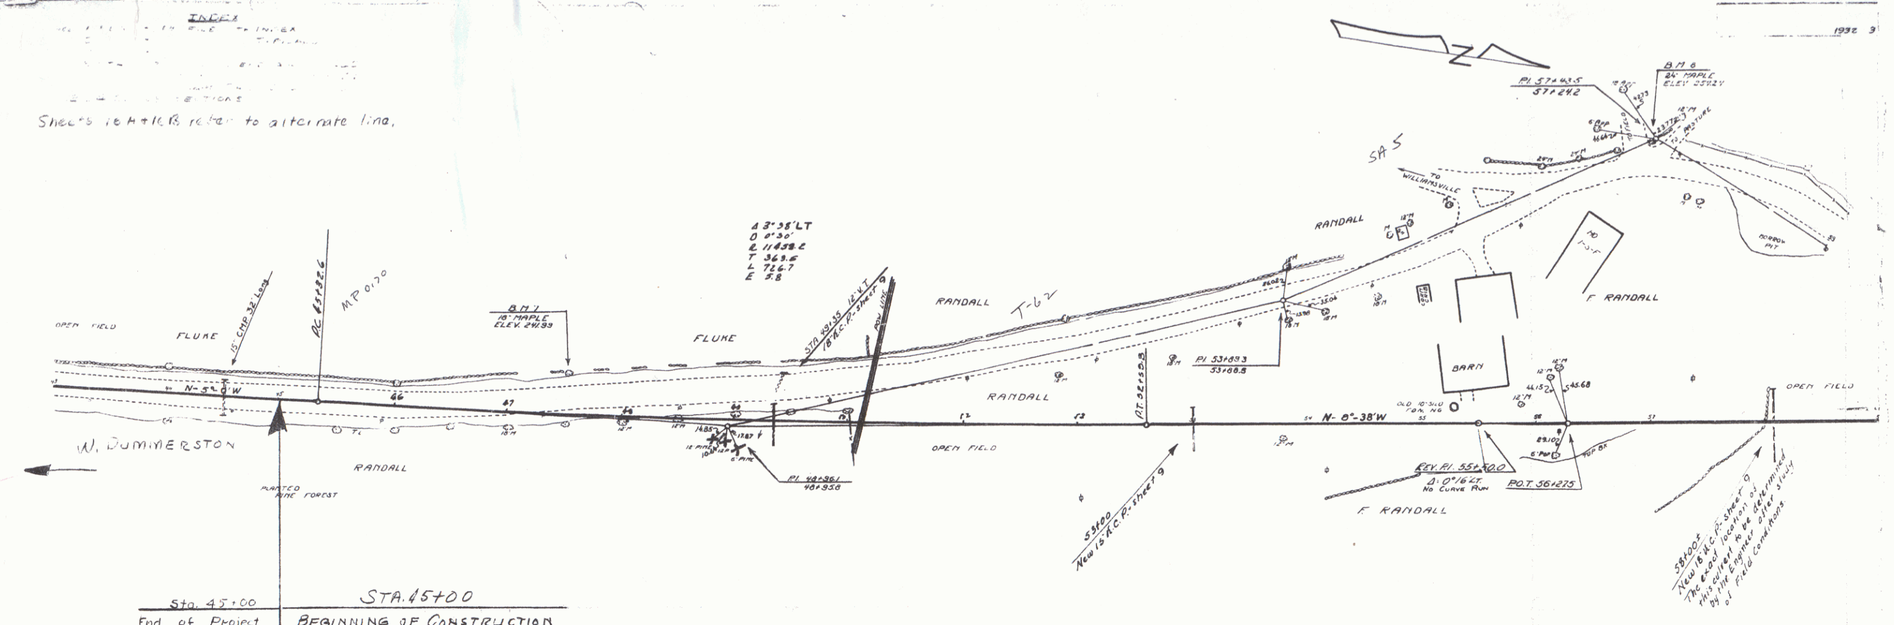


Sta. 45+00
End of Project

STA. 45+00
BEGINNING OF CONSTRUCTION

STA. 45+00 - 49+00
SHAPING COURSE OF GRAVEL

STA. 49+00 - 59+00
12" SUB-BASE OF GRAVEL
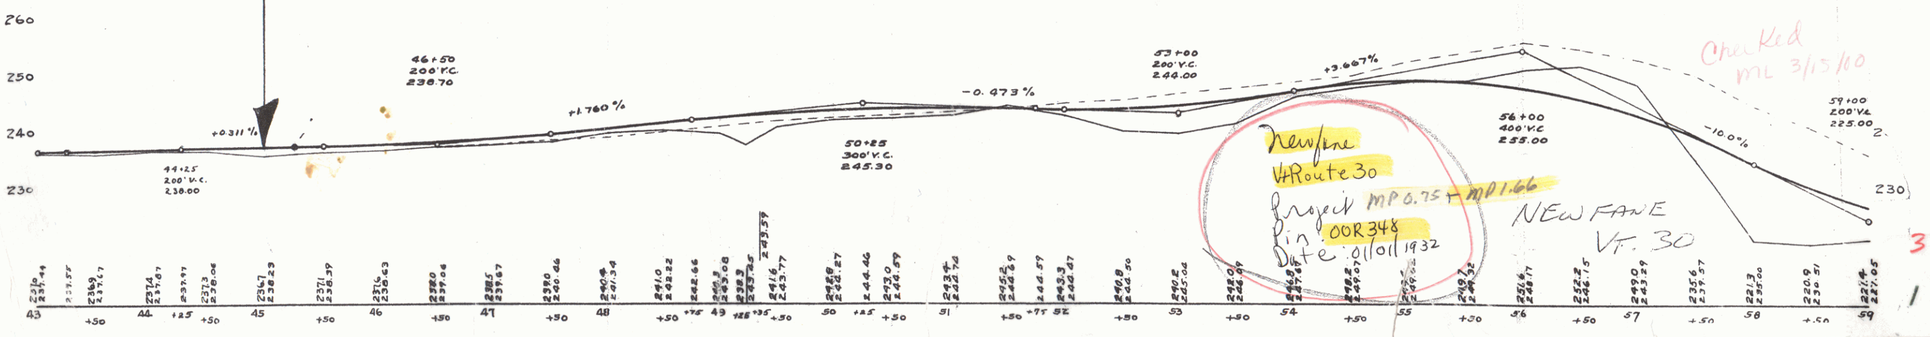
MP 0.75 - MP 1.66