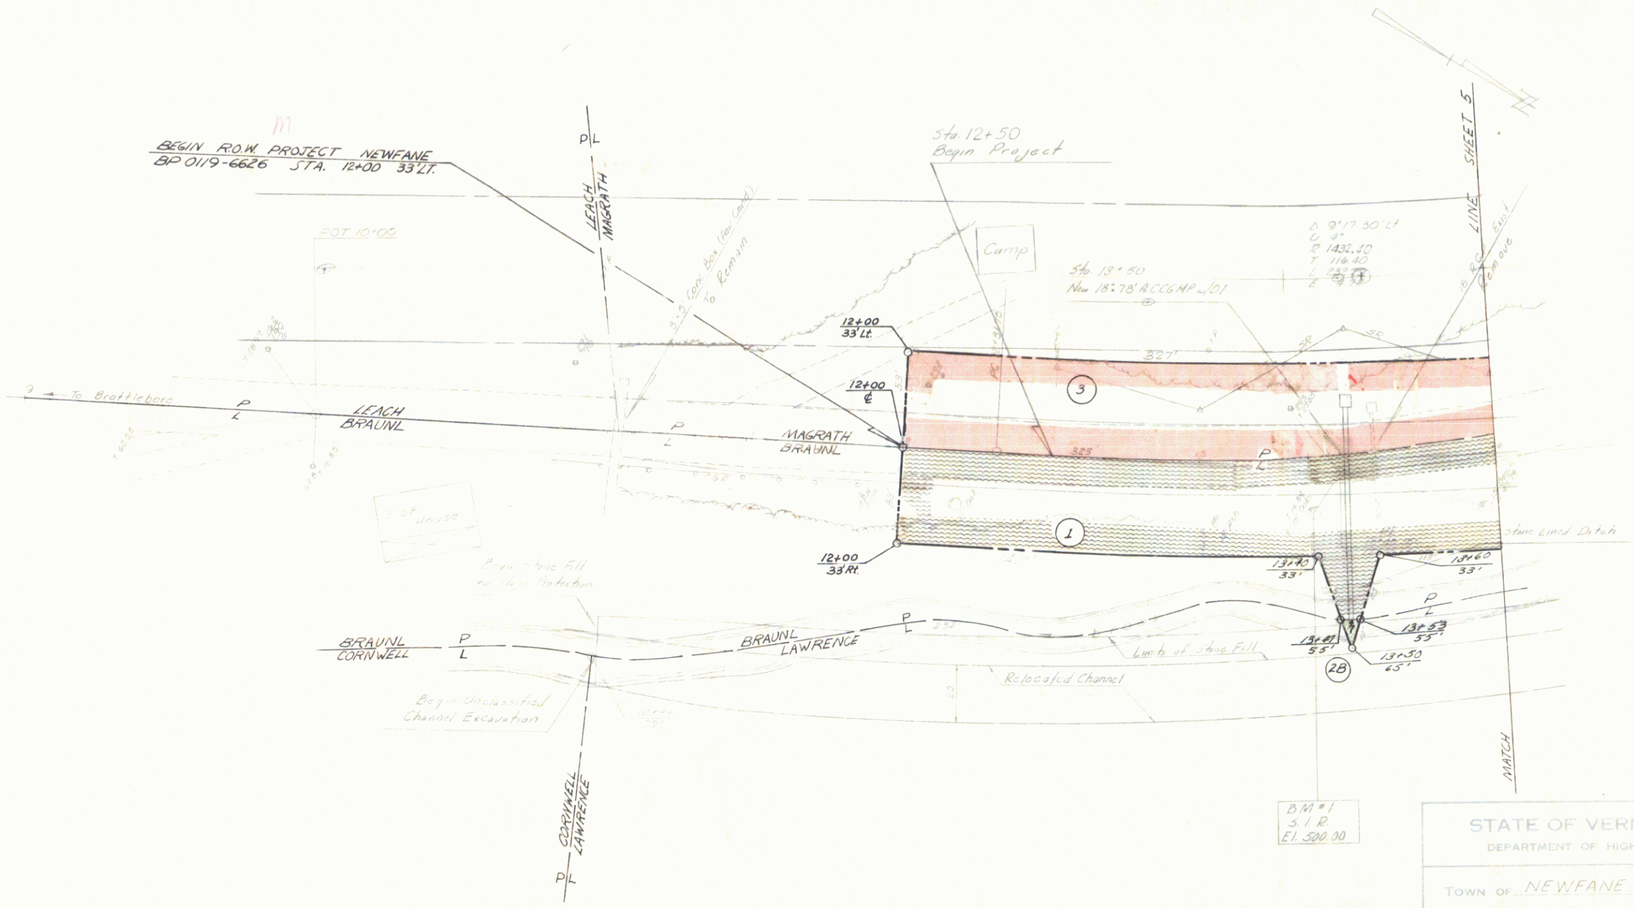

STATE OF VERMONT
DEPARTMENT OF HIGHWAYS

TOWN OF NEWFANE
ROUTE NO. VT 30 LOG STA.
VT. RTE 30 OVER BROOK
PLAN
SCALE 1" = 20'
SURVEYED BY Smith
DRAWN BY B. Boyd CHECKED BY N. DUBA 2-07
PROJECT NO. BP 0119-6626
SHEET 4 OF 14