PARCEL	INSTRUMENT	DATE	GRANTOR	GRANTEE	RECORDED IN NEWFANE BOOK	PAGE	DATE	REMARKS
5 A	W.D. Q.E.	12-21-61	KENNETH E. & MILDRED M. RELYEA	ST OF VT	2 MIL	62-63	1-15-62	
6 A'	CORP. Q.C.E.	1-14-62	EASTERN LUMBER COMPANY	ST OF VT	2 MIL	64-65	1-16-62	

State	Fiscal Year	Sheet No.	Total Sheets
39-M		5	27

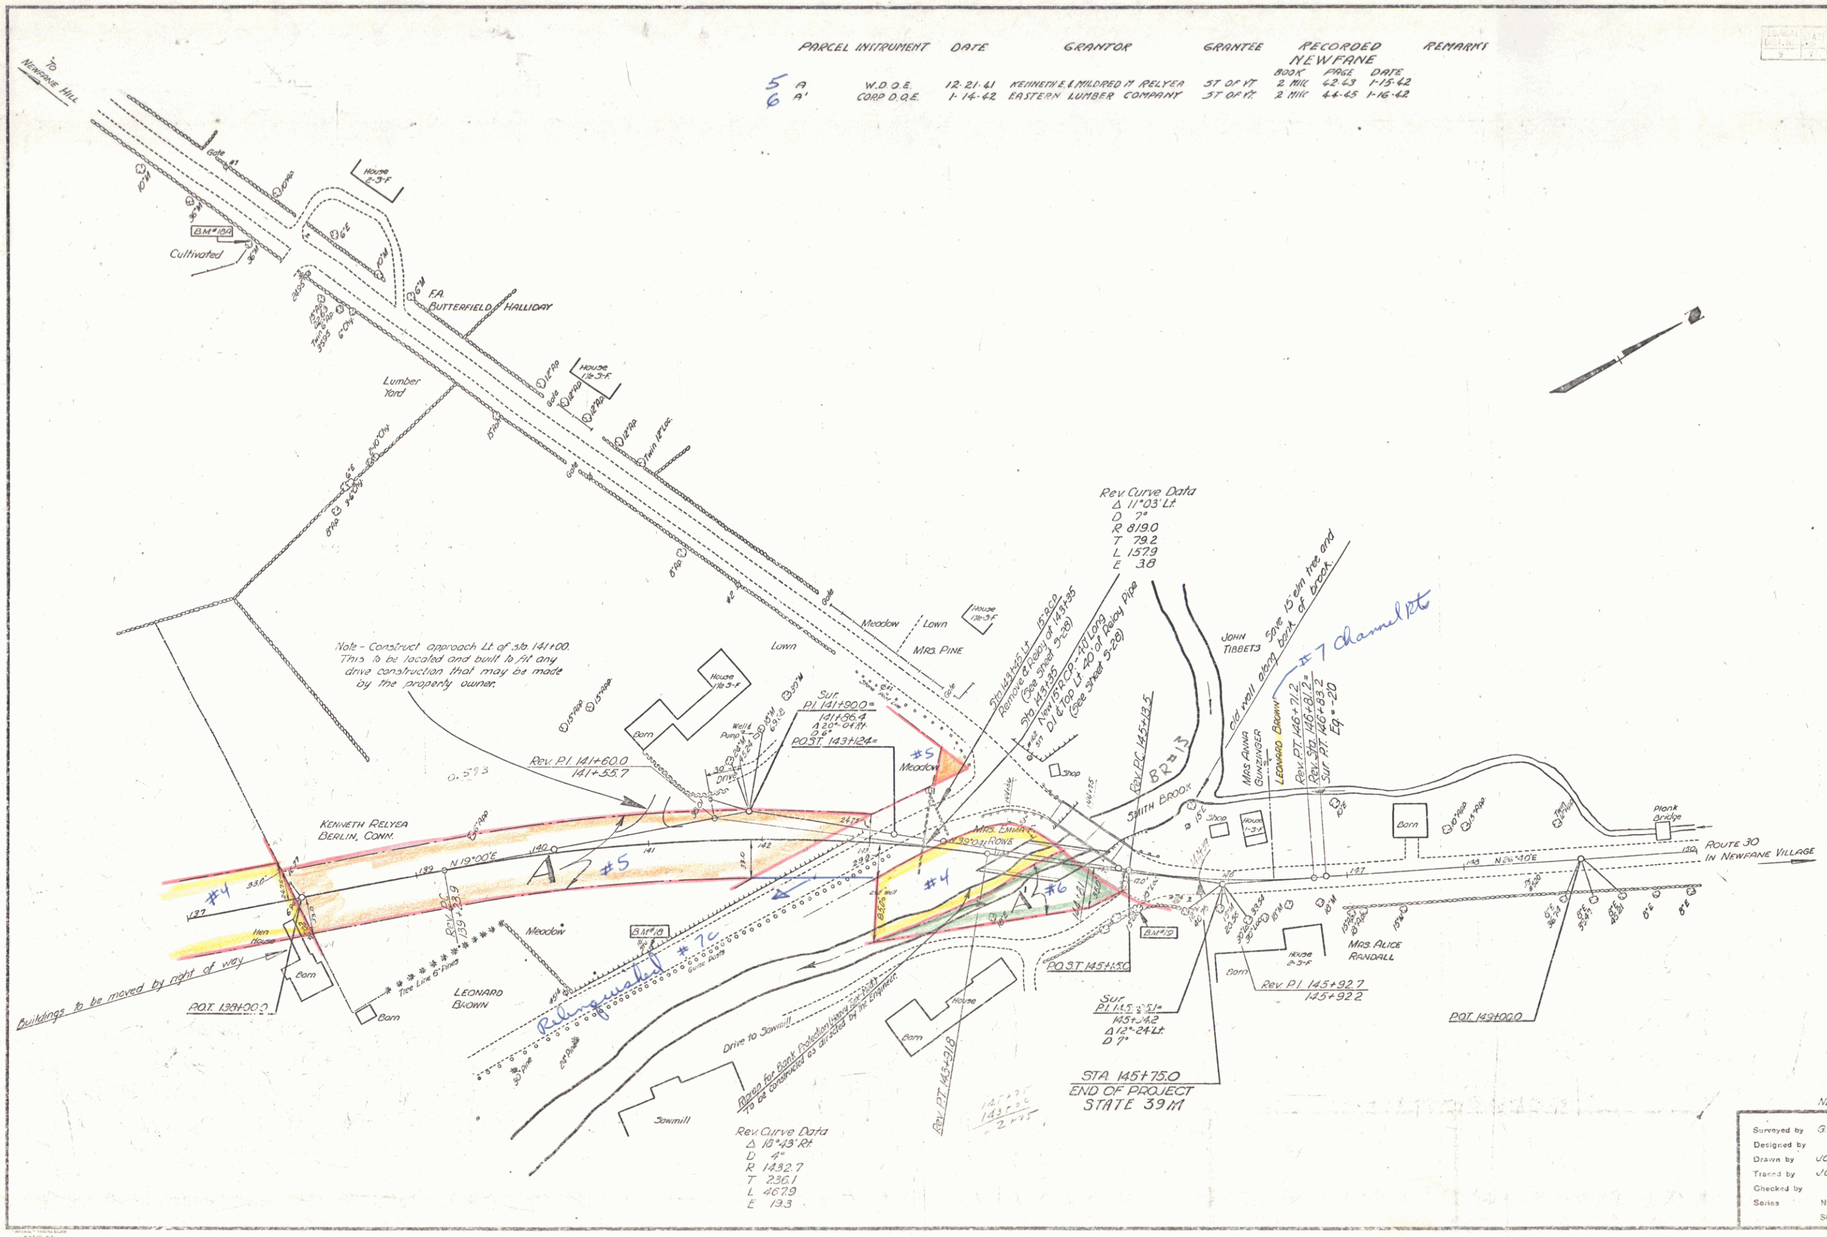

NEWFANE

Surveyed by G. LANE
Designed by
Drawn by J.O.C.
Traced by J.O.C.
Checked by
Series No. Files
Sheet 5 of 27 Sheets

4