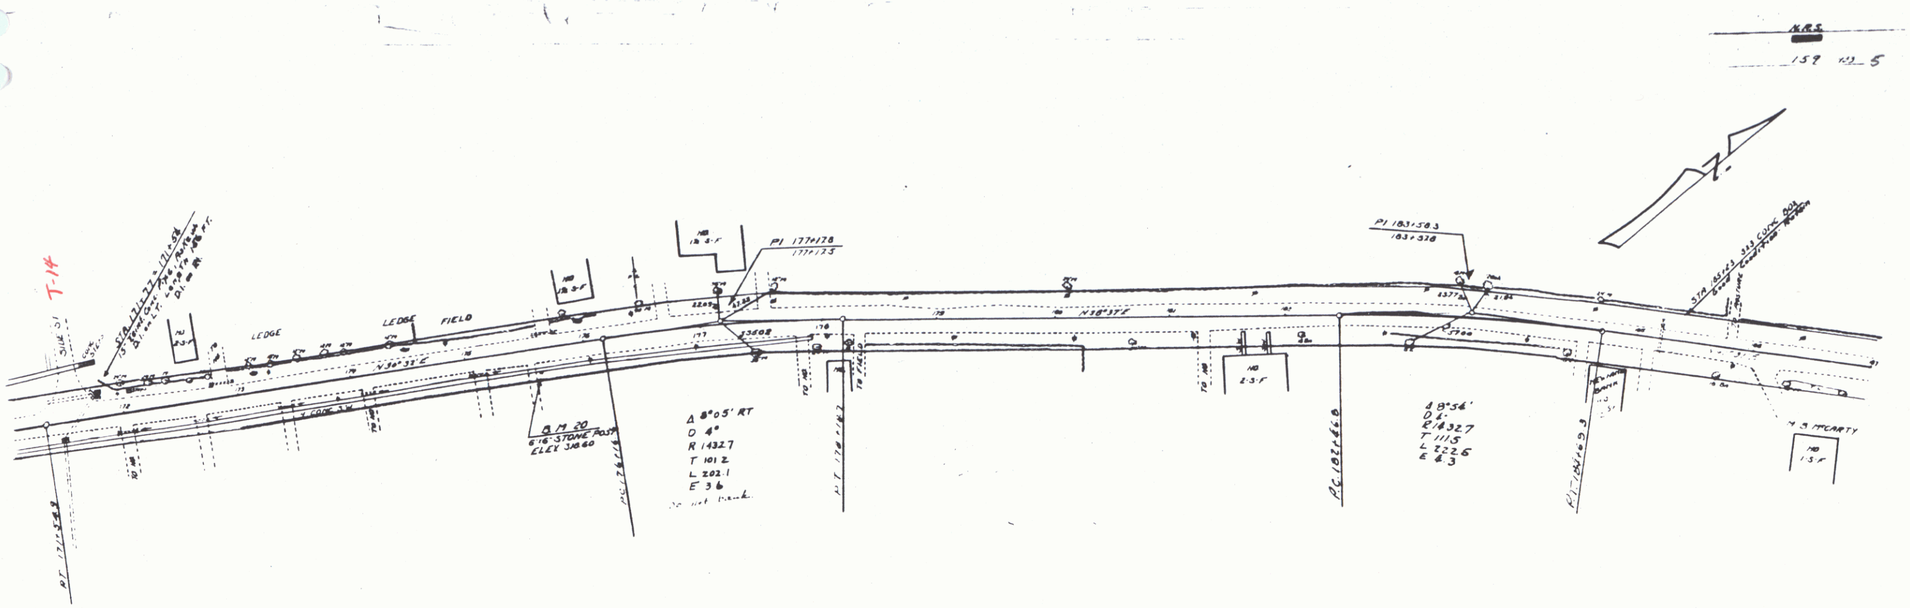
N.R.S.
159 KB 5
T-14
LEDGE
LEDGE FIELD
N 38°37'E
PI 177+178
177+175
PI 183+583
183+578
Δ 8°05' RT
D 4°
R 1432.7
T 101.2
L 202.1
E 3.6
Δ 8°56'
D 4°
R 1432.7
T 111.5
L 222.6
E 4.3
H. A. McCARTY

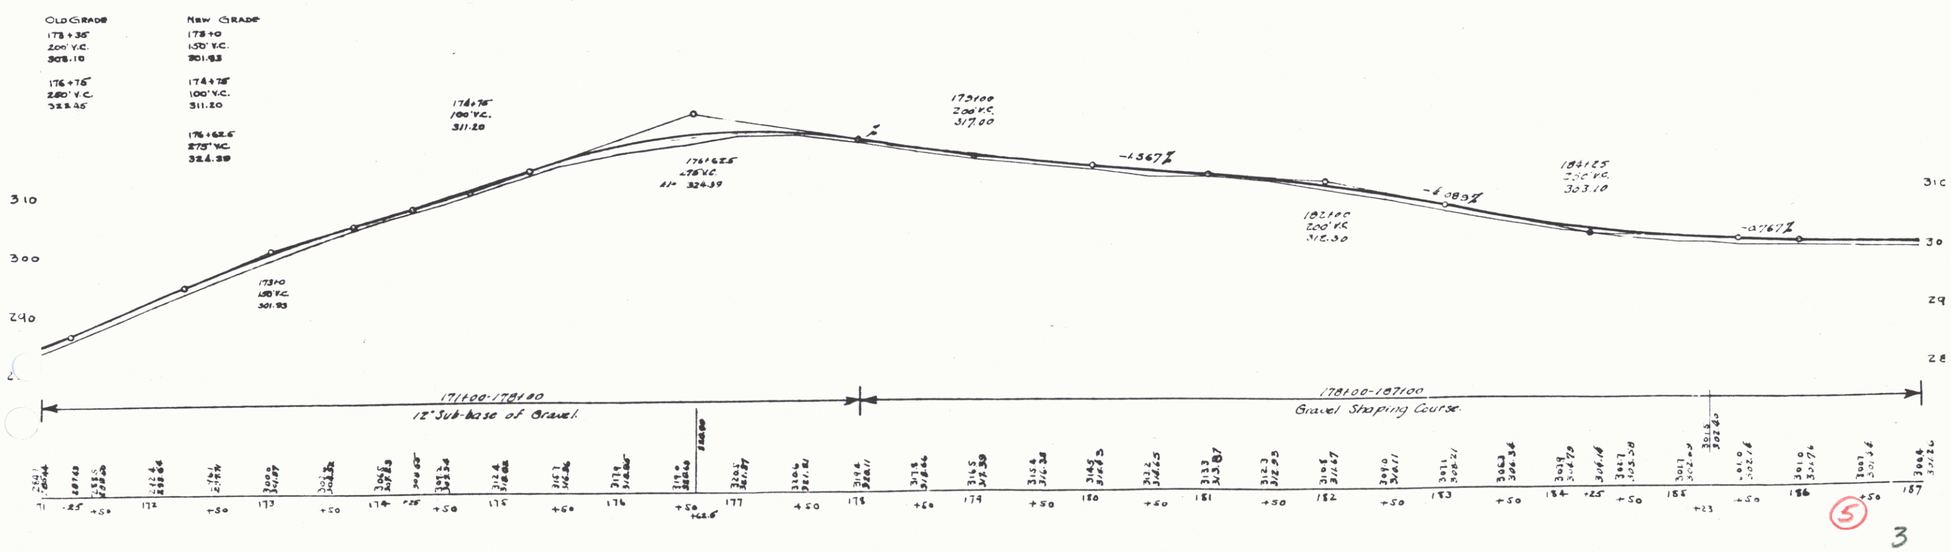
OLD GRADE
178+35
200' V.C.
303.10
176+75
250' V.C.
323.45
NEW GRADE
178+0
150' V.C.
301.93
174+75
100' V.C.
311.20
176+62.5
275' V.C.
324.39
176+75
100' V.C.
311.20
176+62.5
275' V.C.
324.39
173+00
200' V.C.
317.00
-1.367%
-6.083%
-0.767%
182+00
200' V.C.
312.30
184+25
200' V.C.
303.10
173+0
150' V.C.
301.93
310
300
290
31
30
29
28
171+00-178+00
12" Sub-base of Gravel
178+00-187+00
Gravel Shaping Course
5
3