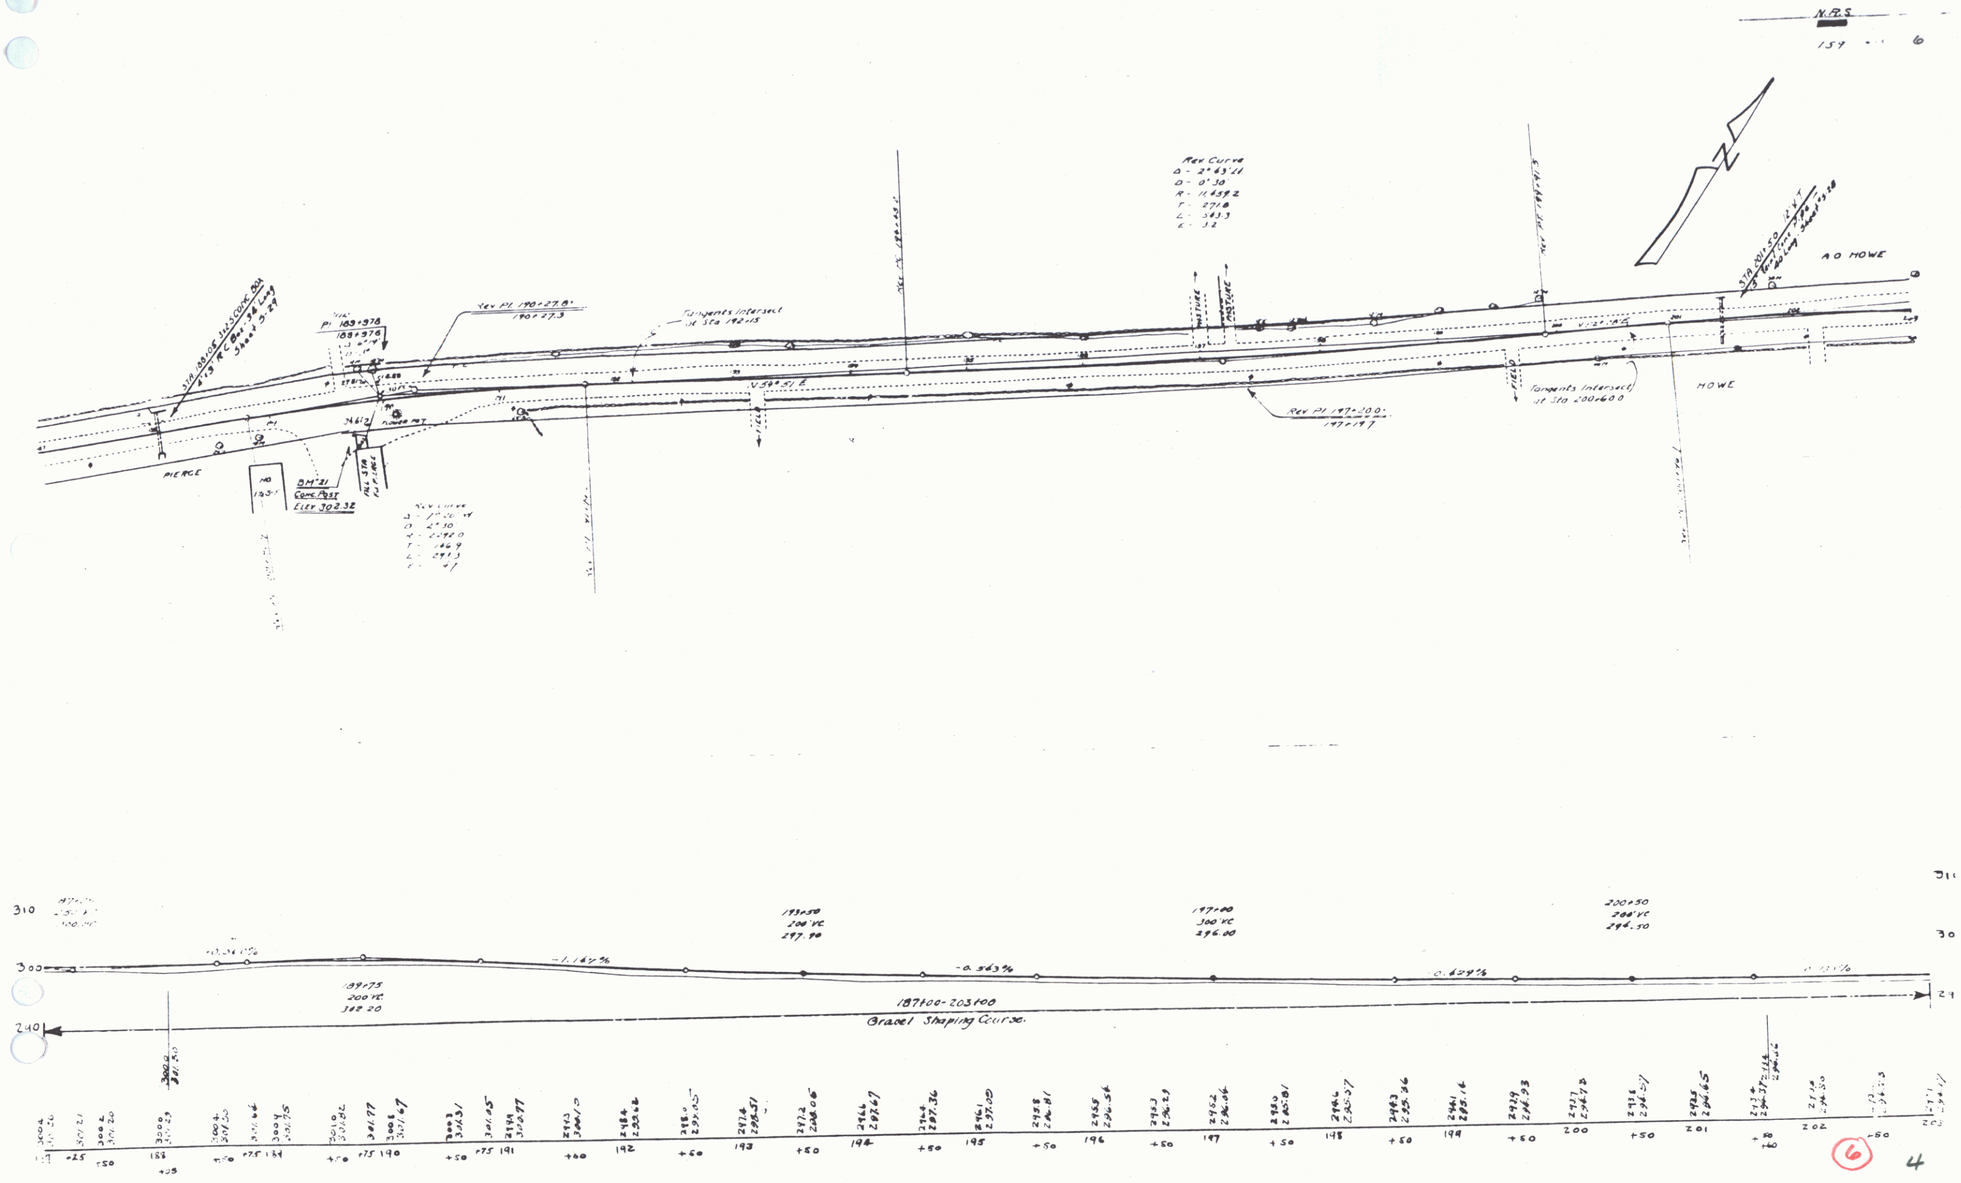
N.P.S.
154 - 6
Rev Curve
Δ - 27°43'21"
D - 0°30
R - 11459.2
T - 271.8
L - 543.3
E - 3.2
Rev PI 190+27.8
190+27.3
Tangents Intersect at Sta 192+15
Rev PI 197+200
197+197
Tangents Intersect at Sta 200+600
A.O. HOWE
HOWE
PIERCE
BM 21
Geod Post
Elev 302.32
PI 189+97.8
Rev Curve
Δ - 17°36'14"
D - 2°30
R - 2292.0
T - 346.9
L - 691.3
E - 4.7
187+00
200' VC
297.90
197+00
300' VC
296.00
200+50
200' VC
294.50
-1.167%
-0.563%
-0.429%
187+00-203+00
Gravel Shaping Course.
310
300
290
6
4